



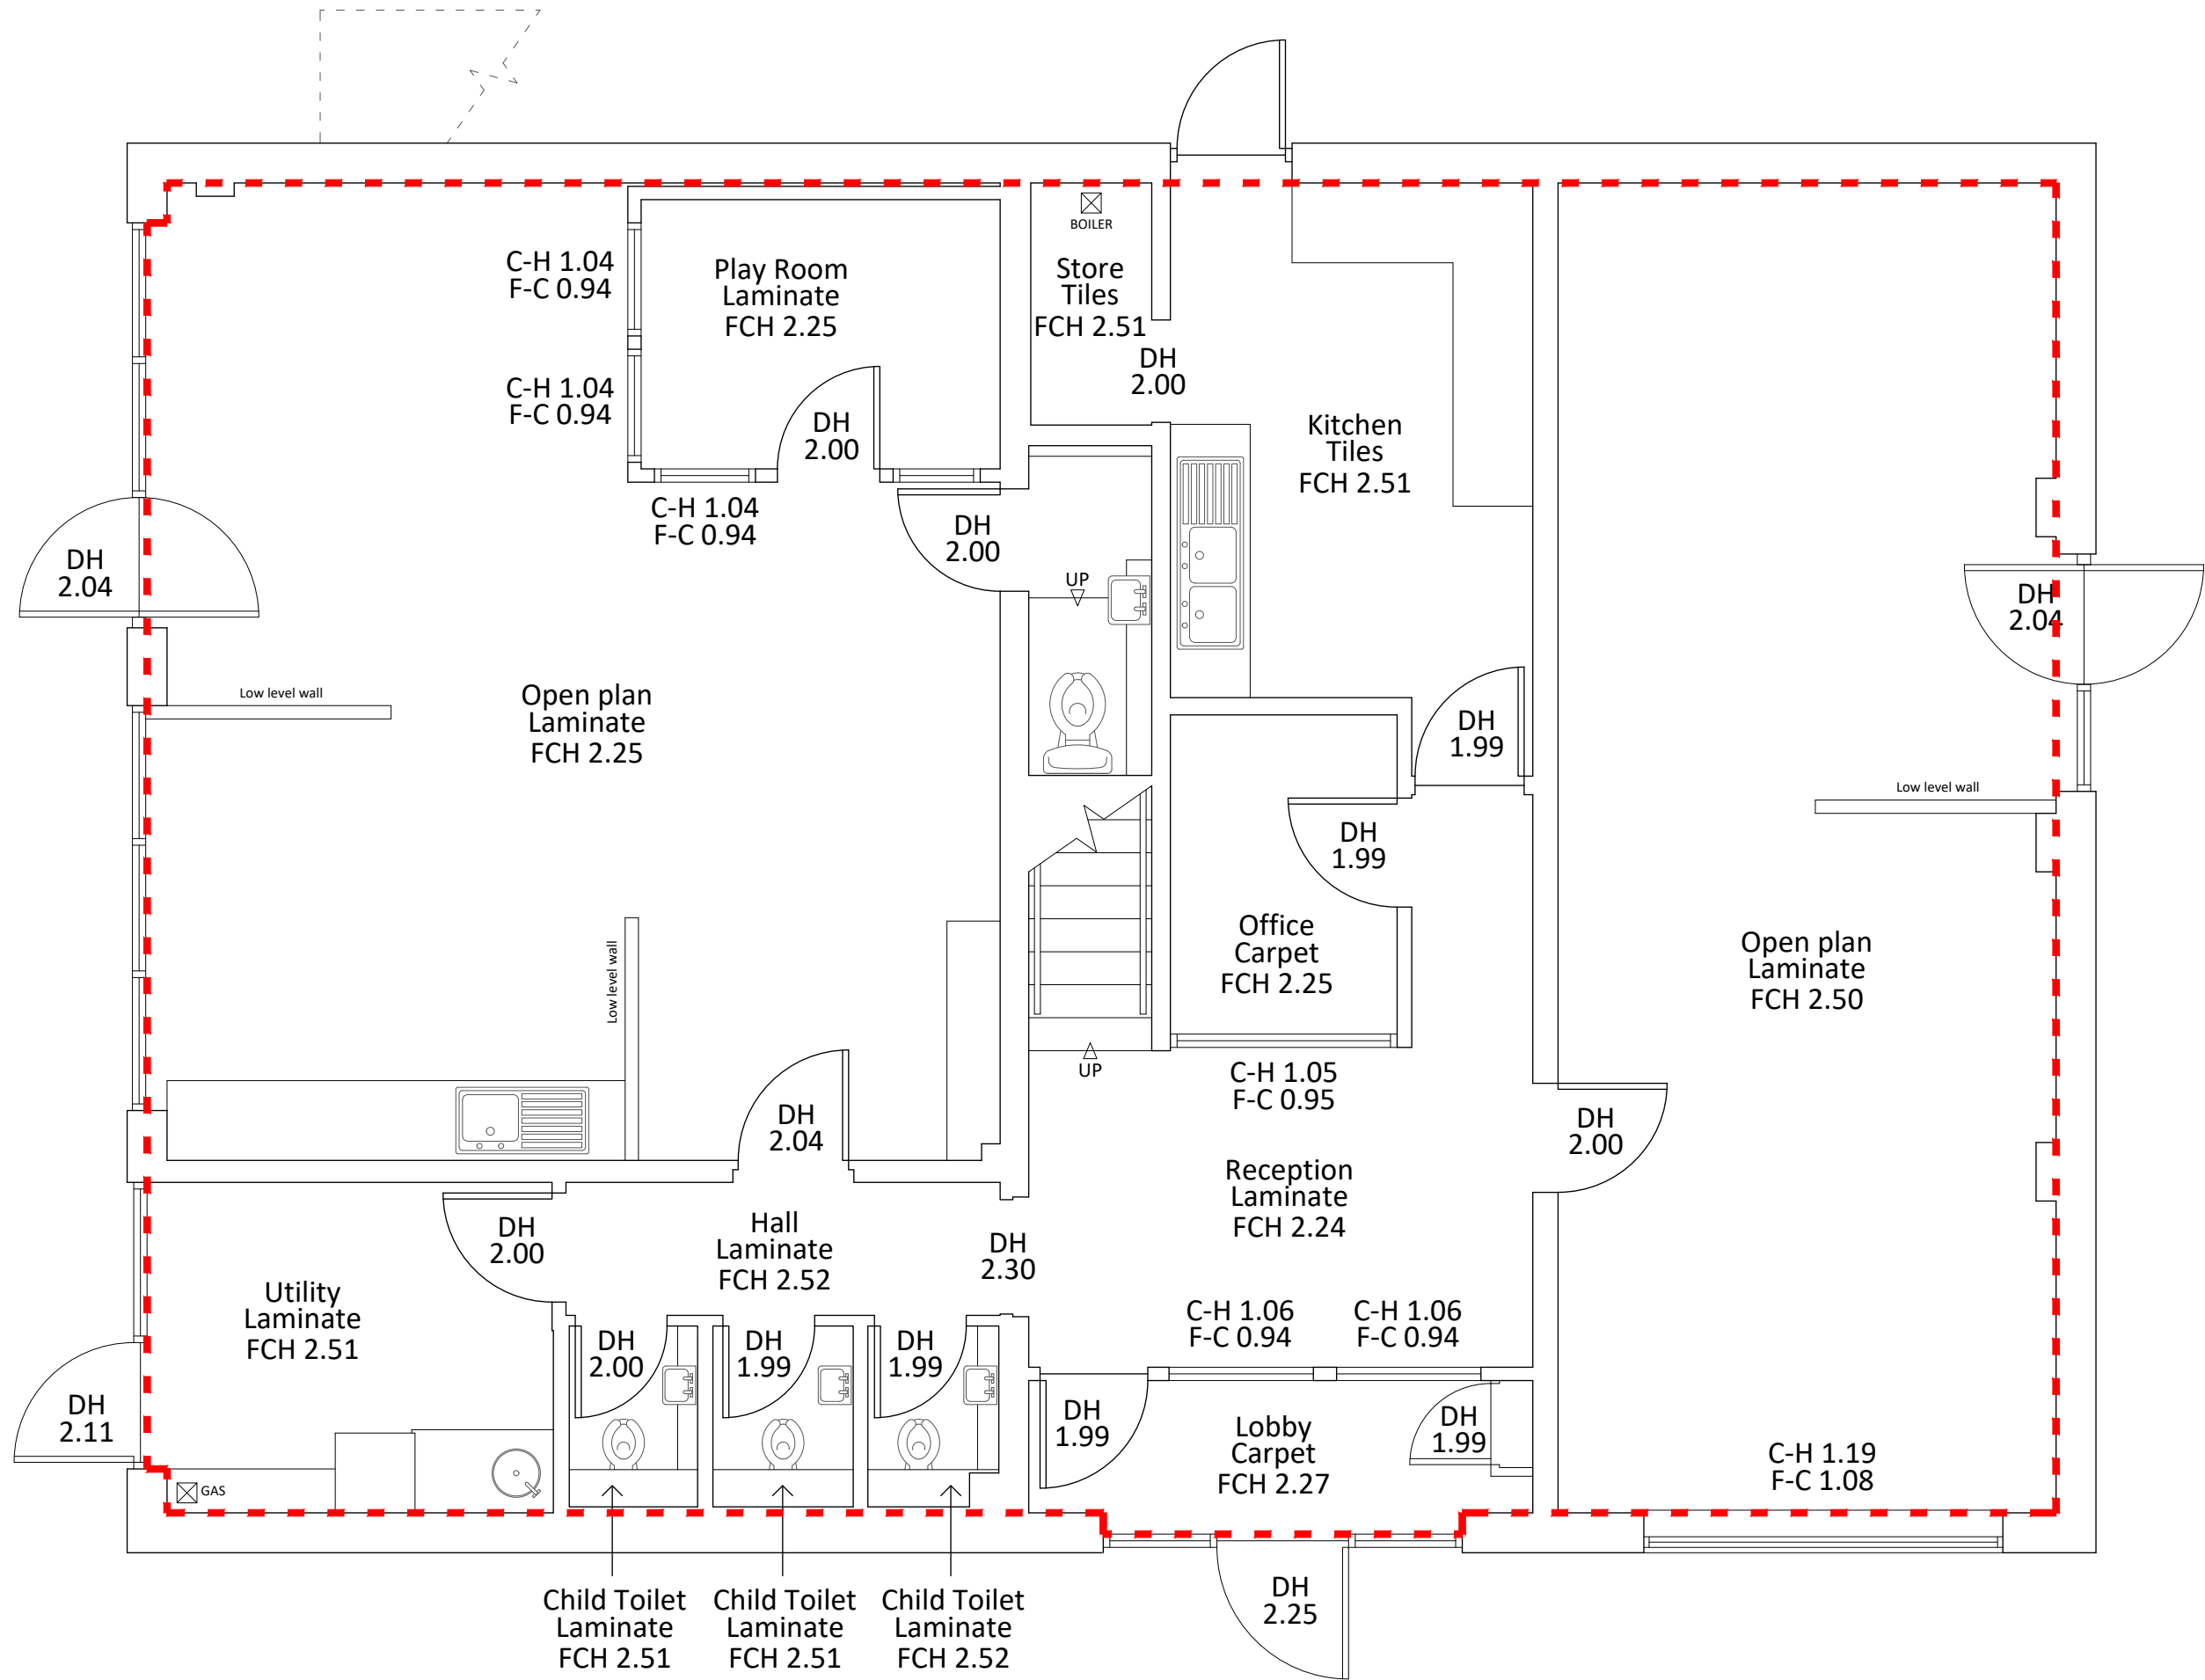


GROUND

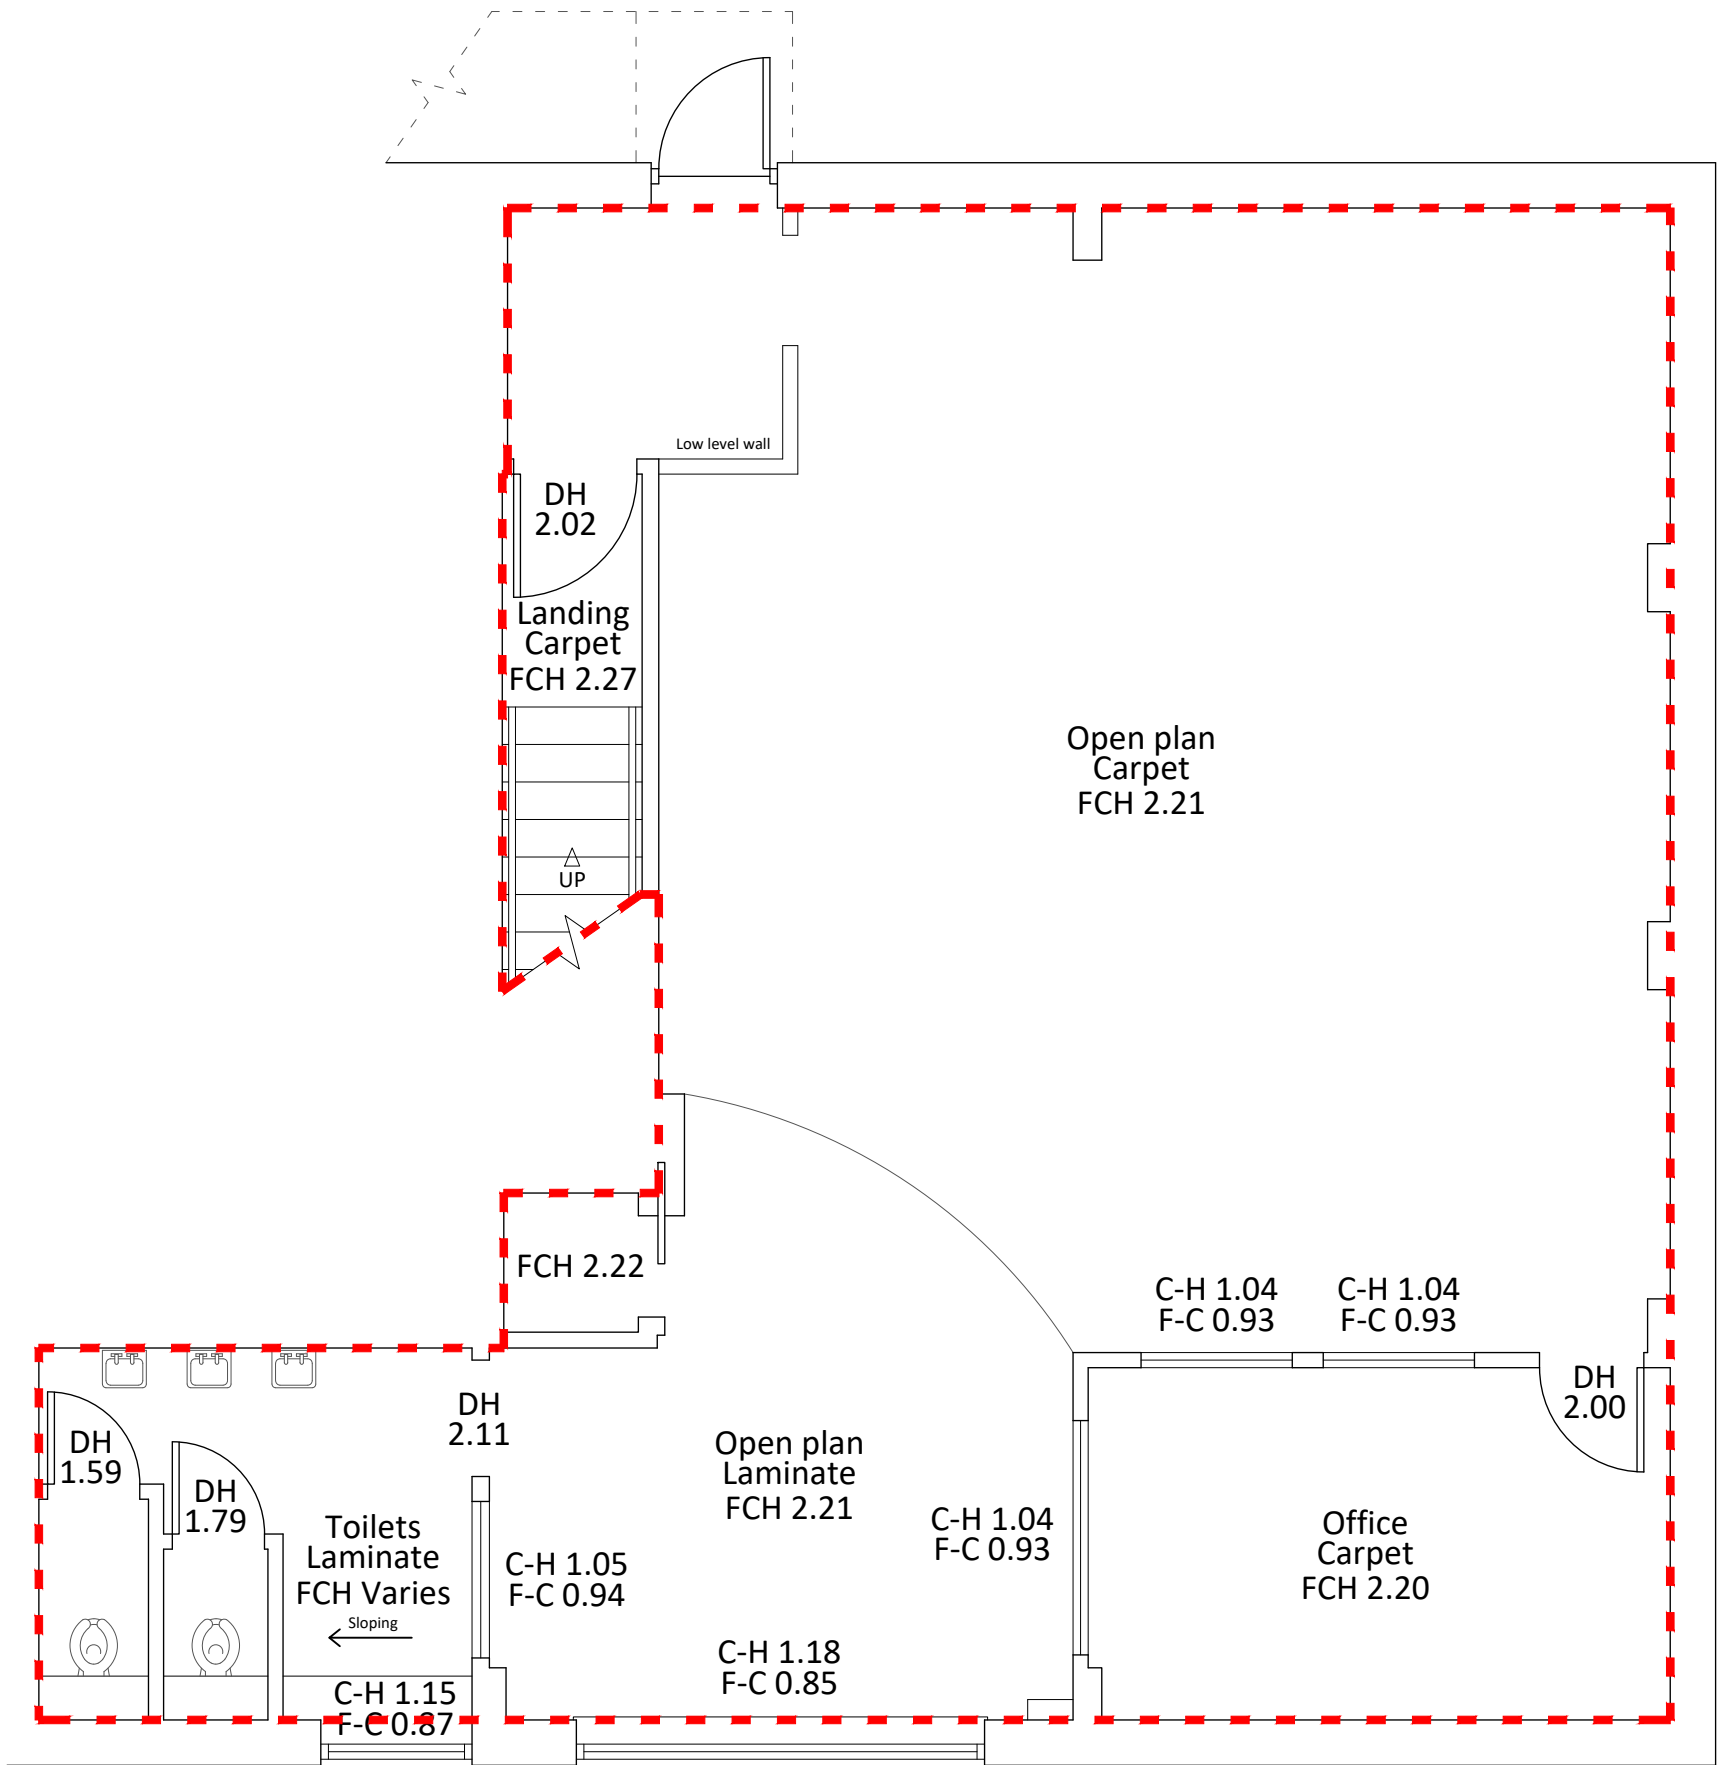

FIRST

EXISTING FLOOR PLANS

D16 MAIN AVENUE, TREFOREST INDUSTRIAL ESTATE, RCT, CF37 5UR

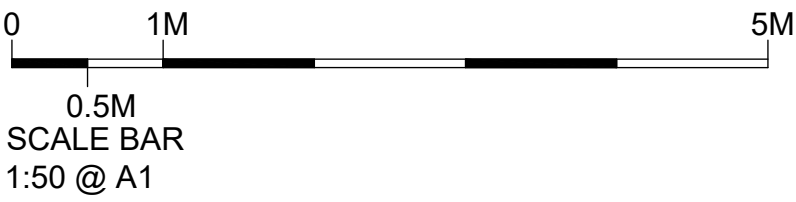

DRAFT1

UNIT D16 - IPMS2

FLOOR	AREA sq.m.	AREA sq.ft.
GROUND	143.88	1,548.72
FIRST	82.96	892.98
OVERALL TOTAL	226.84	2,441.71

UNIT D16 - IPMS3


FLOOR	USE	AREA sq.m.	AREA sq.ft.	INCLUDED AREAS (LIMITED USE) sq.m. sq.ft.		EXCLUDED AREAS sq.m. sq.ft.	
GROUND							
FIRST							
OVERALL TOTAL							

REV	DATE	DETAILS	BY
-----	------	---------	----

The contractor is to check all dimensions on site and inform the contract administrator/project manager of any discrepancies.

All work is to comply in every aspect with the Building Regulations, Codes of Practice and British Standards.

This drawing is to be read in conjunction with all other contract drawings and specifications.

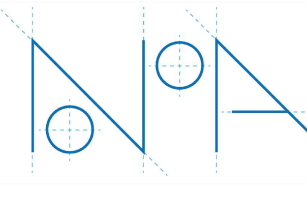

NOVO ARCHITECTURE LTD
10 Bradenham Place, Penarth, CF64 2AG
(T) +44 (0) 29 2065 0102
(M) 07734 437 301
(E) rob@novoararchitecture.co.uk

Registered Company Number: 0122467 VAT Number: 951 1783 96

CLIENT MILEWAY			
PROJECT D16 MAIN AVENUE, TREFOREST INDUSTRIAL ESTATE, RCT, CF37 5UR			
DRAWING EXISTING FLOOR PLANS			
SCALE @ A1 1:50	DATE SEP 24	DRAWN RD	CHECKED JN
JOB NO. 1928	DRAWING NO. E01		