

FLOOR AREA (FA)
532 m² / 5726 sq.ft

NET USABLE AREA (NIA)
476 m² / 5124 sq.ft
(excluding Lobby, Lifts, Staircases and WC's Areas)

CLIENT'S NAME
Salmon


OCCUPANCY

TOTAL HEADCOUNT 82 POSITIONS
WORKSTATIONS 74
HOT DESK POSITIONS 8

MEETING SPACES 22 POSITIONS
BOARDROOM (8P) 2
MEETING ROOM (4P) 1
MEETING ROOM (2P) 1

COLLABORATION/ BREAKOUT SPACES 31 POSITIONS
HIGH PERCH TABLES (6P) 2
BOOTH (4P) 2
PHONE CHAIRS 2
HIGH PERCH SINGLE SEAT 3
PRIVATE WORKING STATION 4
BUILT IN BOOTH (2P) 1

ANCILLARY AREAS
DRINKS STATION 1
PRINT HUB (1 PRINTER/ HUB) 1

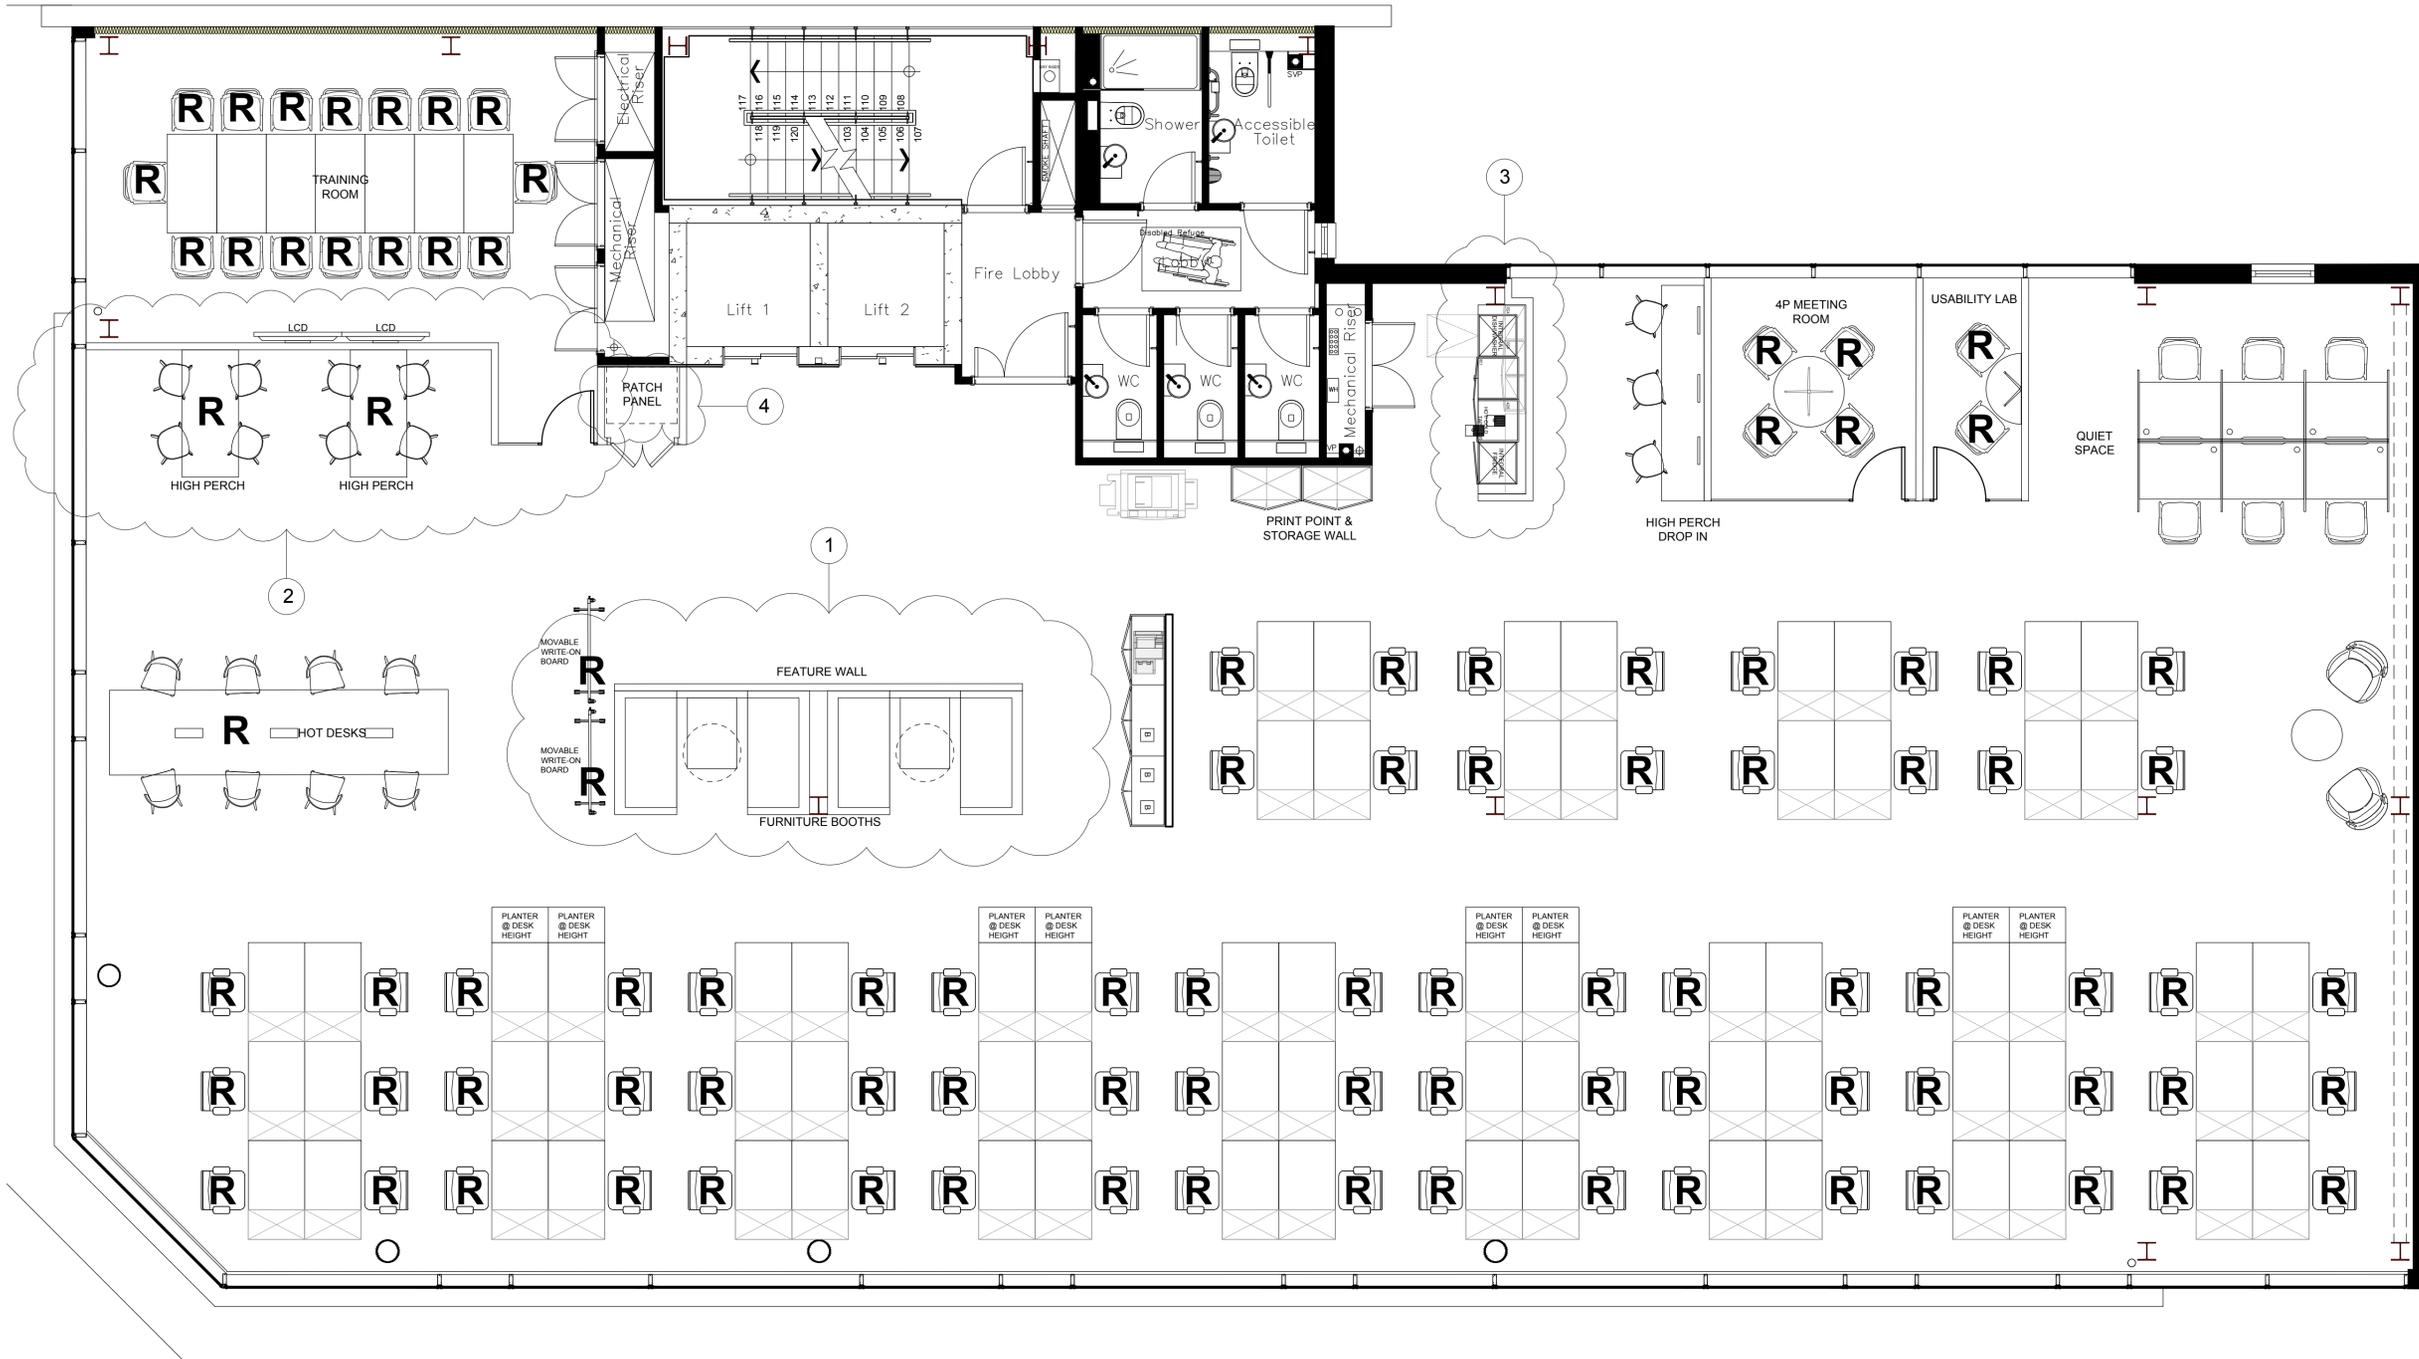

LEGEND:

R FURNITURE BEING RELOCATED FROM THE PREVIOUS OFFICES

B BASE UNIT TO CONTAIN INTEGRATED RECYCLING BIN

REVISIONS:

- 1 DIMENSIONS OF FURNITURE BOOTHS HAS INCREASED
- 2 CONFIGURATION HAS CHANGED TO ALLOW FOR ADDITIONAL SPACE IN THE TRAINING ROOM AND A LOCATION FOR THE PATCH PANEL
- 3 CHECK DIMENSIONS TAKEN ON SITE VISIT ON 05/01/18. TEAPPOINT WALL TO BECOME DOG-LEGGED TO ALLOW 1500mm WALKING SPACE
- 4 1000mm x 800mm PATCH PANEL SHOWN WITHIN CUPBOARD FOR REFERENCE

NOTES:
ALL SCREEN/ AV LOCATIONS ARE INDICATIVE. REFER TO AV CONTRACTORS DRAWINGS FOR EXACT LOCATION, DIMENSIONS AND PLACEMENT

Peldon Rose
Workplace thinkers & makers™

CLIENT
Salmon

LOCATION
36 Clarendon Road, London

FLOOR
Fifth

DRAWING NAME
General arrangement plan

DRAWING NUMBER: EN2147-05-01
DATE: 15.01.2018
SCALE: 1:50 @ A1
REVISION: P11

Peldon Rose Limited
Sterling House, 42 Worple Road
London SW19 4EQ
Telephone: 020 8971 7777
web: www.peldonrose.com

This drawing is protected under copyright and at no time should this drawing be reproduced in whole or in part without the permission of Peldon Rose Limited.
© COPYRIGHT