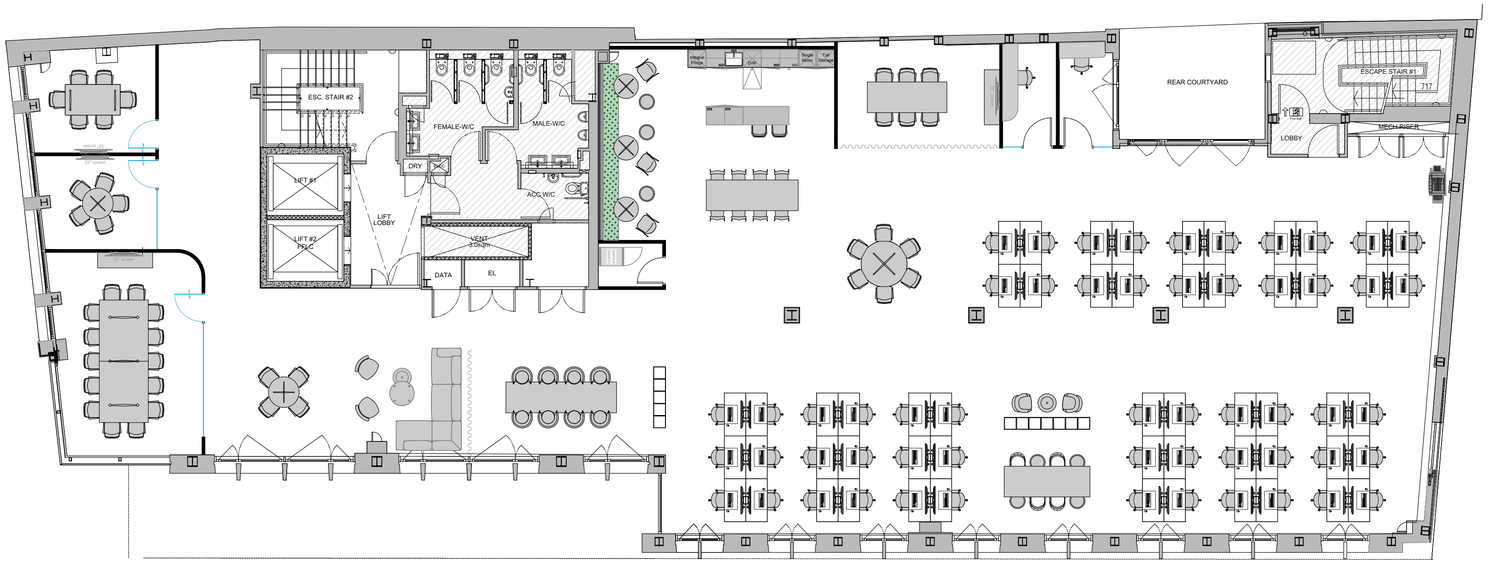

0 2 5 10m

SCALE 1:100

NOTE

This drawing is not to be scaled.

Appointed contractors are requested to notify Peldon Rose Limited of any discrepancies or variations relating to setting-out prior to manufacture and construction.

All information is subject to statutory approval and site survey.

The general contractor is to carry out a check site survey to confirm that the design intent can be met and that it is appropriate for the environment in which it is to be installed.

The general contractor is to notify Peldon Rose Limited in writing of all preparation works that are required to be carried out prior of their works.

This drawing is protected under copyright and at no time should this drawing be reproduced in whole or in part without the formal permission of Peldon Rose Limited.

© COPYRIGHT

REVISIONS

REV	DATE	DESCRIPTION	BY	CHK
RD	22/08/2025	ISSUED FOR RECORD	SD	TB

DRAWING STATUS

RECORD DRAWING

CLIENT

PROJECT

ADAM ASSET MANAGEMENT
22 CHANCERY LANE
WC2A 1LA

TITLE

THIRD FLOOR
GENERAL ARRANGEMENT
PLAN

Peldon Rose

Peldon Rose Limited
Sterling House, 42 Worple Road
London SW19 4EQ

Telephone: 020 8971 7777 **web: peldonrose.com**

DATE	SHEET	DRAWN BY
02/01/2025	A1	TB
SCALE		CHECKED BY
1:100 @A1		GK

DRAWING NUMBER

PROJECT NUMBER	FLOOR/TYPE	NUMBER	REVISION
L11360	— 03	— 01	RD