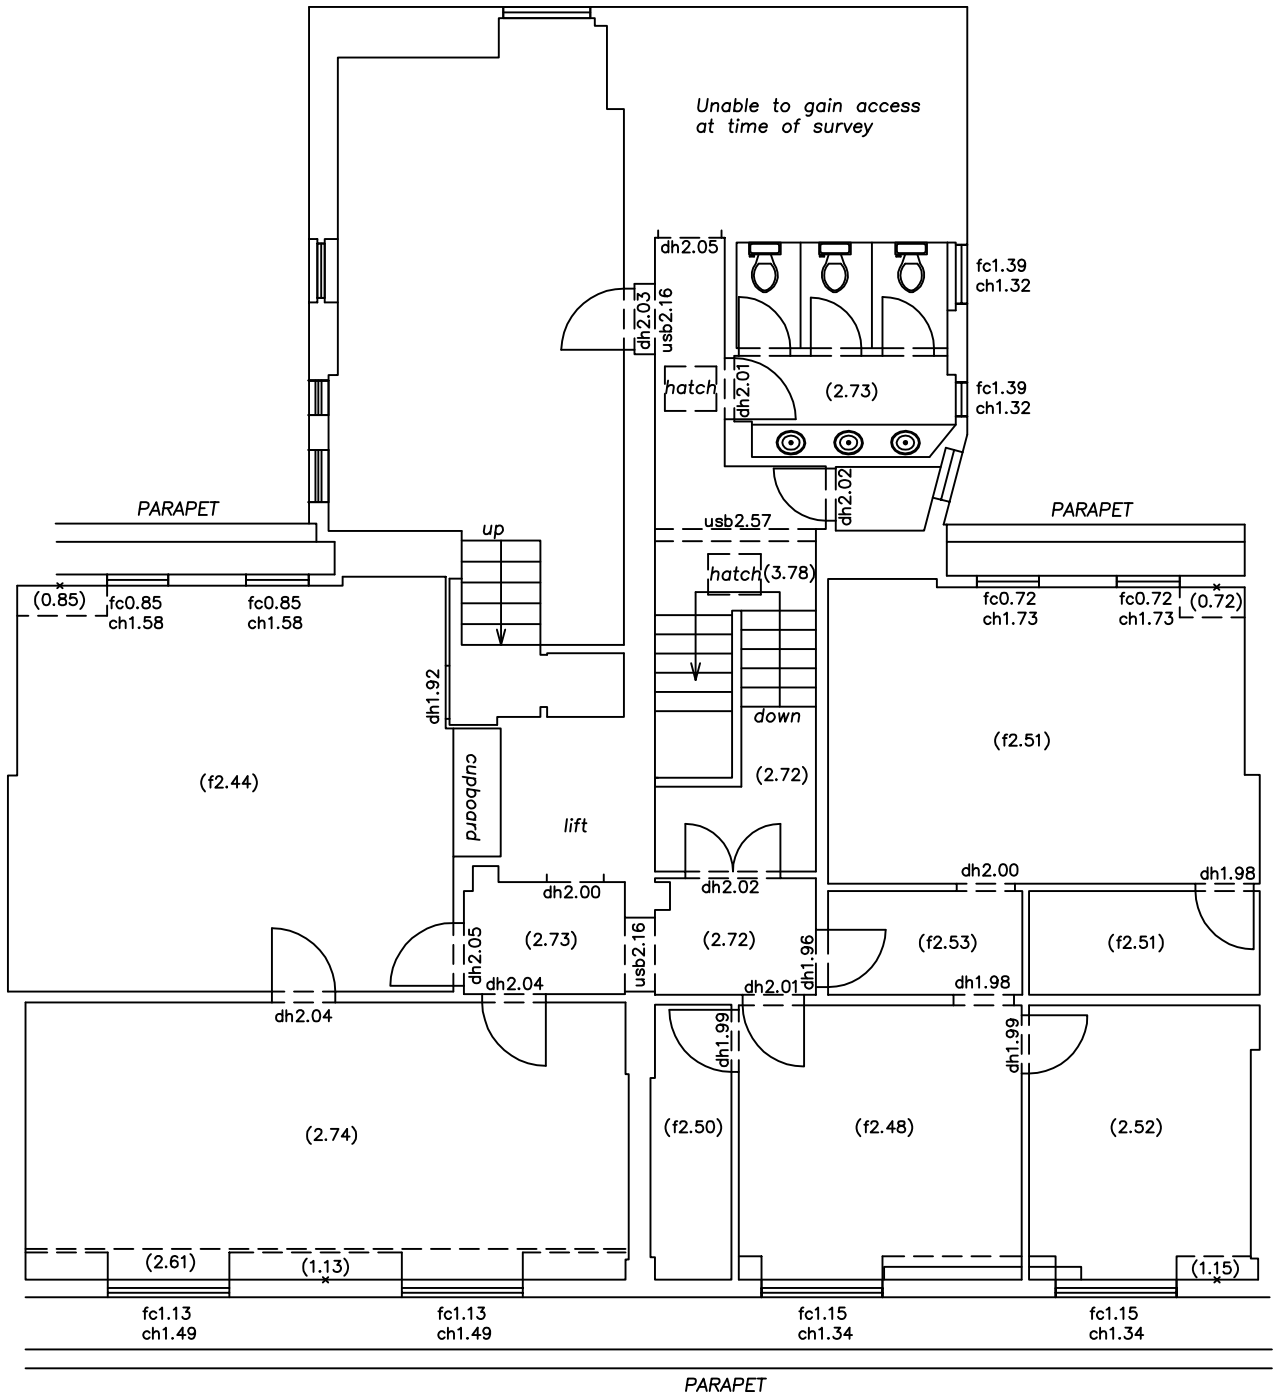

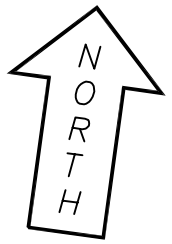

KEY

(n.nn)	CEILING HEIGHT
(Fn.nn)	FALSE CEILING HEIGHT
USB	UNDERSIDE OF BEAM
FC	FLOOR TO CILL HEIGHT
CH	CILL TO HEAD HEIGHT
DH	DOOR HEAD HEIGHT
x 9.99	FLOOR LEVEL
SPR	SPRINGER HEIGHT
CRO	CROWN HEIGHT

GRYPHON SURVEYS
Hanover House
78–82 High Street
Brentwood, Essex CM14 4AP
Telephone: 01277–212794
Fax: 01277–214928
e–mail: admin@gryphonsurveys.co.uk
www.gryphonsurveys.co.uk

Project:
17/18 MARGARET STREET
LONDON, W1

Title:
FOURTH FLOOR

Drawn
S.K

Checked

Scale
1/100@a3

Date
09/10

Ref:
17/18MS