


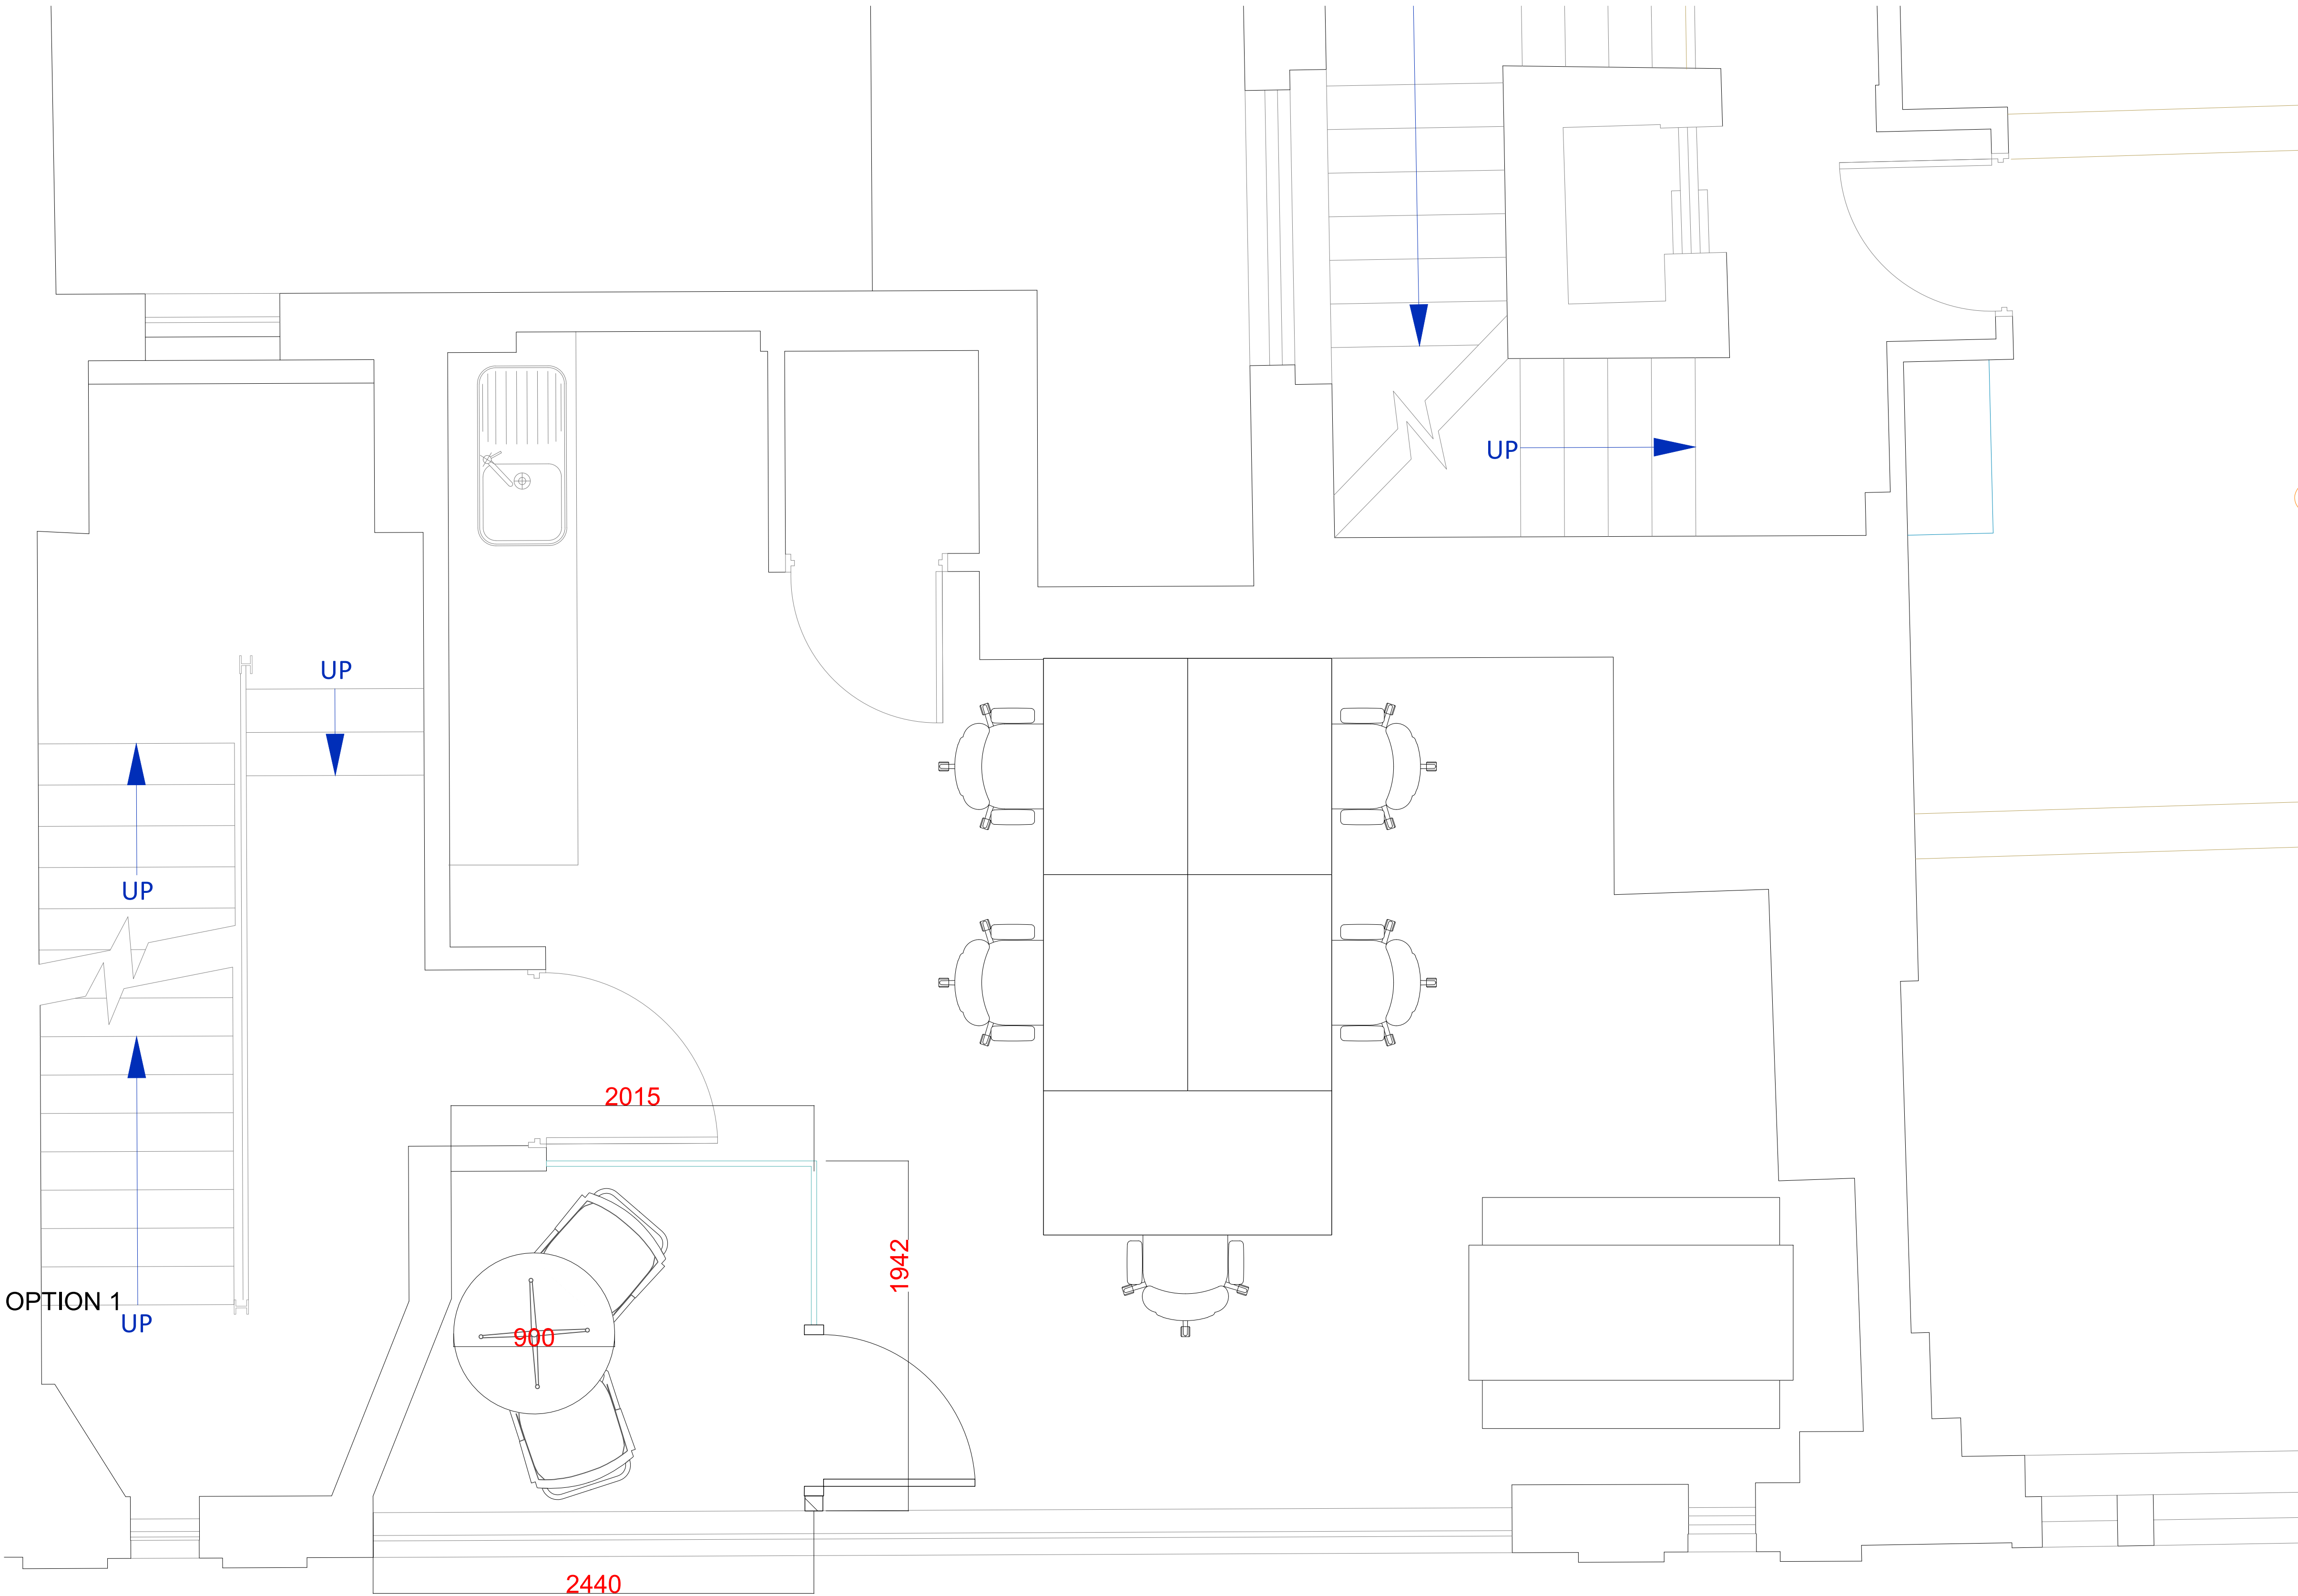

Drawing Notes:

This drawing may not be copied, reproduced or given to any third parties for any reason whatsoever without the written permission of Imperial Building Solutions Limited. Please note this drawing and design is protected under Copyright and remains the property of Imperial Building Solutions Limited at all times.

All dimensions must be checked on site and not scaled from this drawing. Drawings subject to full dimensional site survey.

Proposals are subject to approvals by statutory authorities.

© Copyright 2026 Imperial Building Solutions Limited.

Standard Instructions

A: All dimensions to be verified on site & any discrepancies on the drawings or divergence between drawings to be immediately reported to the Project Manager before putting the work concerned in hand, fabricating the work or preparing shop drawings. B: Work to figured dimensions only, (except where full size details are provided). C: Do not vary any work shown on the drawings without obtaining prior approval from the Project Manager or Designer. D: Any additional information required should be requested from the Project Manager or Designer before commencement of work on site.

A	CHANGE OF MEETING RM SIZE	12.06.26	SLJ	CK	
REV	COMMENTS	DATE	BY	CK	

Description:

General Arrangement

Client Name:

42-44 Great Titchfield Street

Date:	Project Address:
12.06.26	2nd Floor,
Scale:	42-44 Great Titchfield Street
1:20 @ A1	

Status:

☒ Preliminary ☐ Contract ☐ Construction

Dwg No:	Job No:	Floor:	Detail:	Revision:
001		2nd		A