


96 goldstone villas

Approximately 373 ft² total

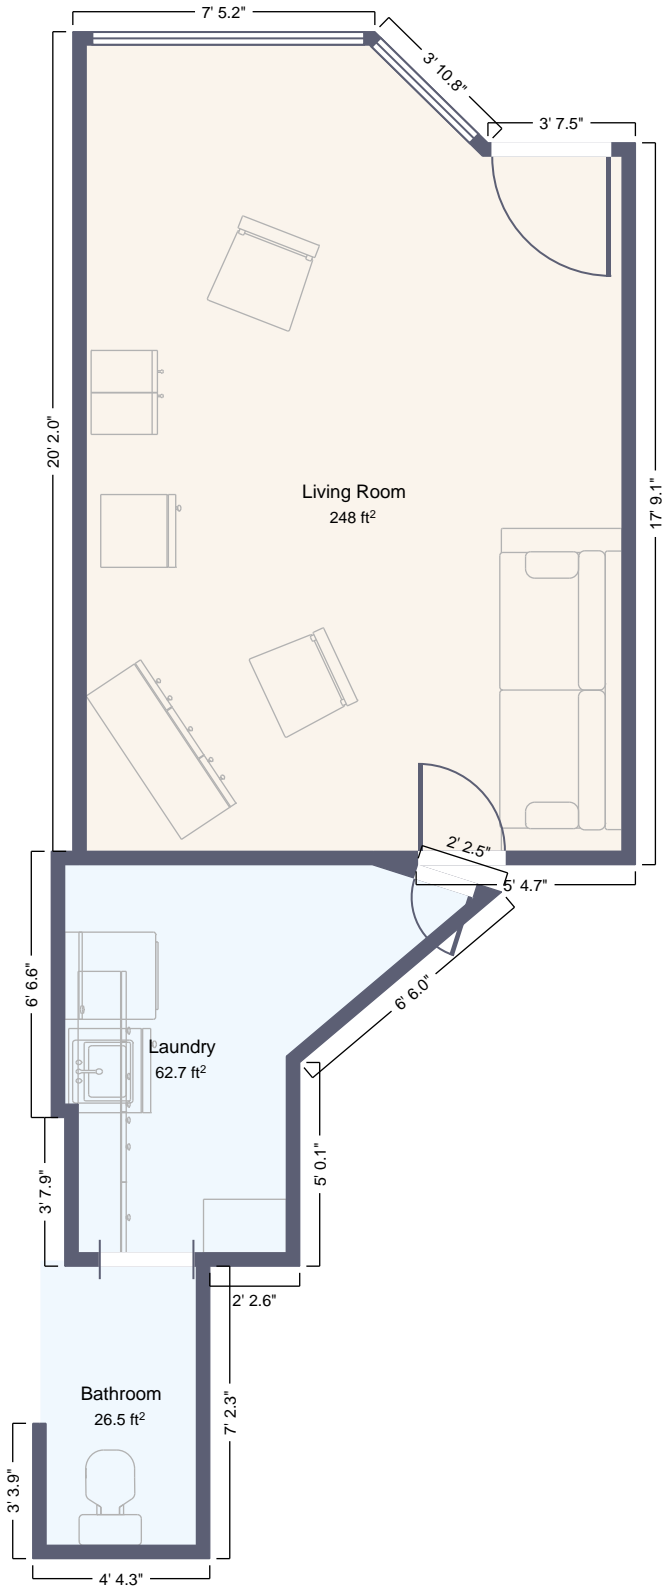

3 ft



Made with

Polycam