


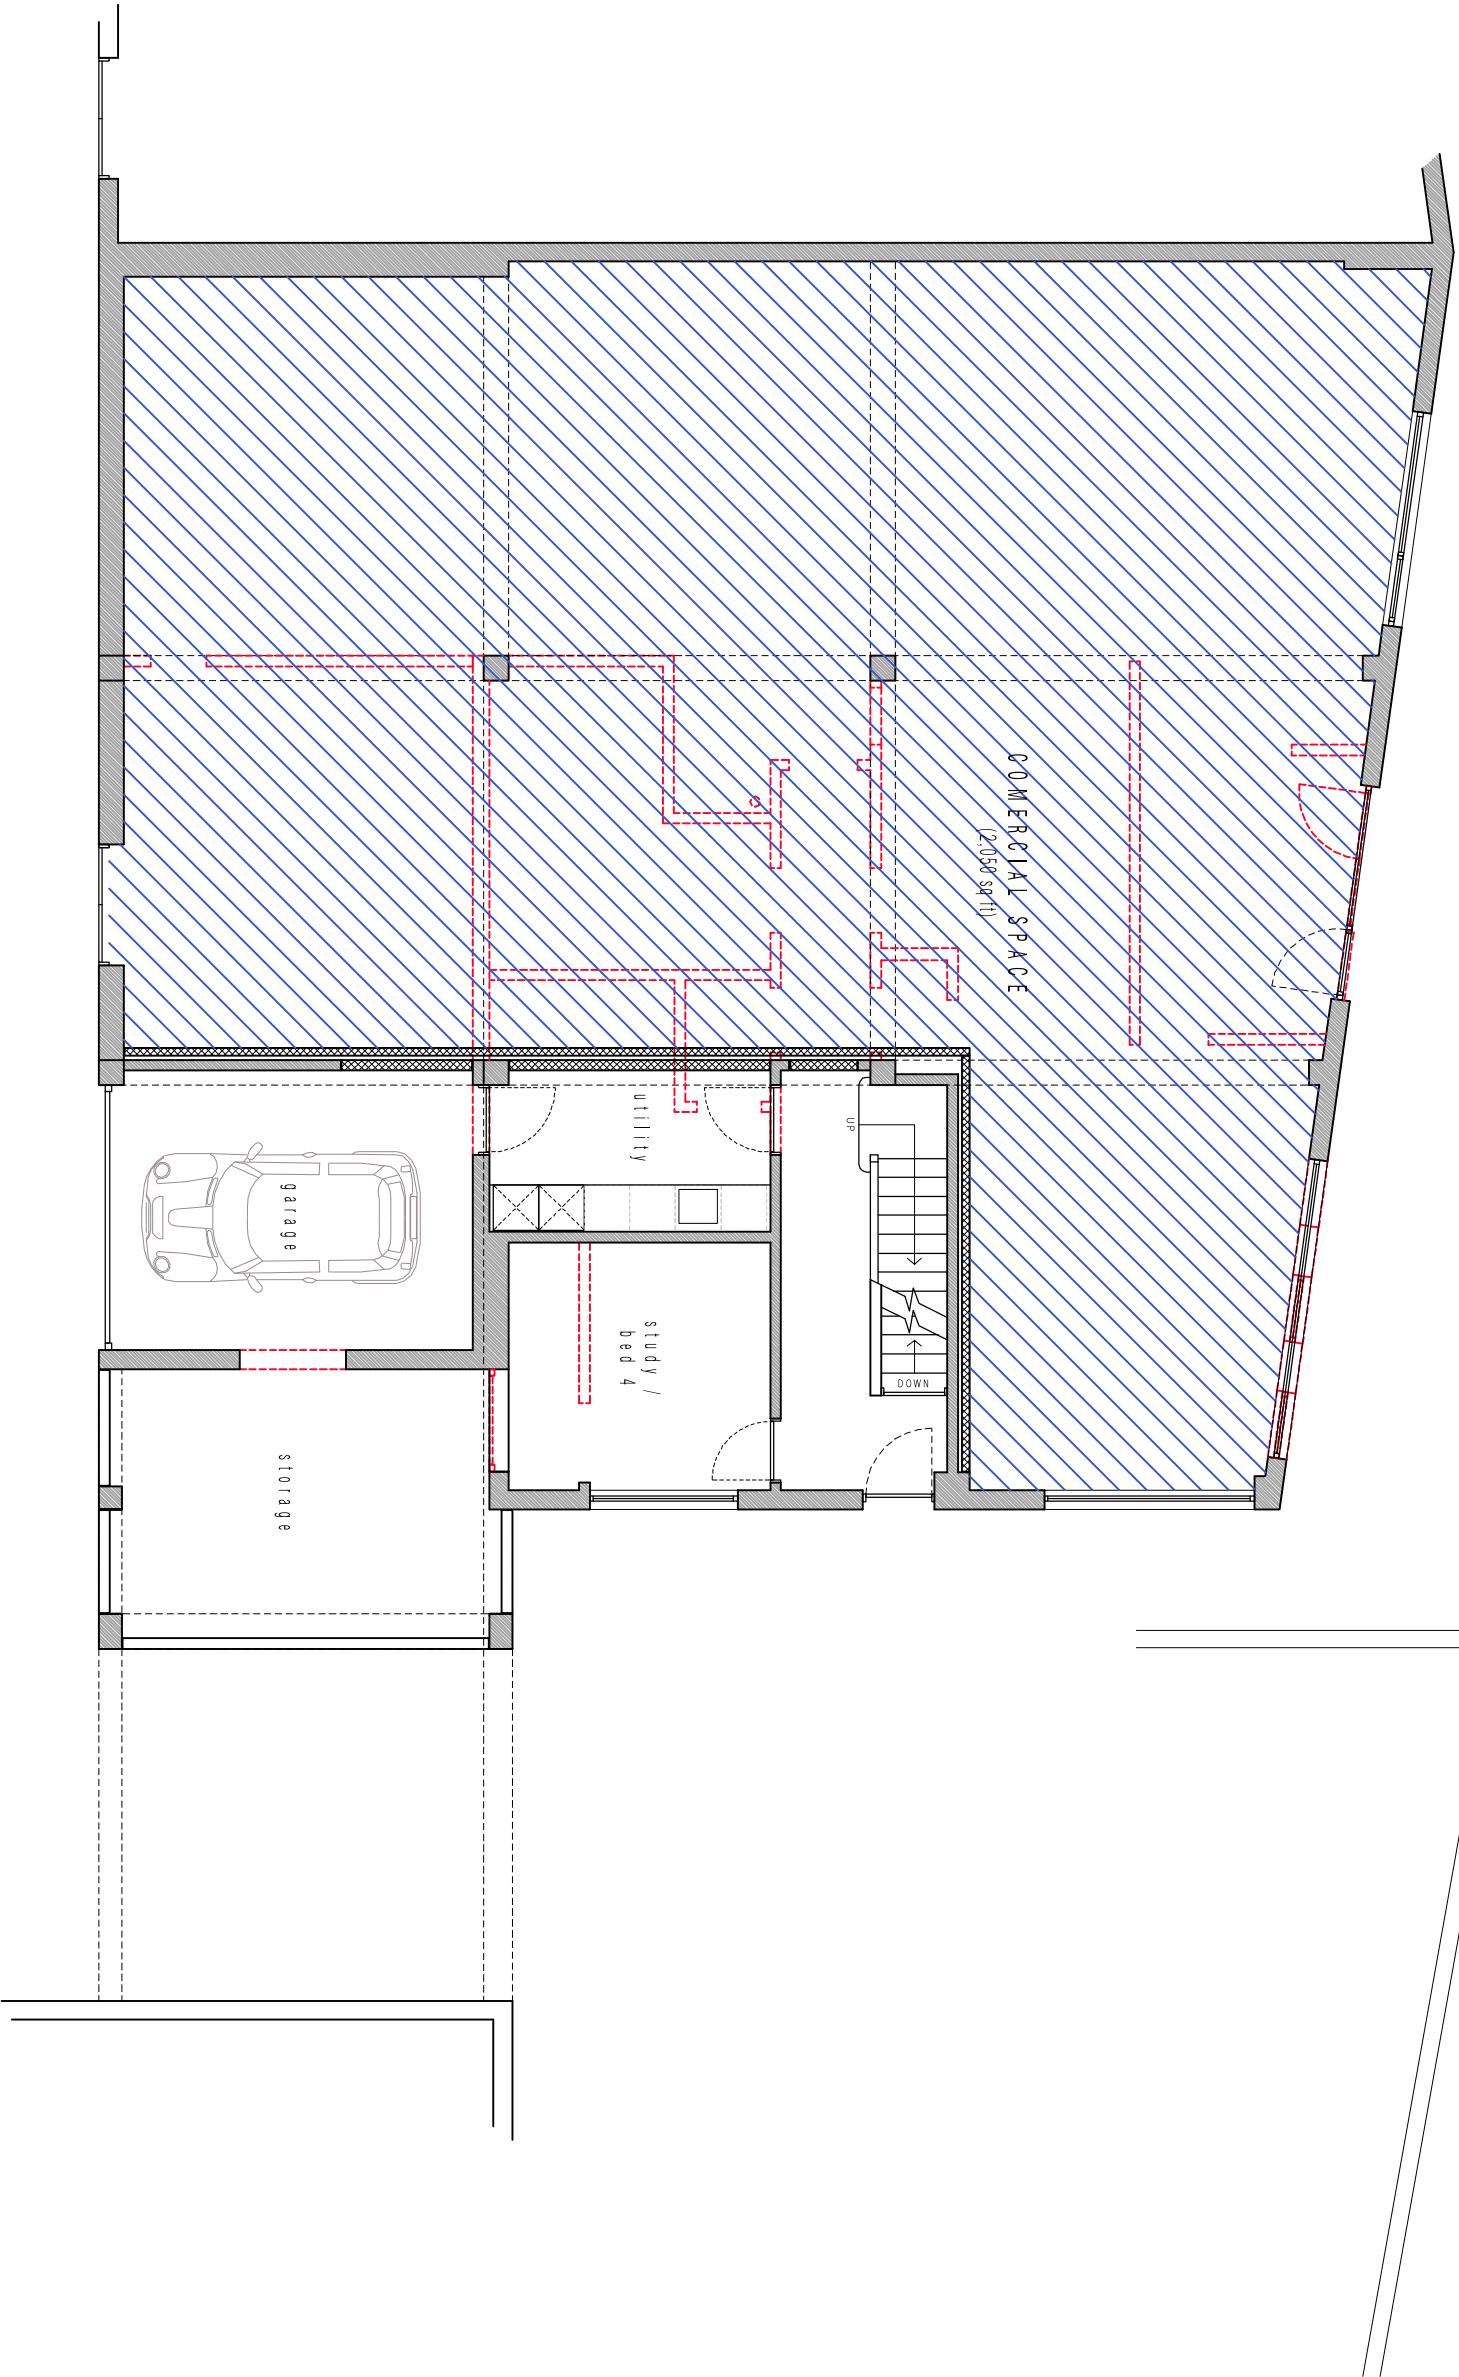

project Park House
client M. Dinham & R. Dinham
drawing Proposed Ground Floor Plan
dwg.no. S.K.005
scale 1:100 @ A3
status INFORMATION
date -