

Notes
 This drawing may be scaled for the purposes of Planning Applications, Land Registry and for Legal plans where the scale bar is used, and where it verifies that the drawing is an original or an accurate copy. It may not be scaled for construction purposes.
 Always refer to figured dimensions. All dimensions are to be checked on site. Discrepancies and/or ambiguities between this drawing and information given elsewhere must be reported immediately to this office for clarification before proceeding. All drawings are to be read in conjunction with the specification and all works to be carried out in accordance with latest British Standards / Codes of Practice.

Room Schedule			
Name	Area	Level	Department

00 Basement Floor			
Meeting Room 01	48 m ²	00 Basement Floor	Meeting
Meeting Room 02	18 m ²	00 Basement Floor	Meeting
AWW + Structemp office Space	77 m ²	00 Basement Floor	Office
Aircon Vent	7 m ²	00 Basement Floor	Electrical
Server Room	4 m ²	00 Basement Floor	Electrical
WC 01	3 m ²	00 Basement Floor	Plumbing
WC 02	3 m ²	00 Basement Floor	Plumbing
WC 03	4 m ²	00 Basement Floor	Plumbing
Kitchen	4 m ²	00 Basement Floor	Plumbing
Corridor	16 m ²	00 Basement Floor	Circulation
Stairs	19 m ²	00 Basement Floor	Circulation
Platform Lift	2 m ²	00 Basement Floor	Circulation
Electrical Cupd.	2 m ²	00 Basement Floor	Electrical
Cleaner's St.	1 m ²	00 Basement Floor	Plumbing

02 Ground Floor			
Platform Lift	2 m ²	02 Ground Floor	Circulation
New Occupiers Office Space	168 m ²	02 Ground Floor	Office
Stairs	21 m ²	02 Ground Floor	Circulation
Aircon Vent	4 m ²	02 Ground Floor	Electrical

Rev Date Init Notes Chkd

Client

Drawing Originator



London - 7 Birchin Lane, London, EC3V 9BW 020 7160 6000
 Bristol - Rivergate House, Bristol, BS1 6LS 0117 923 2535
 Plymouth - East Quay House, Plymouth, PL4 0HN 01752 261 282



RIBA Chartered Practice www.aww-uk.com

Project Title
AWW Office - 106 Weston Street, London

Drawing Title
Office Plans

Scale	Sheet	Drawn	Checked	Date
1 : 100	A2	YS	NM	24-02-23

Status	Project No.	
For Information	3540	
Drawing Reference	Drawing No.	Revision
Students Office Plans	1000	

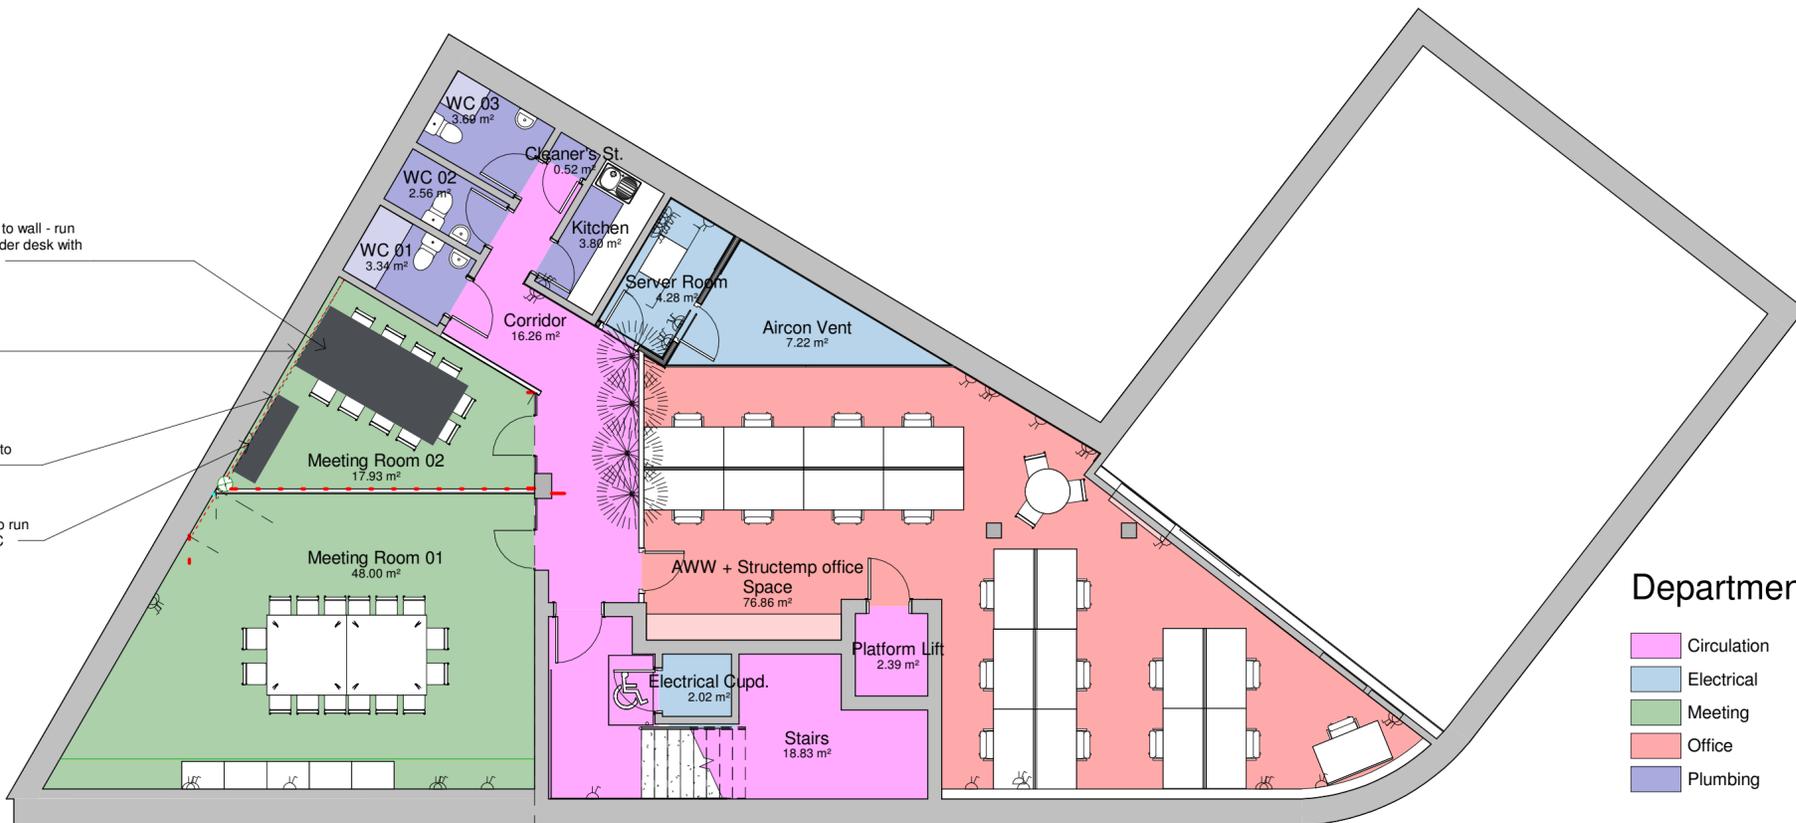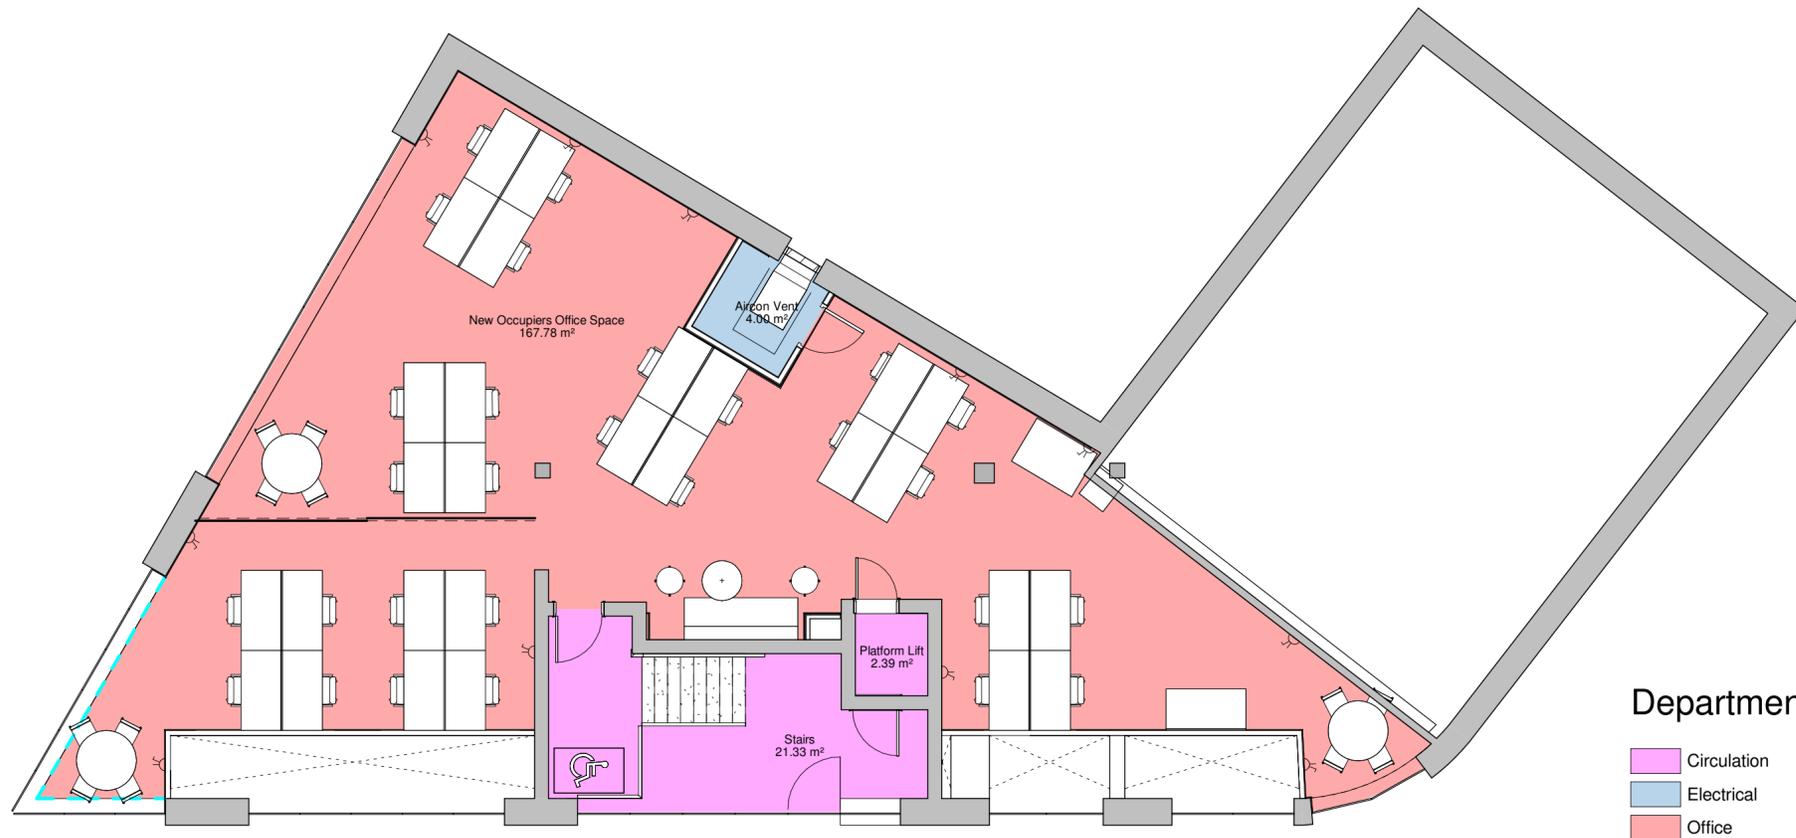

Push new longer narrower table to wall - run integrate cable management under desk with desk top power and data access

Mount TV to wall

Use existing novawall as cavity to run cables to PC

Credenza to store PC - cables to run from credenza behind wall to PC

1