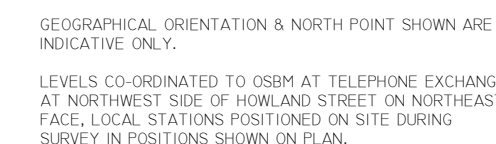


© COPYRIGHT MOBILE CAD SURVEYING SOLUTIONS LTD 2020

DO NOT SCALE THIS DRAWING - CHECK ALL DIMENSIONS ON SITE

NOTE:
AREAS DRAWN INDICATIVELY NOTED AND INDICATED BY GREY DASHED LINE AS LINE
BELOW

[illegible]

FOURTH FLOOR PLAN
1/100 SCALE

REV	DATE	AMENDMENTS
-----	------	------------