
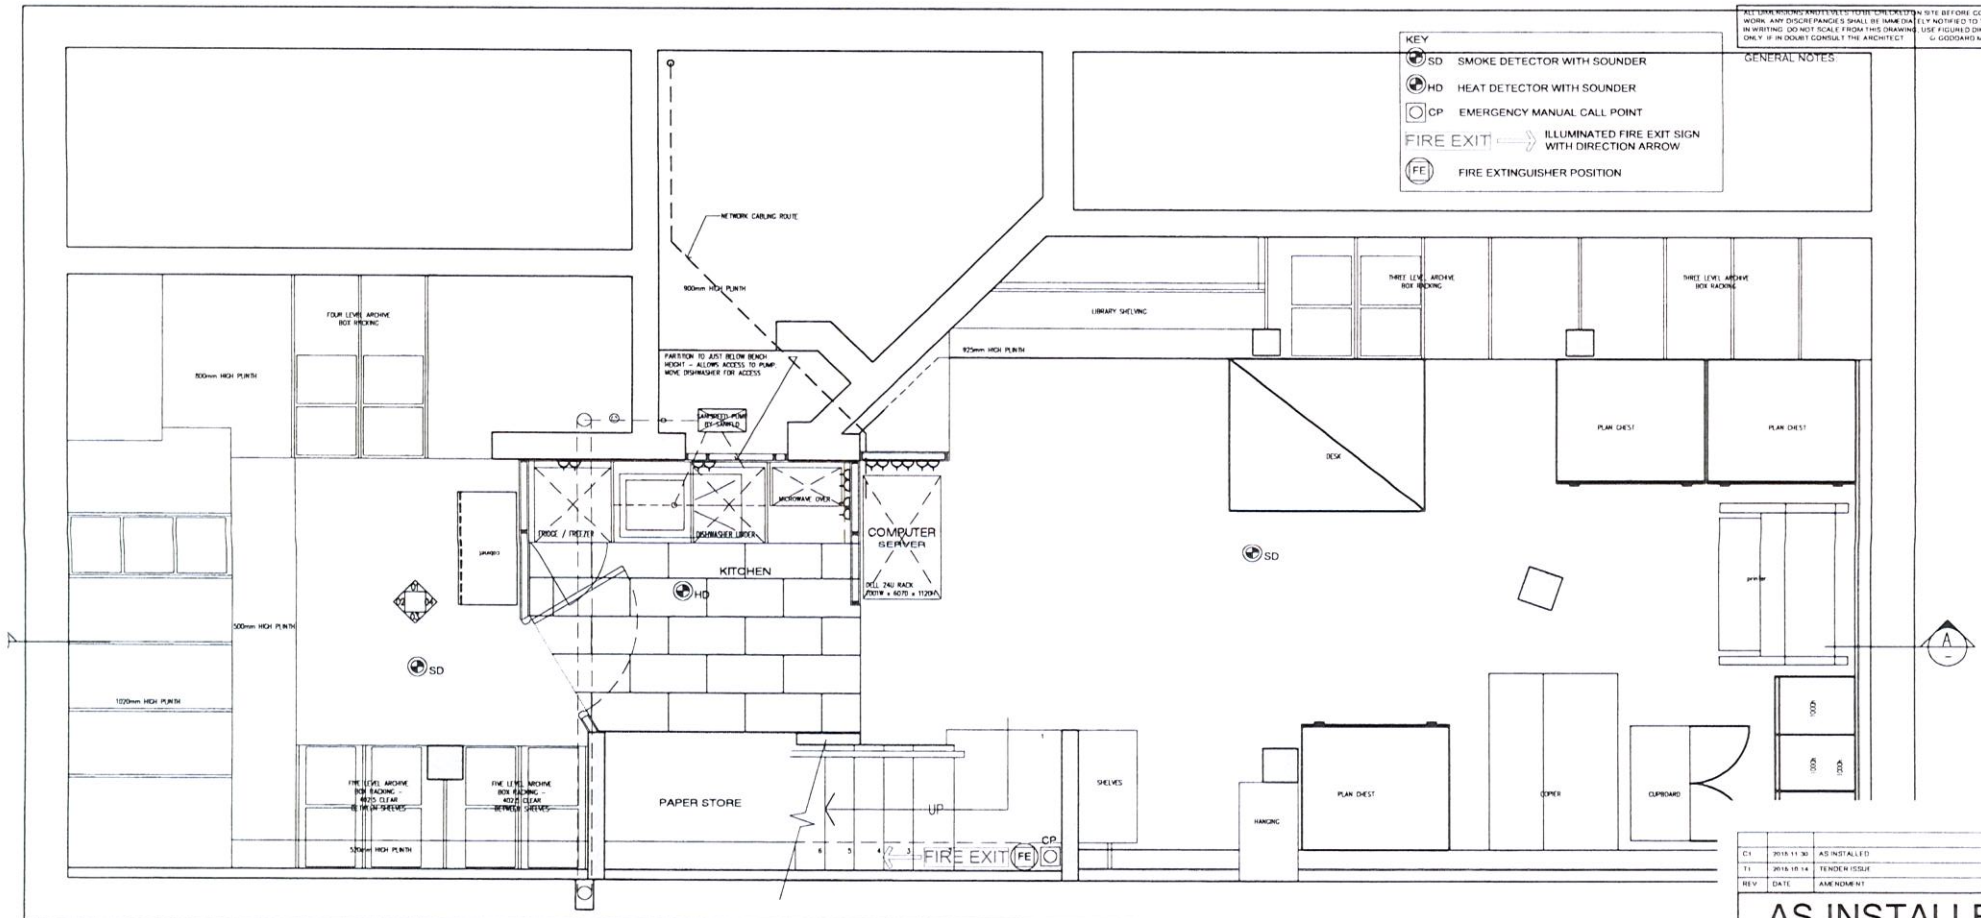


BASEMENT
1:50

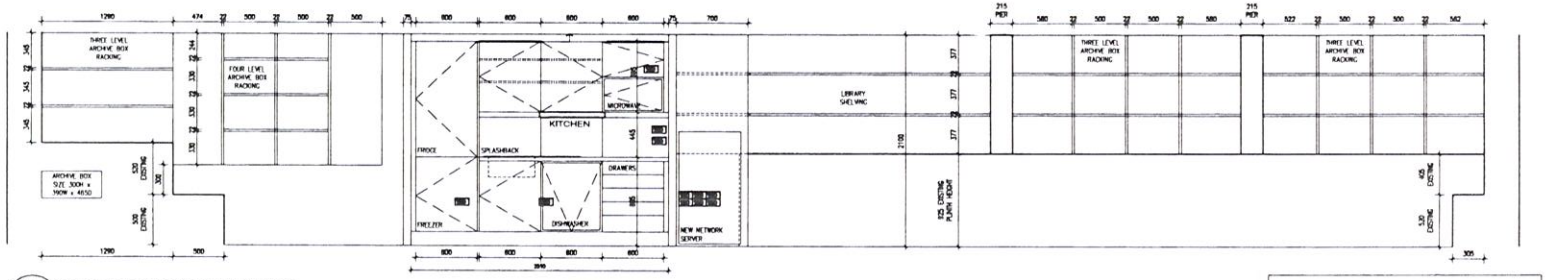

01 BASEMENT KITCHEN ELEVATION
1:25

SCHEDULE

1. SUPPLY AND INSTALL FIRE DETECTION AND ALARM SYSTEM TO CATEGORY L3 IN ACCORDANCE WITH BS 5839 PART 1.
2. SUPPLY AND INSTALL EMERGENCY LIGHTING IN ACCORDANCE WITH BS 5266.
3. TEST AND COMMISSION SYSTEMS AND CERTIFY COMPLETE INSTALLATION

GENERAL NOTES

ALL DRAWINGS AND DETAILS TO BE CHECKED ON SITE BEFORE COMMENCING WORK. ANY DISCREPANCIES SHALL BE IMMEDIATELY NOTIFIED TO THE ARCHITECT IN WRITING. DO NOT SCALE FROM THIS DRAWING. USE FIGURED DIMENSIONS ONLY. IF IN DOUBT CONSULT THE ARCHITECT.
© GODDARD MANTON LIMITED

REV	DATE	AMENDMENT	BY	CK
C1	2015.11.30	AS INSTALLED	DE	
T1	2015.10.14	TENDER ISSUE	DE	

AS INSTALLED

Goddard Manton Architects

PROJECT:
1 Bonny Street
OFFICE REFURBISHMENT

TITLE:
BASEMENT FLOOR PLAN

Goddard Manton Architects
Web: www.goddardmanton.com
Goddard Manton Limited

DRAWN	CHECKED	DATE OF ISSUE	SCALE @ A1
GRN		Oct-15	AS SHOWN

PROJ No.	DRAWING No.	REV. No.
787	200-1	C1

KEY

SD SMOKE DETECTOR WITH SOUNDER


CP EMERGENCY MANUAL CALL POINT

FIRE EXIT ILLUMINATED FIRE EXIT SIGN WITH DIRECTION ARROW

FE FIRE EXTINGUISHER LOCATION

ALL DIMENSIONS AND LEVELS TO BE CHECKED ON SITE BEFORE COMMENCING WORK. ANY DISCREPANCIES SHALL BE IMMEDIATELY NOTIFIED TO THE ARCHITECT IN WRITING. DO NOT SCALE FROM THIS DRAWING. USE FIGURED DIMENSIONS ONLY. IF IN DOUBT CONSULT THE ARCHITECT. © GODDARD MANTON LIMITED


GENERAL NOTES

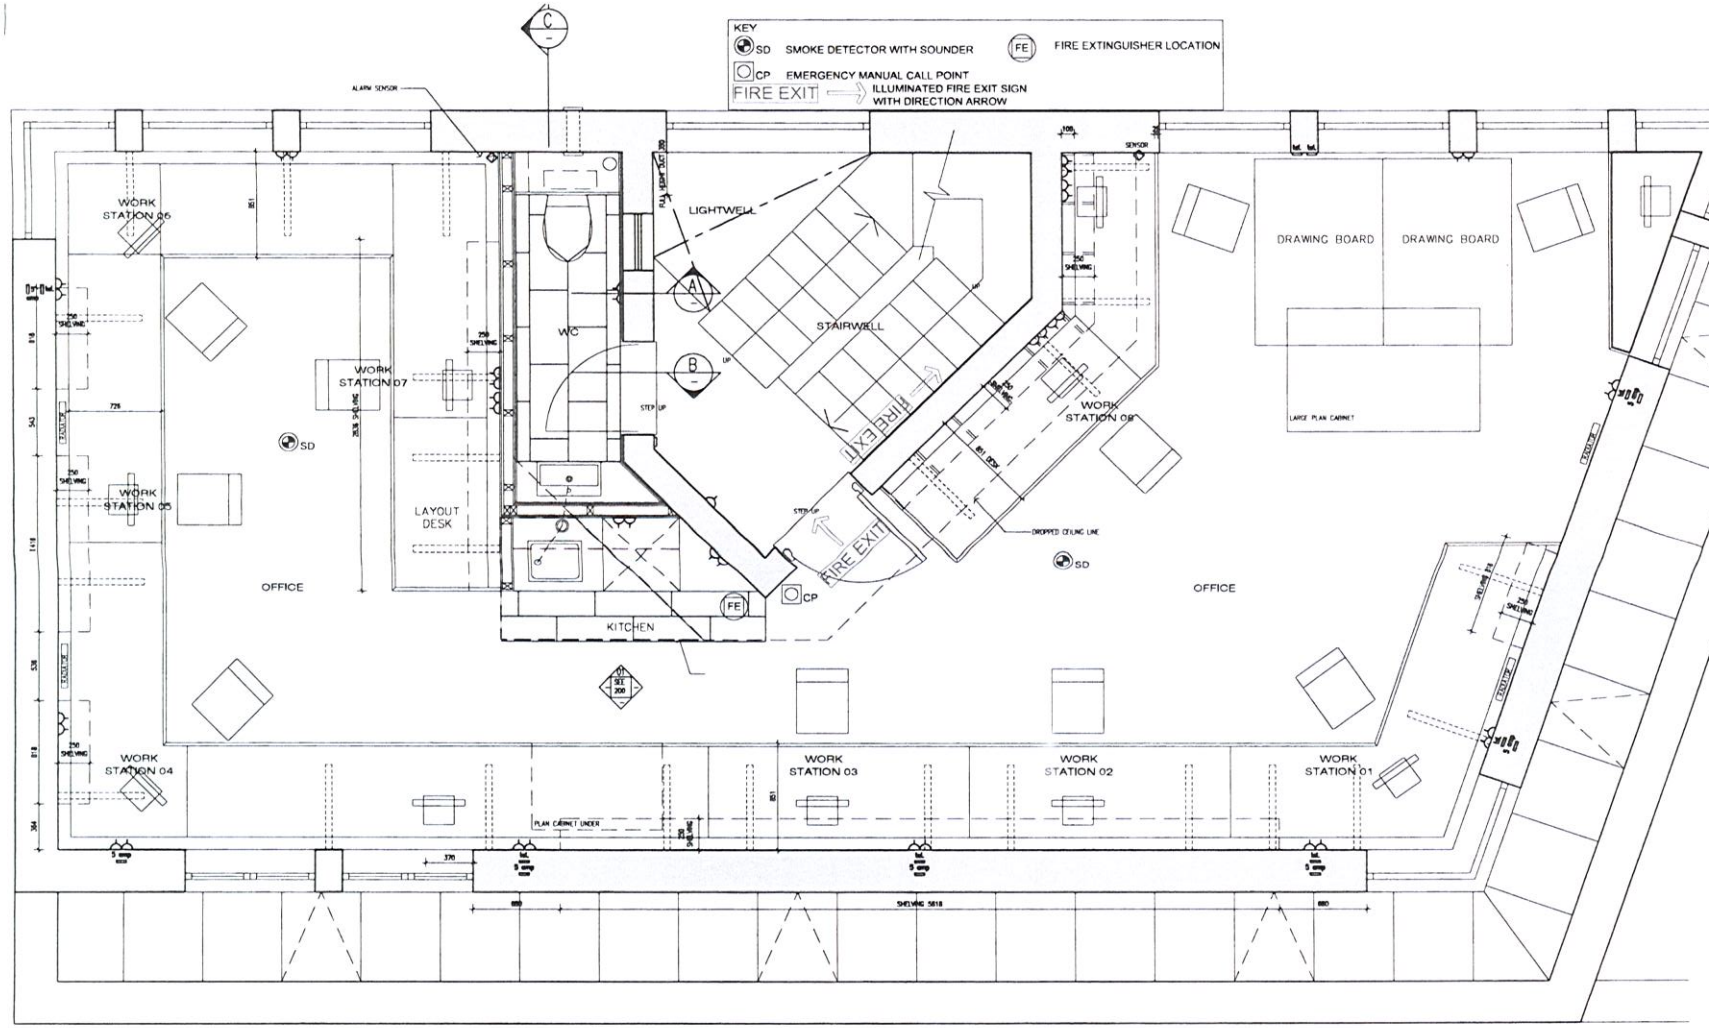


SCHEDULE


1. SUPPLY AND INSTALL FIRE DETECTION AND ALARM SYSTEM TO CATEGORY L3 IN ACCORDANCE WITH BS 5839 PART 1
2. SUPPLY AND INSTALL EMERGENCY LIGHTING IN ACCORDANCE WITH BS 5266
3. TEST AND COMMISSION SYSTEMS AND CERTIFY COMPLETE INSTALLATION

FIRST FLOOR PLAN
1:20

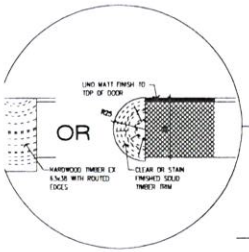


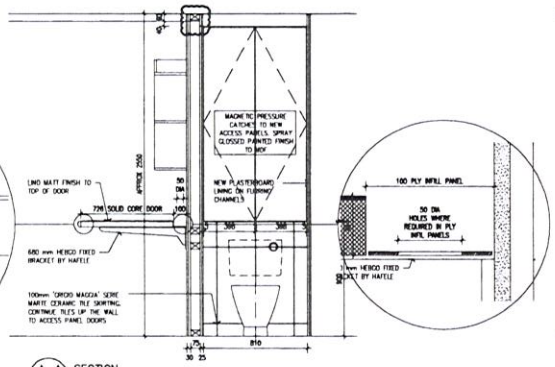

A-A SECTION
1:20

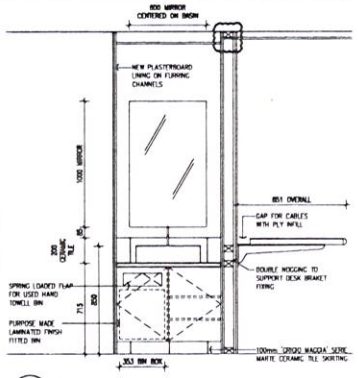

B-B SECTION
1:20

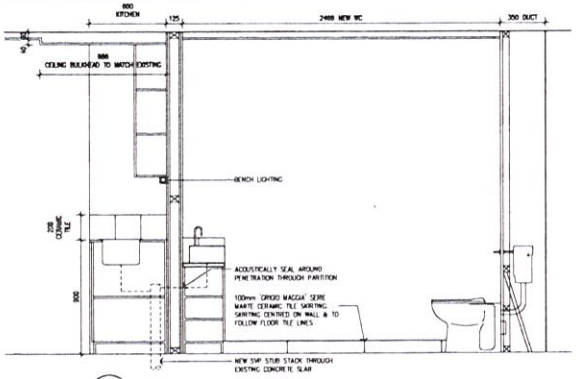

C-C SECTION
1:20

REV	DATE	AMENDMENT	BY	CK
C1	2015.11.30	AS INSTALLED	DI	
T1	2015.10.14	TENDER ISSUE	DI	

AS INSTALLED

Goddard Manton Architects

PROJECT:
1 Bonny Street
OFFICE REFURBISHMENT

TITLE:
FIRST FLOOR PLAN


Goddard Manton Architects
Web: www.goddardmanton.com
Goddard Manton Limited

DRAWN	CHECKED	DATE	SCALE @ A1
GRN		Oct-15	1:20

PROJ No.	DRAWING No.	REV. No
787	201	C1

BONNY STREET

ENTRANCE

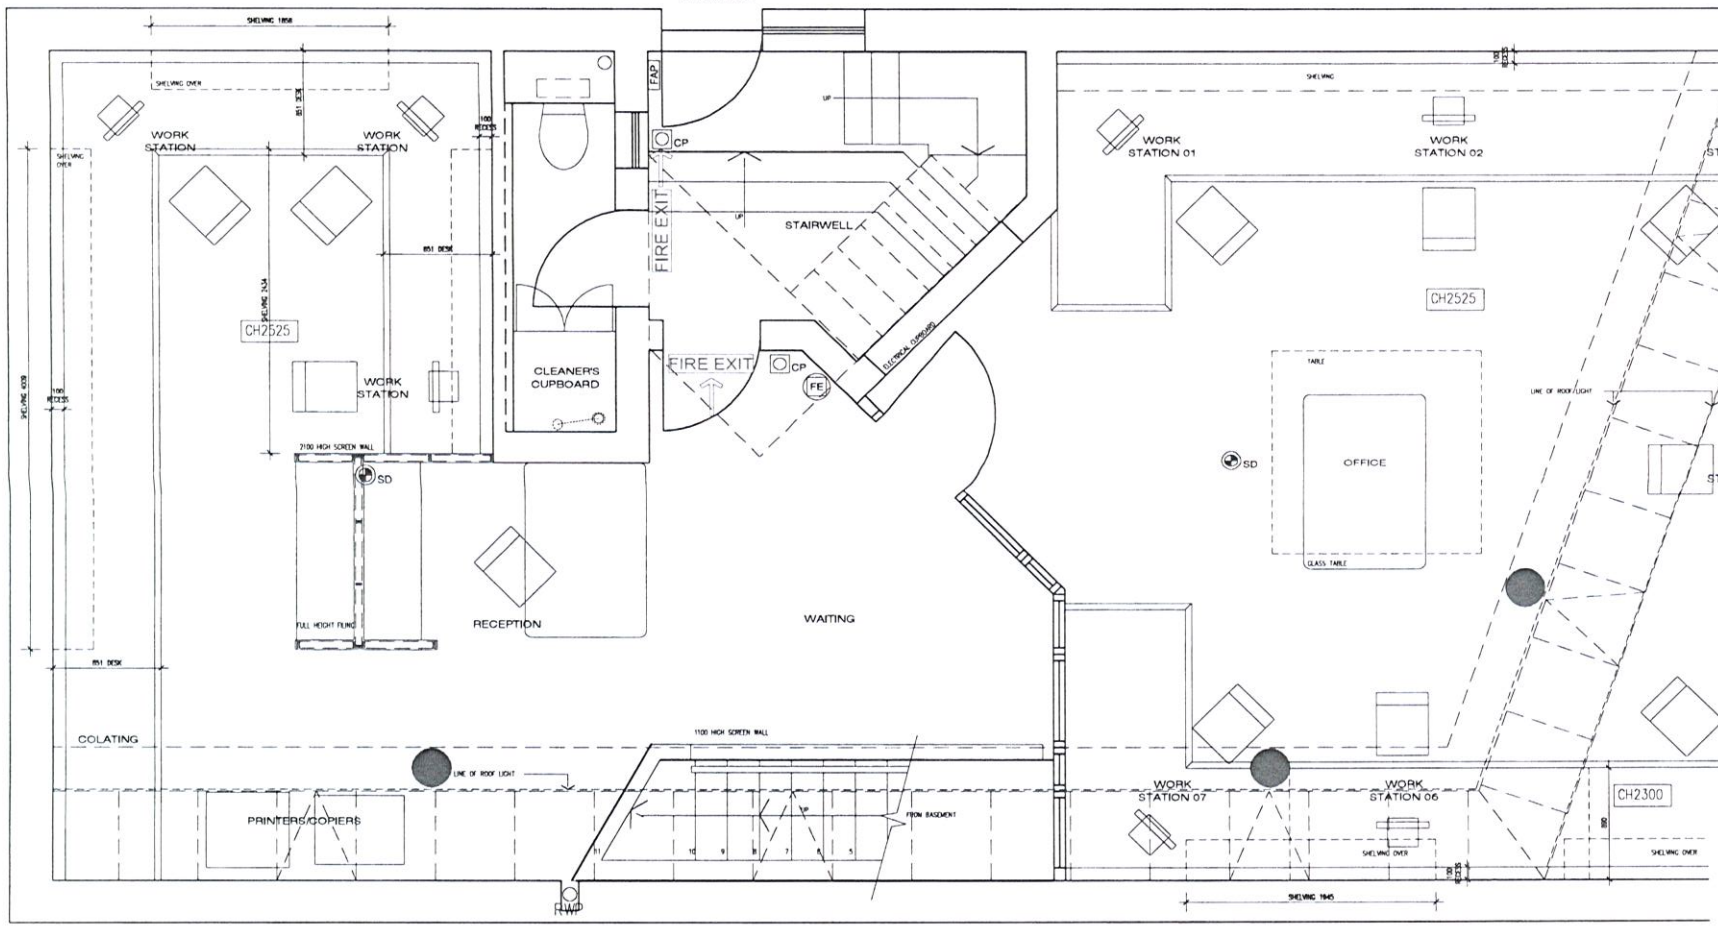

GROUND FLOOR PLAN
1:50

KEY

SD	SMOKE DETECTOR WITH SOUNDER
CP	EMERGENCY MANUAL CALL POINT
FIRE EXIT	ILLUMINATED FIRE EXIT SIGN WITH DIRECTION ARROW
FAP	FIRE ALARM PANEL
FE	FIRE EXTINGUISHER POSITION

SCHEDULE

1. SUPPLY AND INSTALL FIRE DETECTION AND ALARM SYSTEM TO CATEGORY L3 IN ACCORDANCE WITH BS 5839 PART 1.
2. SUPPLY AND INSTALL EMERGENCY LIGHTING IN ACCORDANCE WITH BS 5266.
3. TEST AND COMMISSION SYSTEMS AND CERTIFY COMPLETE INSTALLATION.

ALL DIMENSIONS AND LEVELS TO BE CHECKED ON SITE BEFORE COMMENCING WORK. ANY DISCREPANCIES SHALL BE IMMEDIATELY NOTIFIED TO THE ARCHITECT IN WRITING. DO NOT SCALE FROM THIS DRAWING. USE FIGURED DIMENSIONS ONLY. IF IN DOUBT CONSULT THE ARCHITECT. (c) GODDARD MANTON LIMITED

GENERAL NOTES

REV.	DATE	AMENDMENT	BY	CK
C1	2015.11.30	AS INSTALLED	DE	
T1	2015.10.14	ISSUE FOR TENDER	DE	

AS INSTALLED

Goddard Manton Architects

PROJECT:
1 Bonny Street
OFFICE REFURBISHMENT

TITLE:
GROUND FLOOR PLAN


Goddard Manton Architects

DRAWN	CHECKED	DATE	SCALE @ A1
GRN		Oct-15	1:20

PROJ No.	DRAWING No.	REV. No.
787	200	C1

ALL DIMENSIONS AND LEVELS TO BE CHECKED ON SITE BEFORE COMMENCING WORK. ANY DISCREPANCIES SHALL BE IMMEDIATELY NOTIFIED TO THE ARCHITECT IN WRITING. DO NOT SCALE FROM THIS DRAWING, USE FIGURED DIMENSIONS ONLY. IF IN DOUBT CONSULT THE ARCHITECT. © GODDARD MANTON LIMITED

GENERAL NOTES:

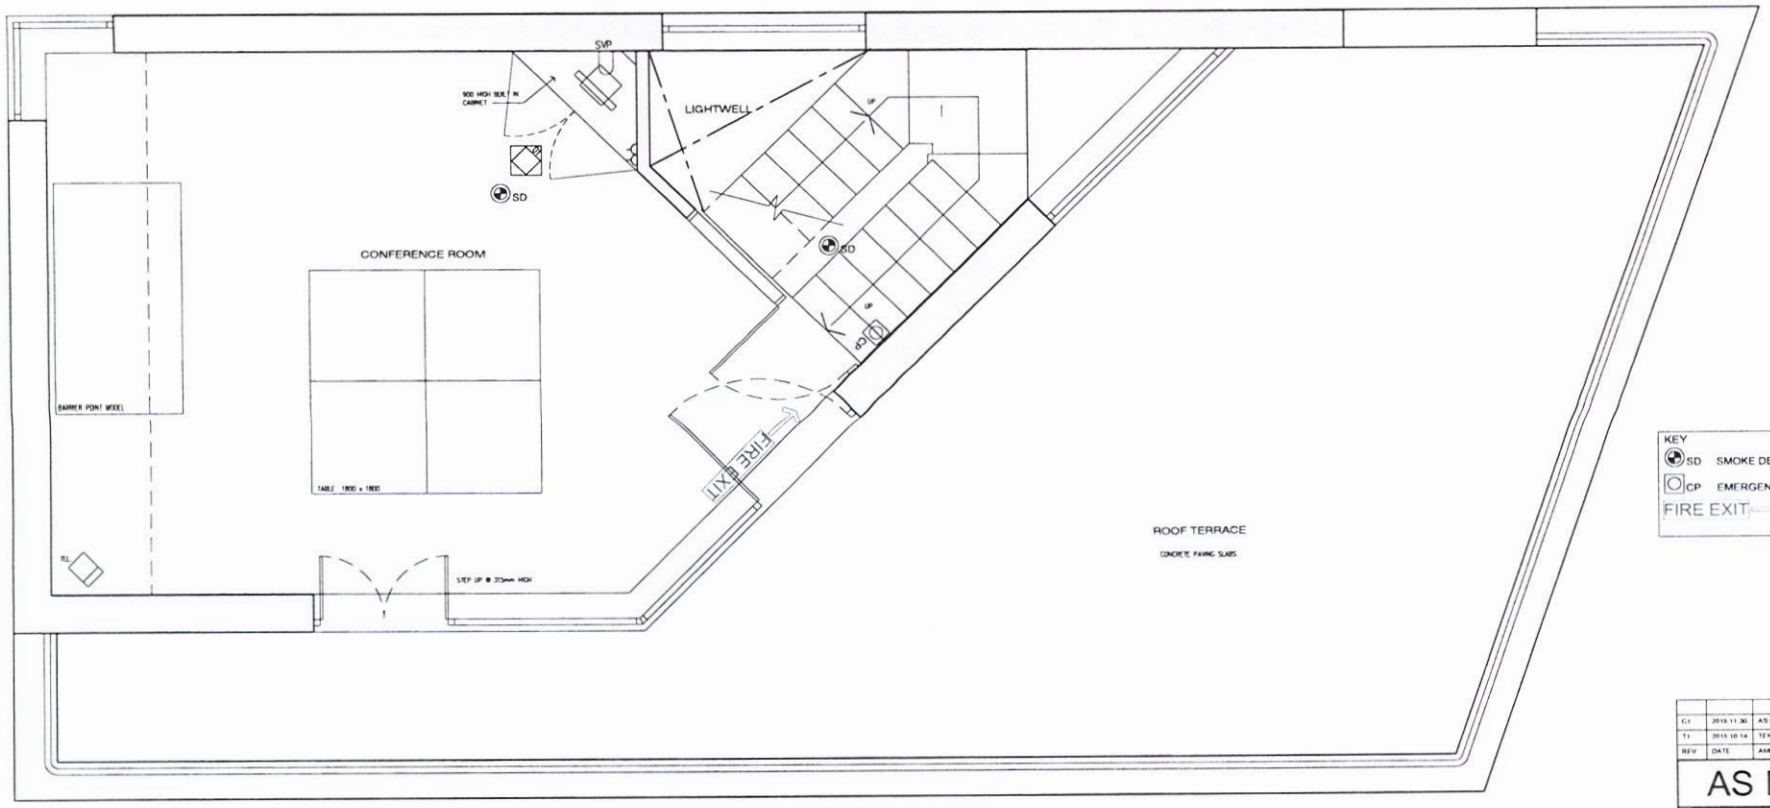

SECOND FLOOR PLAN
1:50

KEY
SD SMOKE DETECTOR WITH SOUNDER
CP EMERGENCY MANUAL CALL POINT
FIRE EXIT ILLUMINATED FIRE EXIT SIGN WITH DIRECTION ARROW

REV	DATE	AMENDMENT	BY	CK
C1	2016.11.30	AS INSTALLED	DE	
T1	2016.10.14	TENDER ISSUE	DE	

AS INSTALLED

Goddard Manton Architects

PROJECT:
1 Bonny Street
OFFICE REFURBISHMENT

TITLE:
SECOND FLOOR PLAN

SCHEDULE

1. SUPPLY AND INSTALL FIRE DETECTION AND ALARM SYSTEM TO CATEGORY L3 IN ACCORDANCE WITH BS 5839 PART 1
2. SUPPLY AND INSTALL EMERGENCY LIGHTING IN ACCORDANCE WITH BS 5266
3. TEST AND COMMISSION SYSTEMS AND CERTIFY COMPLETE INSTALLATION

Goddard Manton Architects
Web: www.goddardmanton.com
Goddard Manton Limited

DRAWN	CHECKED	DATE	SCALE @ A1
GRN		Oct-15	1:20

PROJ No.	DRAWING No.	REV. No.
787	202	C1