


540 ELDER HOUSE, CENTRAL MILTON KEYNES

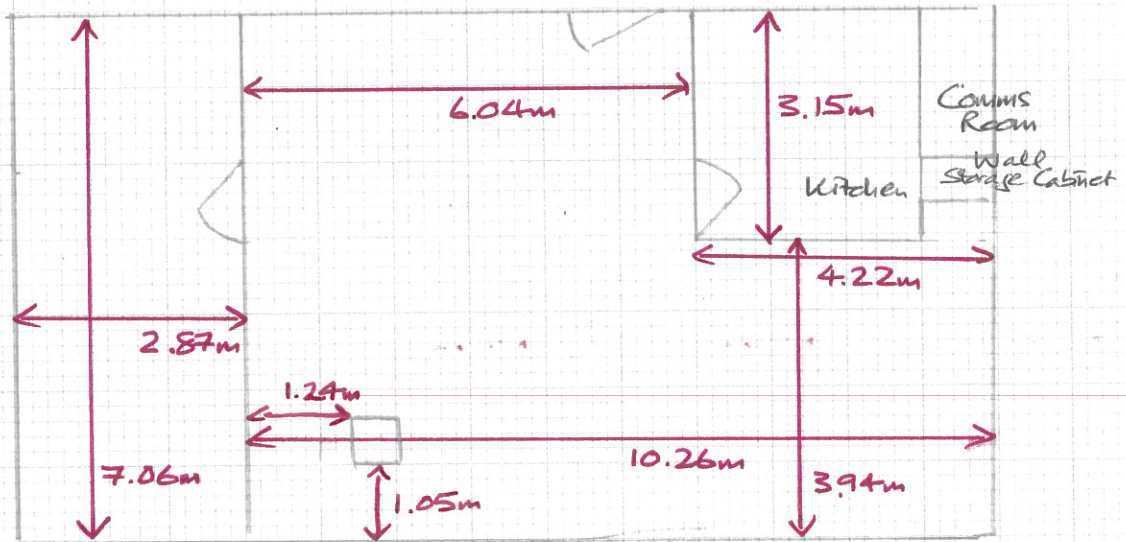

FOR INFORMATION ONLY.

NOT TO SCALE.