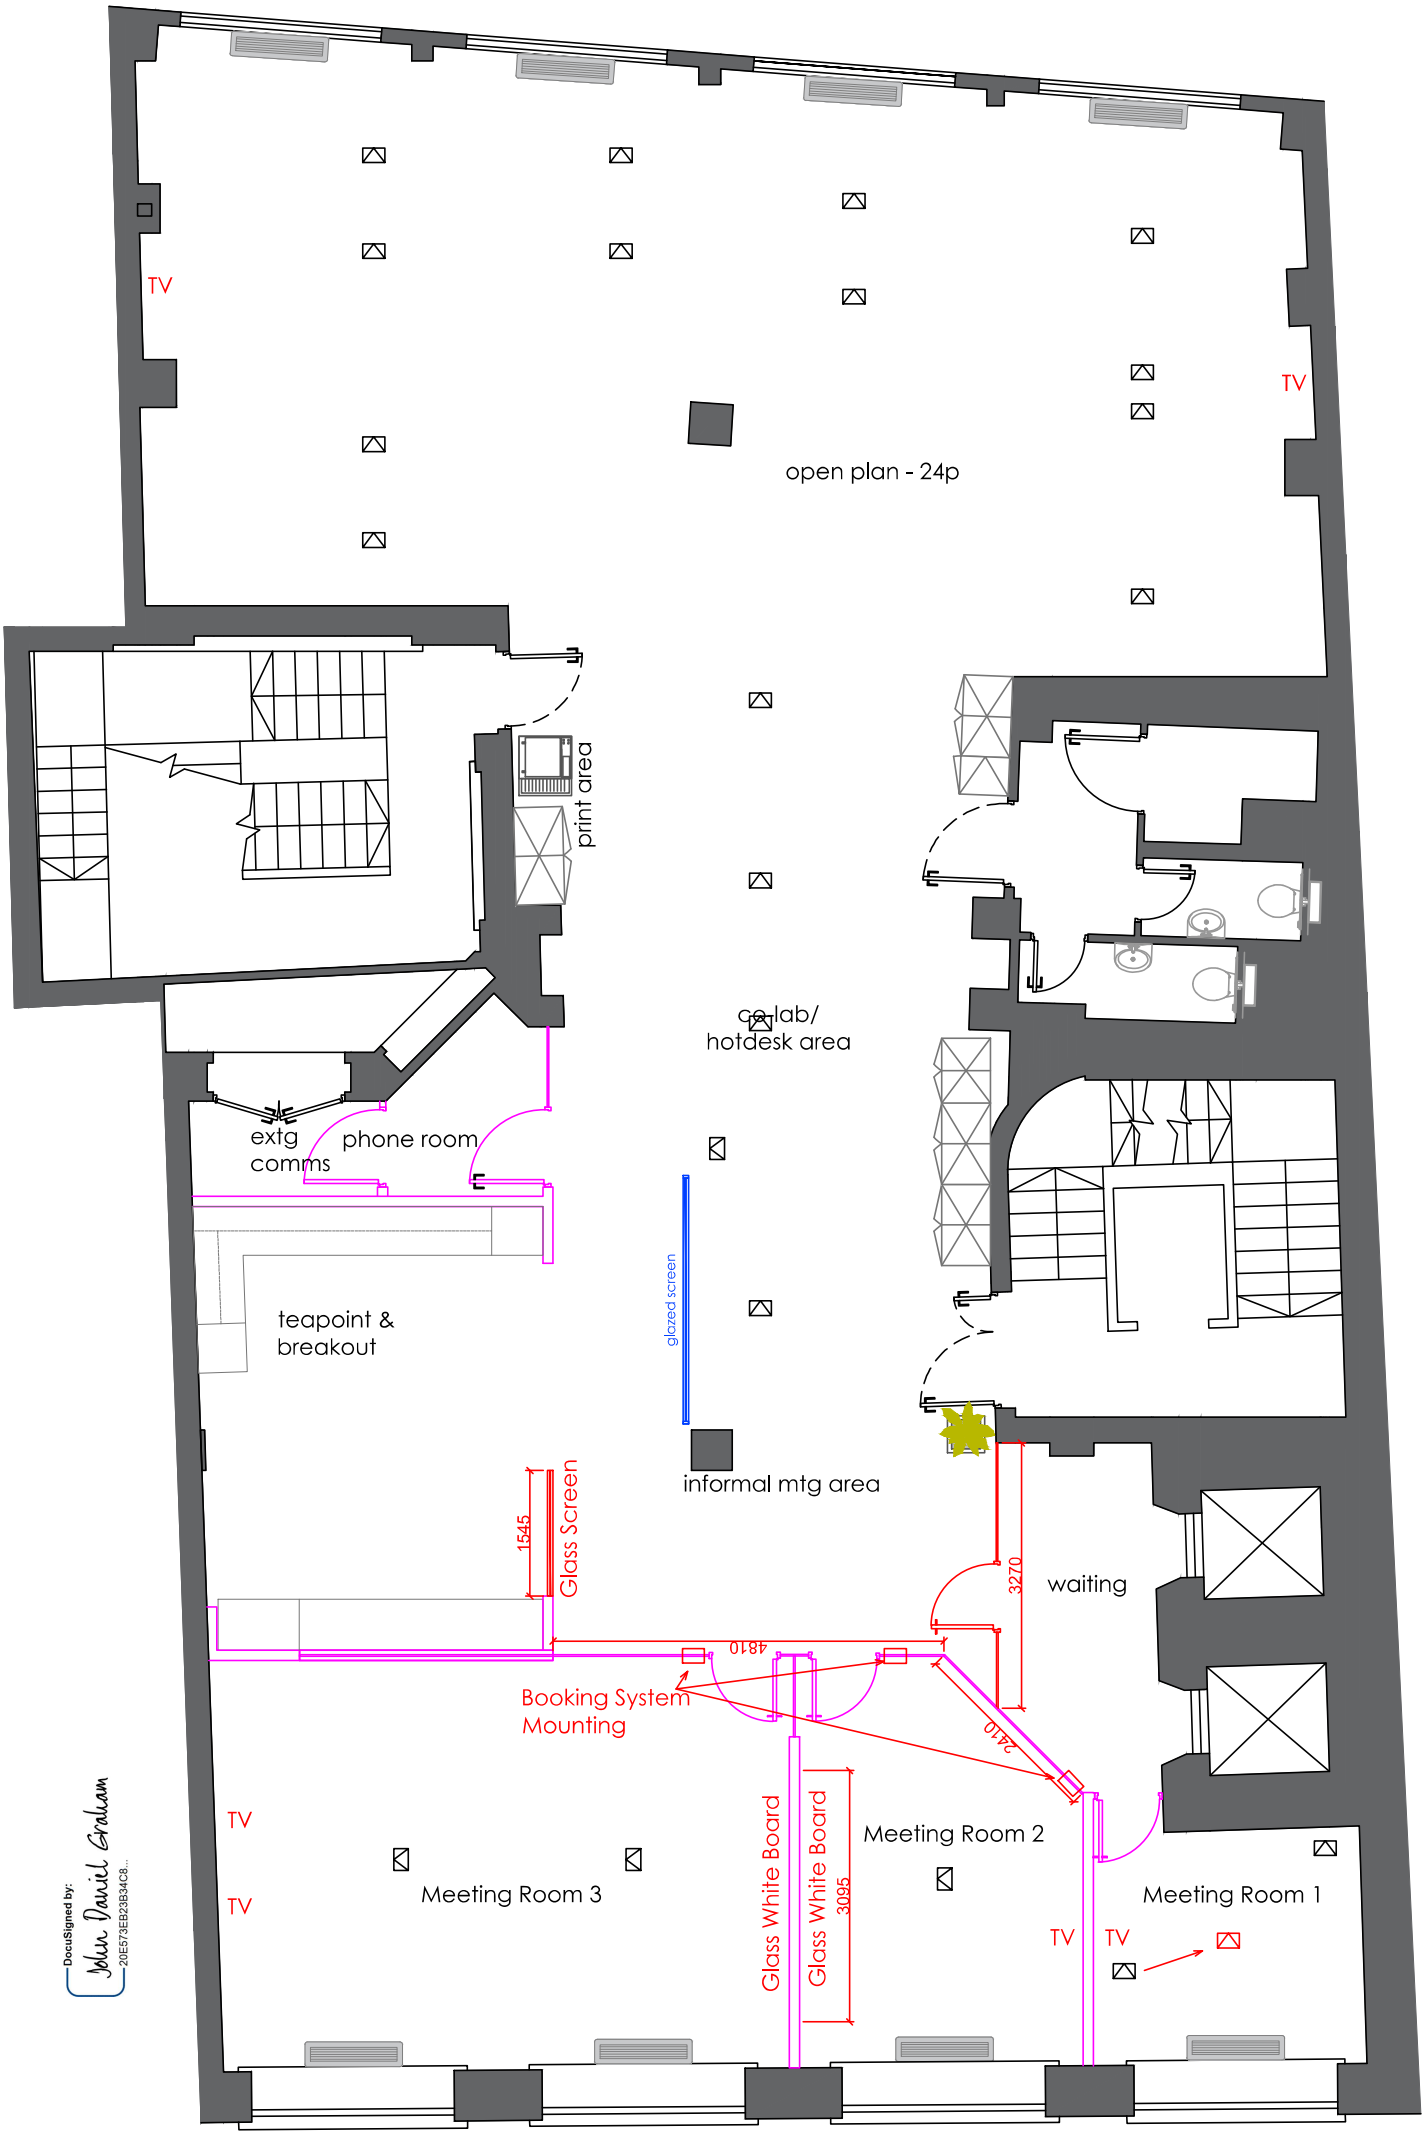


DocuSign Envelope ID: 3476CC8A-7019-45EC-BE83-3703635B66CF

DocuSigned by:
John Daniel Graham
20E573EB23B34C8...