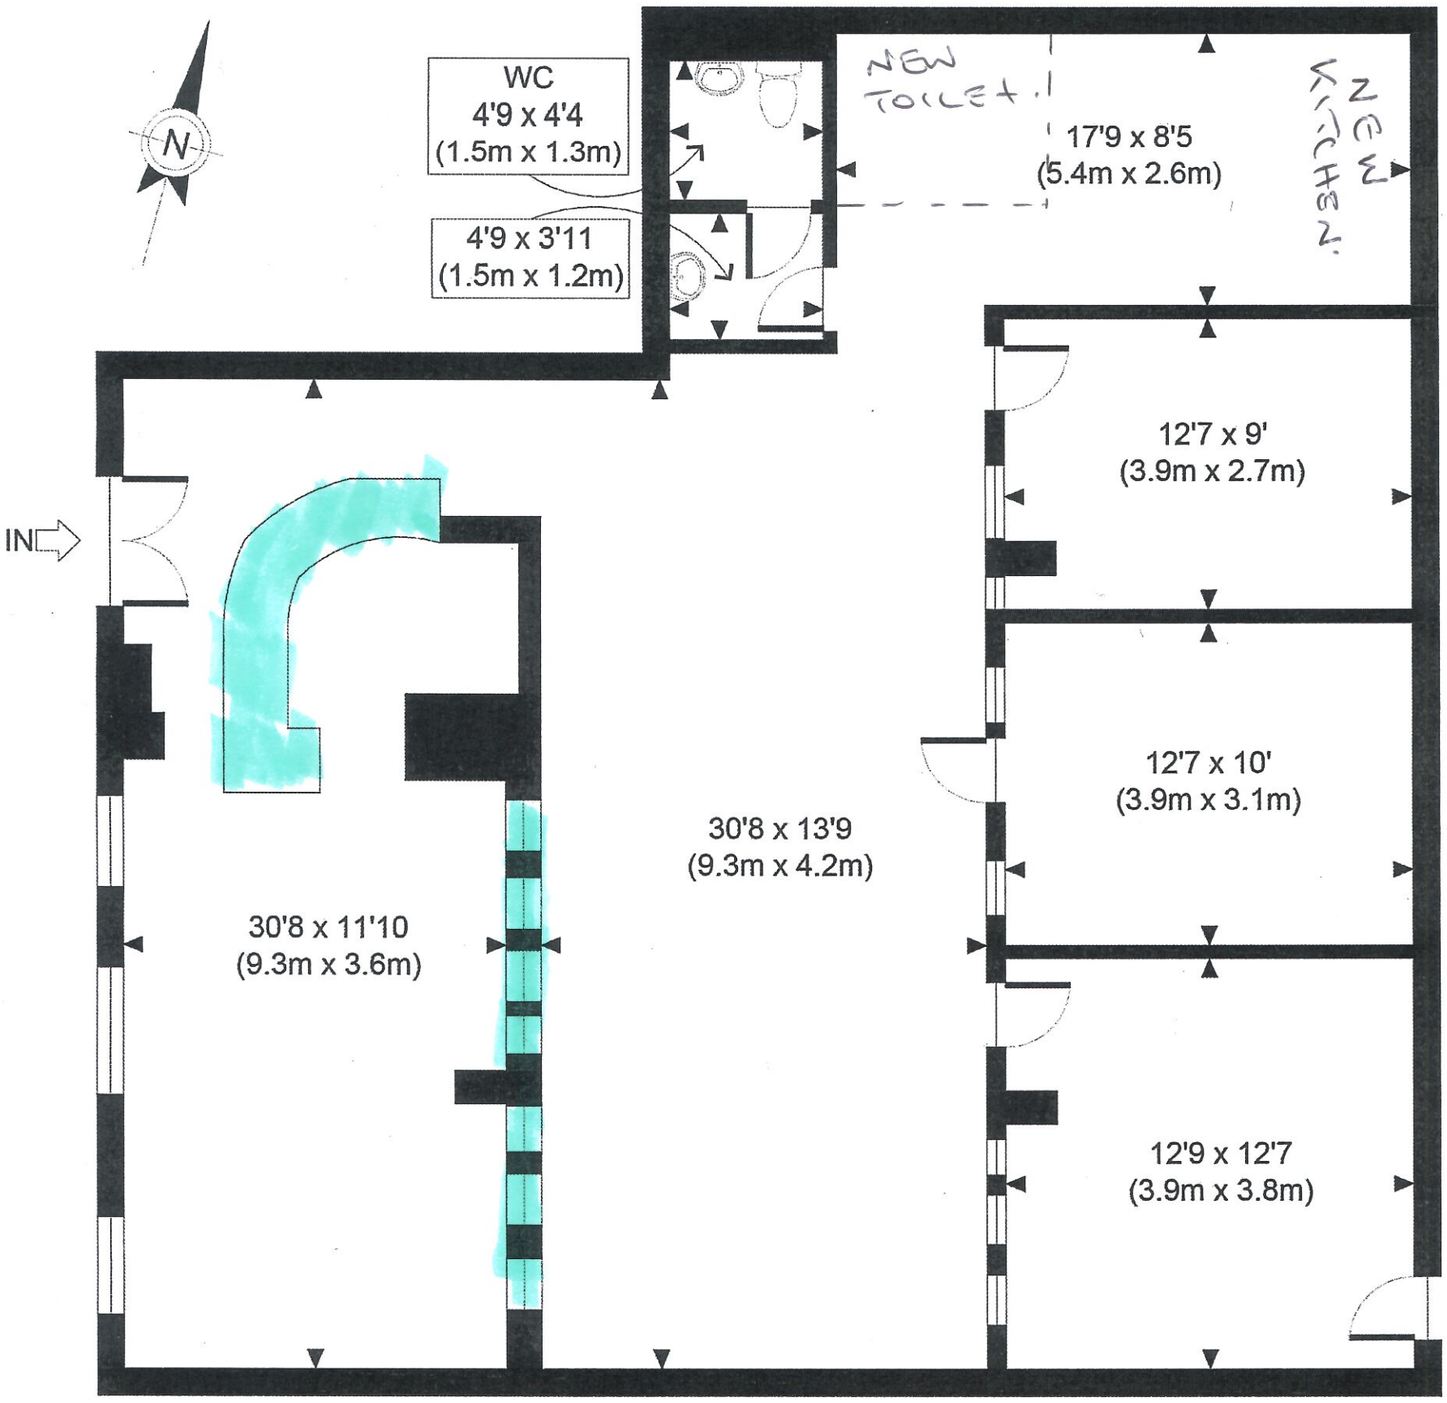


GROUND FLOOR
GROSS INTERNAL
FLOOR AREA 1468 SQ FT

APPROX. GROSS INTERNAL FLOOR AREA 1468 SQ FT / 136 SQM

Ref:

Copyright photoplan

Disclaimer: Floor plan measurements are approximate and are for illustrative purposes only. While we do not doubt the floor plan accuracy and completeness, you or your advisors should conduct a careful, independent investigation of the property in respect of monetary valuation