



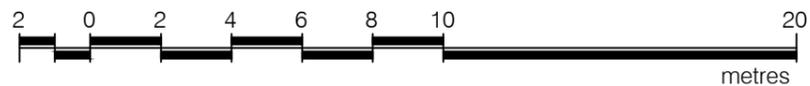

Approximate Direction North

	01110	NIA	171.19 m ²
	NHSPS Vacant Liability	NIA	132.83 m ²
	NHSPS Sessional Space	NIA	74.45 m ²
	NHSPS Shared Area	NIA	96.14 m ²
	NHSPS Common Parts	GIA	28.51 m ²
	NHSPS Retained Area	GIA	1.82 m ²

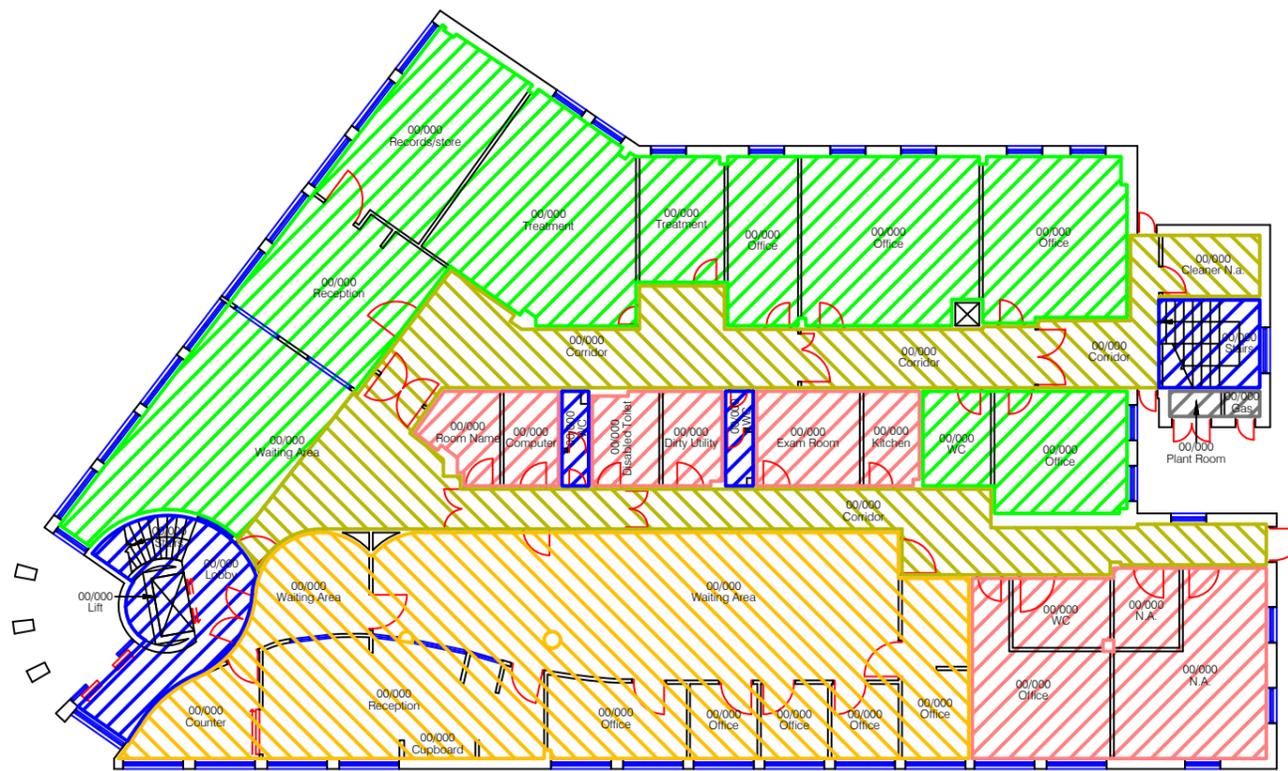


Ground Floor*
 GEA 557.26 m²
 GIA 523.09 m²
 NIA 484.14 m²

*Whole floor areas, not the sum of parts listed above

RECORD

This Drawing/ Specification is the property of NHS Property Services, and may not be reproduced or disclosed to a third party in any form without the written permission of NHS Property Services.
 ANY ROOM AREAS SHOWN ARE INDICATIVE ONLY.
 ALL MEASUREMENTS ARE TO BE VERIFIED ON SITE.

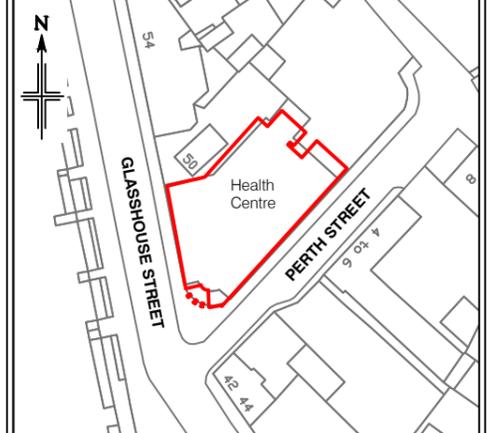

Location Plan

Scale 1:1250

Building Outline

Care should be taken when drawings are printed to avoid image distortion.

© Crown copyright and database rights 2024 OS AC0000810047.
 Information produced by HM Land Registry. The Polygons, (including the associated geometry, namely x, y co-ordinates) are subject to Crown copyright and database rights 2024 and are reproduced with the permission of Ordnance Survey

You are granted a non-exclusive, royalty free, revocable licence solely to view the Licensed Data for non-commercial purposes for the period during which NHS Property Services makes it available. You are not permitted to copy, sub-license, distribute, sell or otherwise make available the Licensed Data to third parties in any form. Third party rights to enforce the terms of this licence shall be reserved to Ordnance Survey.

Notes:

Date	Comments	Rev.
12/11/2024	AMENDED	R04
25/01/2022	AMENDED	R03



Property Services

Site Address

VICTORIA HEALTH CENTRE
 GLASSHOUSE STREET
 NOTTINGHAM
 NG1 3LU

Site	Orig.	Role	Level	Type	Rev.
10007724	GL	CAD	GF	FP	R04
Floor/Level			GROUND FLOOR		
Scale			1:200 @ A3		
Date			MARCH 2009		