



Proposed Floor Plan- 1:100

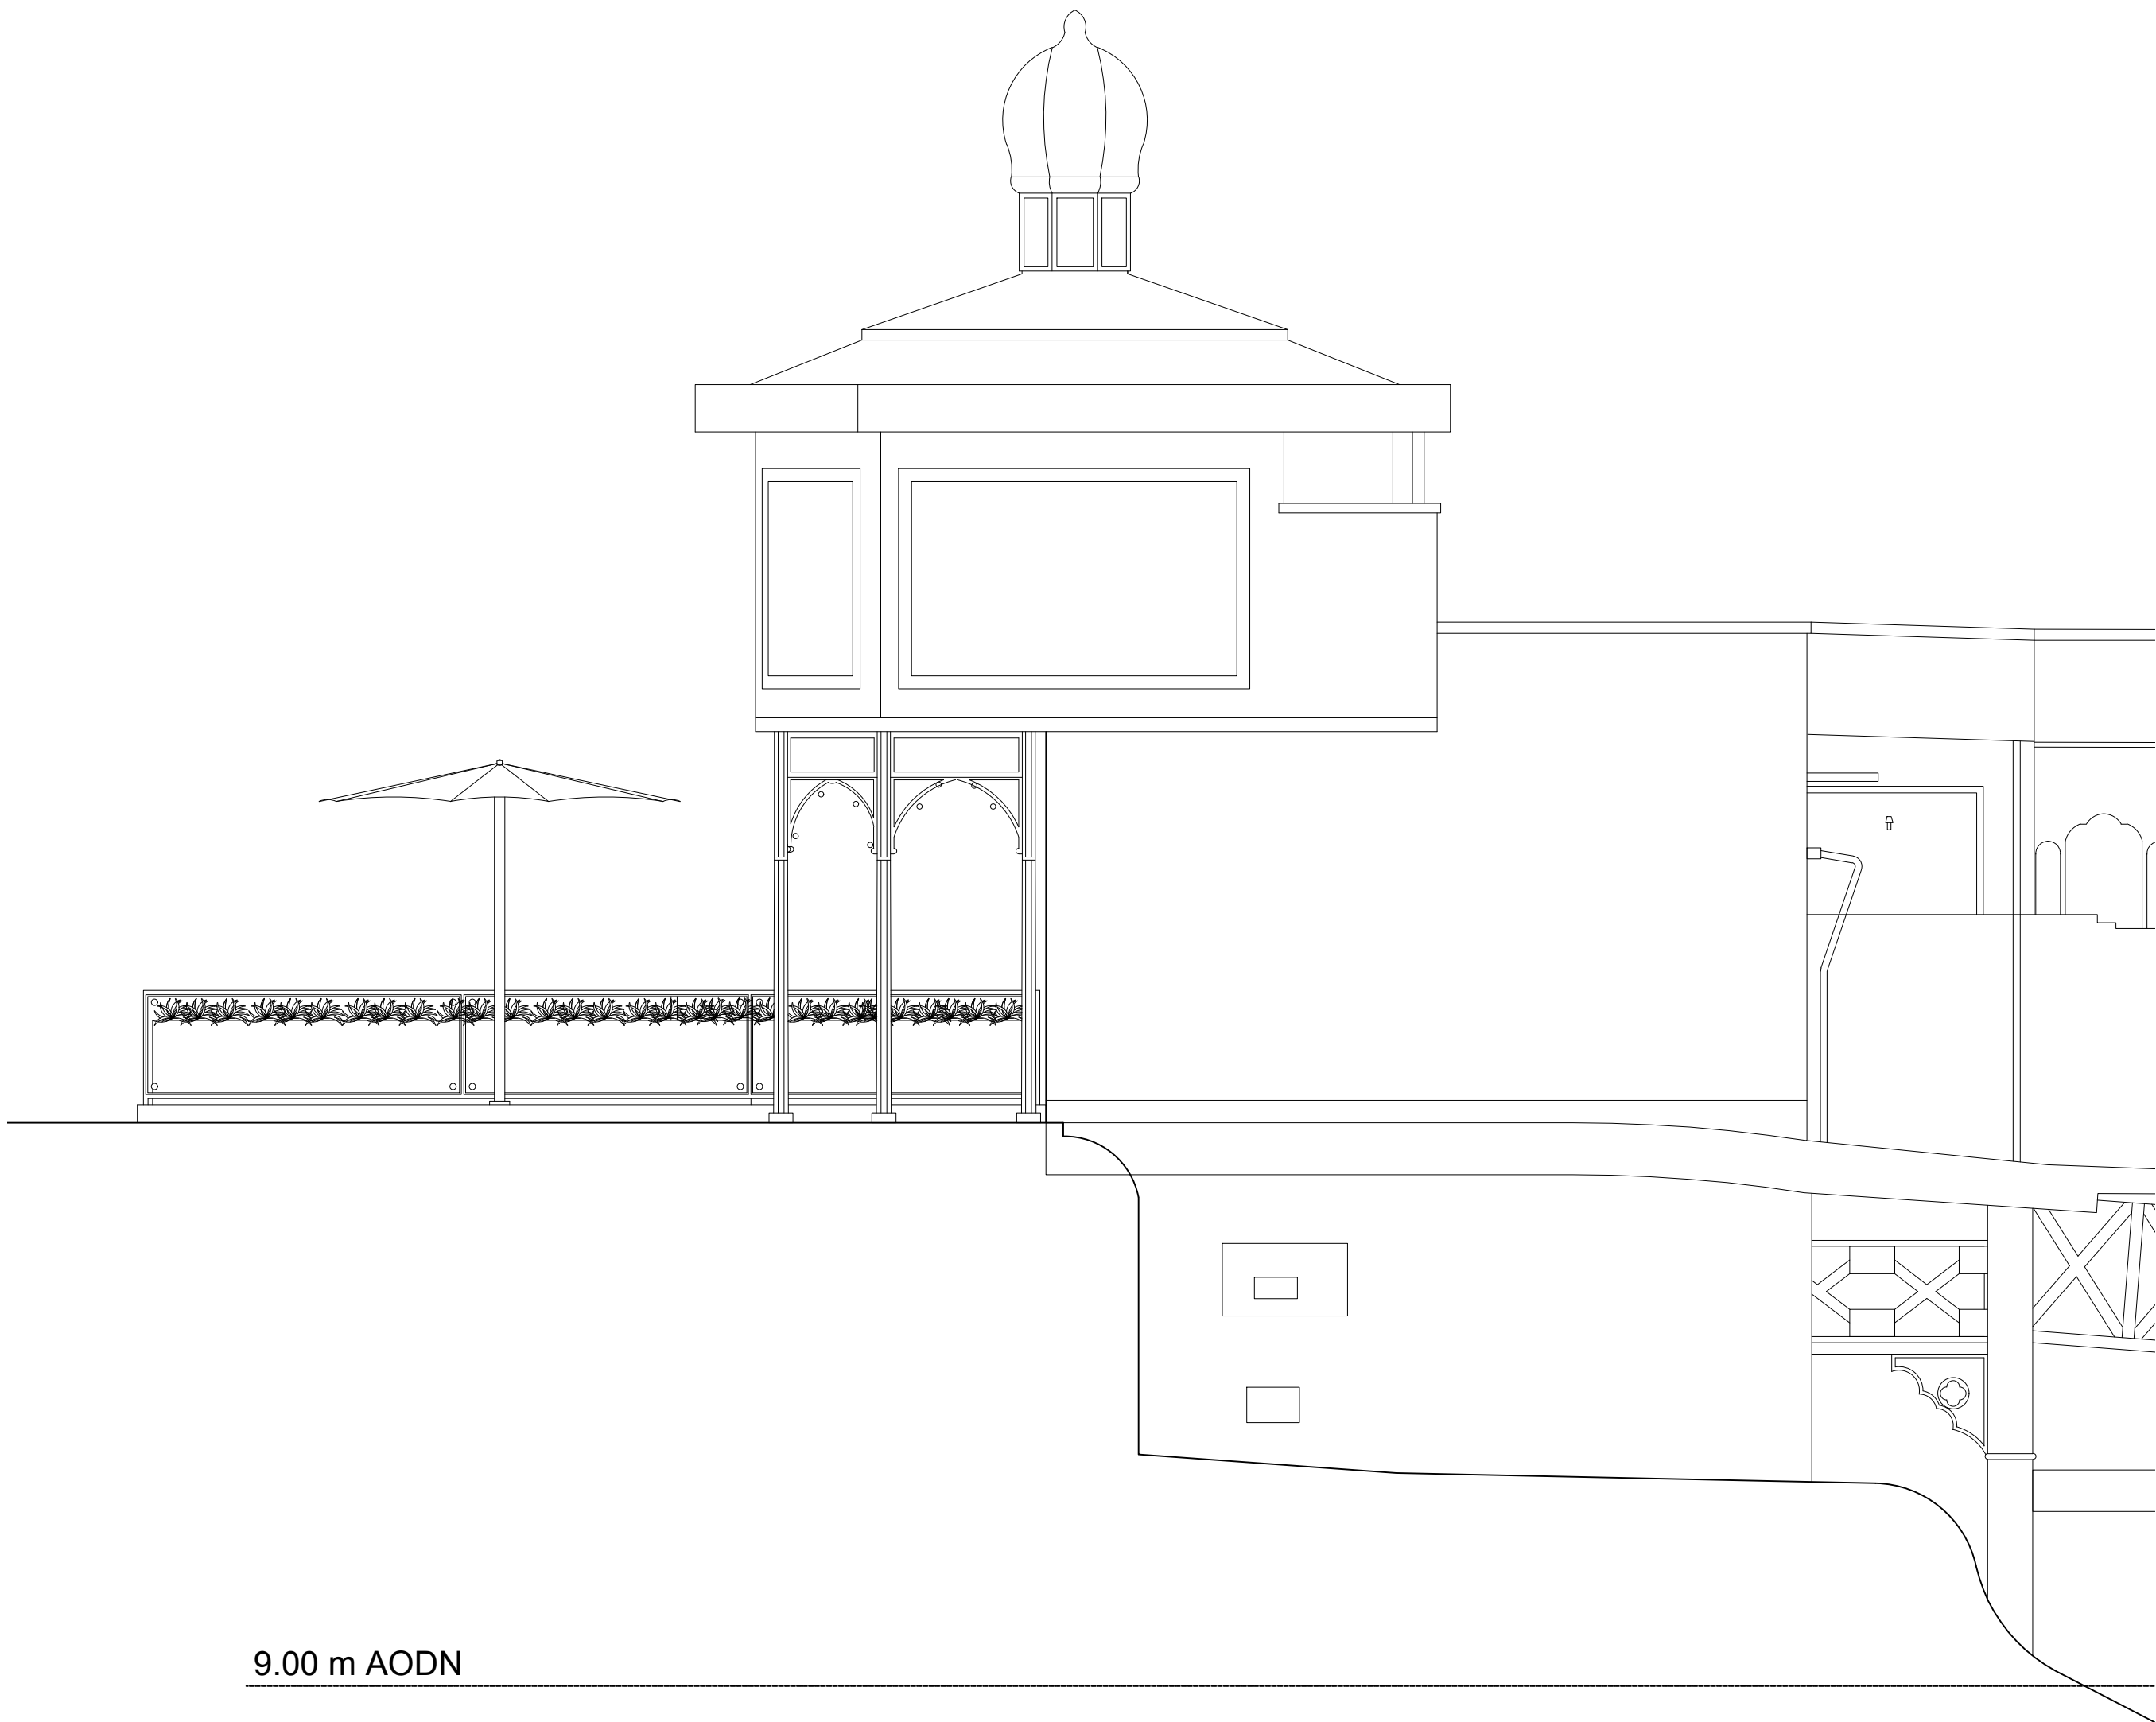

Proposed Side Elevations- 1:50

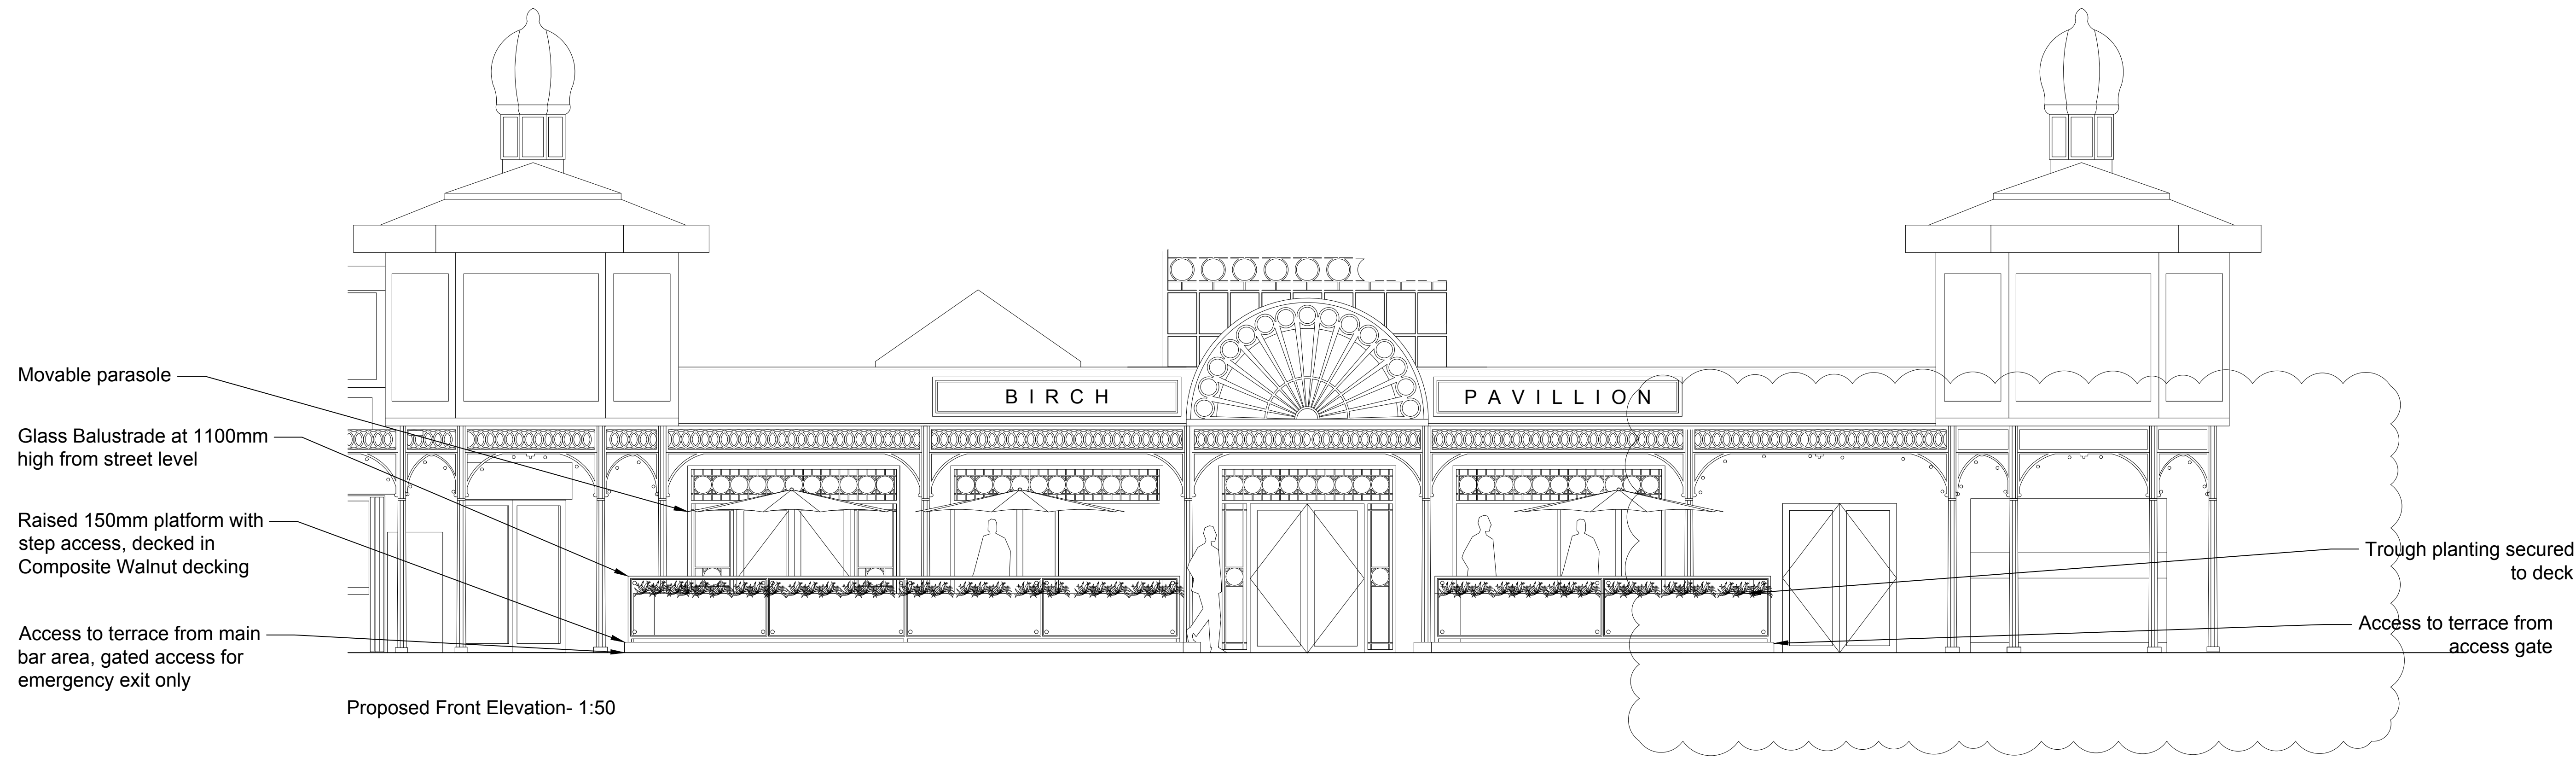

Proposed Front Elevation- 1:50

This drawing must not be scaled. Discrepancies are to be reported to the Architect immediately. All dimensions are approximate and are to be checked on site. All information to be subject to site surveys. This drawing, or any portion of it must not be reproduced without prior consent from the Architect.  
© Joseph Boniface Architects Ltd

**NOTE:**

**This drawing is for Planning purposes only and not to be used for Construction purposes**

B	- Terrace amended.	23/05/25	JB
A	- Fire exit changed	04/09/23	LS/JB
\	- Initial issue.	29/08/23	LS/JB
Rev.	Amendment	Date	By/Chk



Joseph Boniface Architects Ltd RIBA Chartered Practice	
01253 280 485 bonifacearchitects.co.uk office@bonifacearchitects.co.uk 62 Counce Street, Blackpool, FY1 3LA.	
Project Merrie England Internal and External Refurbishment, North Pier, Blackpool, FY1 1RA.	
Client Blackpool Pier Company Limited	
Drawing Title Proposed Floor plans and Elevations for External Terrace	
Status PLANNING	
Scale AS INDICATED @ A1	
Drawn By LS	Date 29/08/2023
Drawing Number JBA572-PL-019	Revision B