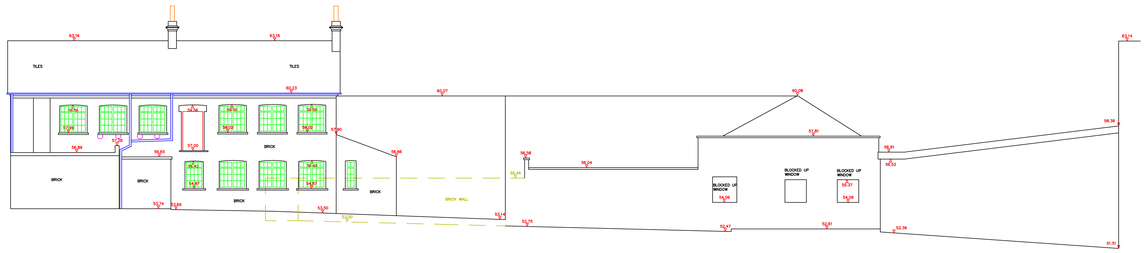

ELEVATION E

DATUM LINE 48.00m

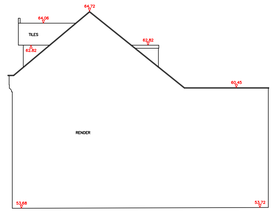

ELEVATION F

DATUM LINE 48.00m

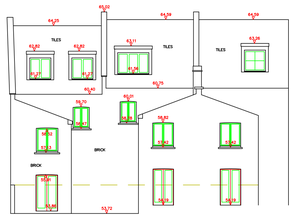

ELEVATION G

DATUM LINE 48.00m

ELEVATION H

DATUM LINE 48.00m

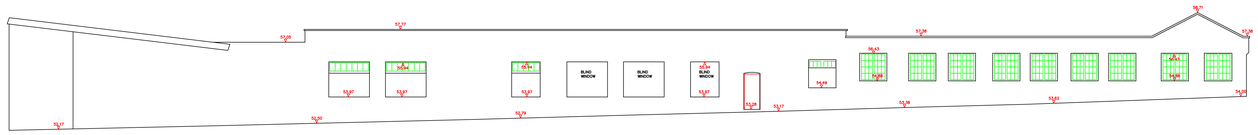

ELEVATION I

DATUM LINE 48.00m

SURVEYED BY:

ENGINEERING LAND & BUILDING SURVEYS
98 MIDDLE STREET
BROCKHAM
SURREY
RH3 7JF

TEL: 01737 844981
FAX: 01737 841540

Job No
B7979

LEGEND

SURVEY STATION
BANKING
HEDGE
FENCE
PROPOSED CELL BOUNDARY

ABBREVIATIONS (WHERE APPLICABLE)

A/C	AIR CONDITIONER	KO	KERB OUTLET
AH	ARCH HEIGHT	L	LIGHT
AV	AIR VALVE	LP	LAMP POST
B	BOLLARD	MP	MANHOLE
BH	BEAM SOFFIT	MKR	MARKER
BH	BEAM SOFFIT HEIGHT	NOB	NOTICE BOARD
BL	BEAM SOFFIT LEVEL	NF	NO FURTHER
BW	BRICK WALL	NFI	NO INFORMATION
CH	WINDOW CILL HEIGHT	O/H	OVERHEAD
CE	CLEARING EYE	P	POST
1.90F	CEILING HEIGHT	PL	PAVEMENT LIGHT
CL	CENTRE LINE	PM	PARKING METER
CL	COVER LEVEL	R	ROOF
CM	CABLE MARKER	(R)	FROM RECORDS
CONC	CONCRETE	RG	ROAD GULLY
CP	CATCH PIT	RS	ROAD SIGN
CPS	CONCRETE PAVING SLABS	RSJ	RAILWAY SLEEL JOIST
D	DEPTH	RW	RETAINING WALL
DH	DOOR HEIGHT	RWP	RAIN WATER PIPE
DP	DRAIN PIPE	S	SPIGOT
E	EARTHING POINT	SC	SOIL STACK
ECP	ELEC CABLE PIT	SKL	SKYLIGHT
EJB	ELEC JUNCTION BOX	SL	SUMP LEVEL
EP	ELECTRICITY POLE	SP	SPRING POINT HEIGHT
F	FENCE	SV	STOP VALVE
FB	FLOWER BED	TC	TELEPHONE IC
FH	FIRE HYDRANT	TJB	TEL JUNCTION BOX
FIG	FIXED INTO GROUND	TL	THRESHOLD LEVEL
FL	FLOOR LEVEL	TP	TELEPHONE POLE
G	GRATED EARTH	TR	TELEPHONE RISER
GV	GAS VALVE	UTL	UNABLE TO LIFT
H	WINDOW HEAD HEIGHT	UTT	UNABLE TO TRACE
H	HEIGHT	VP	VENT PIPE
HB	HAND BASIN	W	WALL
HD	HEATING DUCT	WC	WATER CLOSET
IC	INSPECTION COVER	WM	WATER METER
IL	INVERT LEVEL		

FENCE TYPES AND DETAILS

B/W	BARBED WIRE
C/B	CLOSE BOARDED
C/I	CORRUGATED IRON
C/L	CHAIN LINK
C/P	CHESTNUT PALING
H/R	HAND RAIL
I/R	IRON RAILINGS
O/B	OPEN BOARDED
P/R	POST & RAIL
P/W	POST & WIRE
S/W	SHEEP WIRE
W/M	WIRE MESH

NOTES

DATUM USED:

SURVEY CONTROL ESTABLISHED USING GPS

THIS SURVEY DATA WAS BEEN PREPARED FOR THE CLIENT DETAILED BELOW TO AN AGREED SPECIFICATION. UNLESS OTHERWISE AGREED IN WRITING THE LIABILITY OF ENGINEERING LAND & BUILDING SURVEYS IS LIMITED TO THE CLIENT OR HIS APPOINTED AGENT AND DOES NOT EXTEND TO USE BEYOND THE LIMITATIONS OF THE SPECIFICATION.

REV. SUFFIX	DATE	INITIAL	REVISION DETAILS

HORDEN CHERRY LEE ARCHITECTS
36–38 BERKELEY SQUARE
LONDON
W1J 5AE

JOB TITLE
11 BLACKBURN ROAD
WEST HAMPSTEAD
LONDON NW6 1RZ

DRAWING TITLE
ELEVATIONS
SHEET 2

JOB No.	DRAWING No.
SHEET SIZE: A0	REVISION SUFFIX: 0
SCALE: 1:100	DATE: OCT 2014
DRAWN: PRC	CHECKED: PRC