

INDICATIVE ONLY


NOTES

- 1) ALL DIMENSIONS TO BE CHECKED ON SITE AND NOT SCALED FROM THIS DRAWING.
- 2) HOLLIS SHALL BE INFORMED IN WRITING OF ANY DISCREPANCIES.
- 3) ALL DIMENSIONS ARE IN METRES ONLY.
- 4) THE ORIGIN AND ORIENTATION OF THE SURVEY GRID RELATE TO A GPS TIE TO ORDNANCE SURVEY GRID.
- 5) ALL LEVELS ARE BASED ON A GPS TIE TO THE OSGMARS(8) GEOD MODEL.
- 6) HATCHING SHOWN IN OUR DRAWINGS IS FOR VISUAL PURPOSES ONLY.
- 7) LINES SHOWN IN DASH-DOT FORMAT INDICATE THAT THE ELEMENT POSITION IS ASSUMED FROM NEARBY/LIMITED DATA.

KEY

A	Alarm	WB	Hand Room
A/C	Air Conditioner	WB	Handrail
AH	Arch Height	IC	Inspection Cover
AL	Arch Level	IBF	Iron Rolling Fence
ASH	Arch Spring Height	JB	Junction Box
ASL	Arch Spring Level	L	Light
ATM	Automated Teller Machine	LB	Litter Bin
B	Balloon	MZ	Maximum
BGP	Break Glass Point	Min	Minimum
BH	Floor To Beam Height	CH	Overhead
B	Brick	OSF	Open Boarded Fence
BHW	Brick Retaining Wall	OSBM	Ordnance Survey Bench Mark
BLS	Beam Soffit Level	P	Post
BW	Brick Wall	PL	Plaster Light
BWF	Barbed Wire Fence	PPF	Post and Rail Fence
CBF	Close Boarded Fence	PS	Painting Stones
CCTV	Closed Circuit Television	PPWF	Post and Wire Fence
CH	Chimney	Rd	Road
Chy	Chimney	RDH	Recessed Door Mat
CL	Corrugated Iron Fence	R	Rail
CL	Chain Link Fence	RSD	Roller Shutter Door
CLF	Chain Link Fence	RS	Roller Shutter
Col	Column	RWP	Rain Water Pipe With Gully
Conc	Concrete	RWP	Rain Water Pipe
COW	Cable on Wall	SB	Sign Board
CPS	Concrete Paving Slabs	SBM	Site Bench Mark
Cup	Cupboard	SF	Security Fence
DH	Door Height	SH	Spring Height
DP	Down Pipe	SI	Sign Post
DVC	Drainage Channel	SO	Smoke Outlet
DH	Duct Height	SP	Sign Post
EB	Electrical Junction Box	SS	Security Sensor
EGG	Electrical Switchgear	T	Telephone
FA	Fire Alarm	TBM	Temporary Bench Mark
FB	Flower Bed	THL	Threshold Level
FC	Floor To Ceiling Height	Typ	Typical
FE	Fire Extinguisher	U/L	Unable To Lift
FFL	Finished Floor Level	V	Vault
FHB	Fire Hose Reel	VCP	Vehicle Charging Point
FL	Floor Level	VP	Vent Pipe
FR	Floodlight	W	Window
G	Gully	WCL	Window Cill Level
GA	Gas Meter	WH	Water Header
QT	Gas Tap	WNS	Window Head Level
h	Height	WM	Water Meter

FLOOR PLAN SYMBOLS

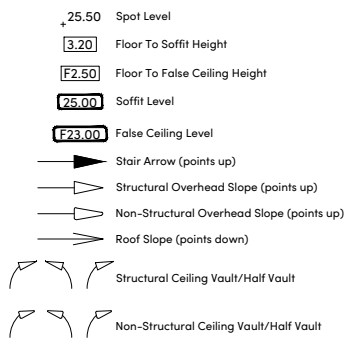

REVISIONS

REV	DATE	AMENDMENTS	INITIAL

THIS DRAWING IS FOR THE FOLLOWING PURPOSE ONLY:
PRELIMINARY ☐ TENDER ☐ CONSTRUCTION ☐
SKETCH ☐ MEASURED SURVEY ☒ CONTRACT ☐

TITLE

DEMOLITION PLAN

CLIENT

Nuveen Real Estate
201 Bishopsgate
EC2M 3AE
London

PROJECT NAME

Unit 4b
Avant Business Centre
Milton Keynes
MK1 1DR

HOLLIS
Sovereign Court
211 Witton Gate East
Central Milton Keynes
MK9 2HP

T +44 1908 774 460
W hollisglobal.com

DATE	24.01.2025	DRAWN BY	BM
SCALE	1:100	CHECKED	MD
PROJECT	LINE	ORIGINATOR	VOLUME/ ZONE/RELDG
127374	104	HLS	00
FILE	DISCIPLINE/ TYPE	NUMBER	STATUS
M2	B	10280	A1

GROUND FLOOR

