
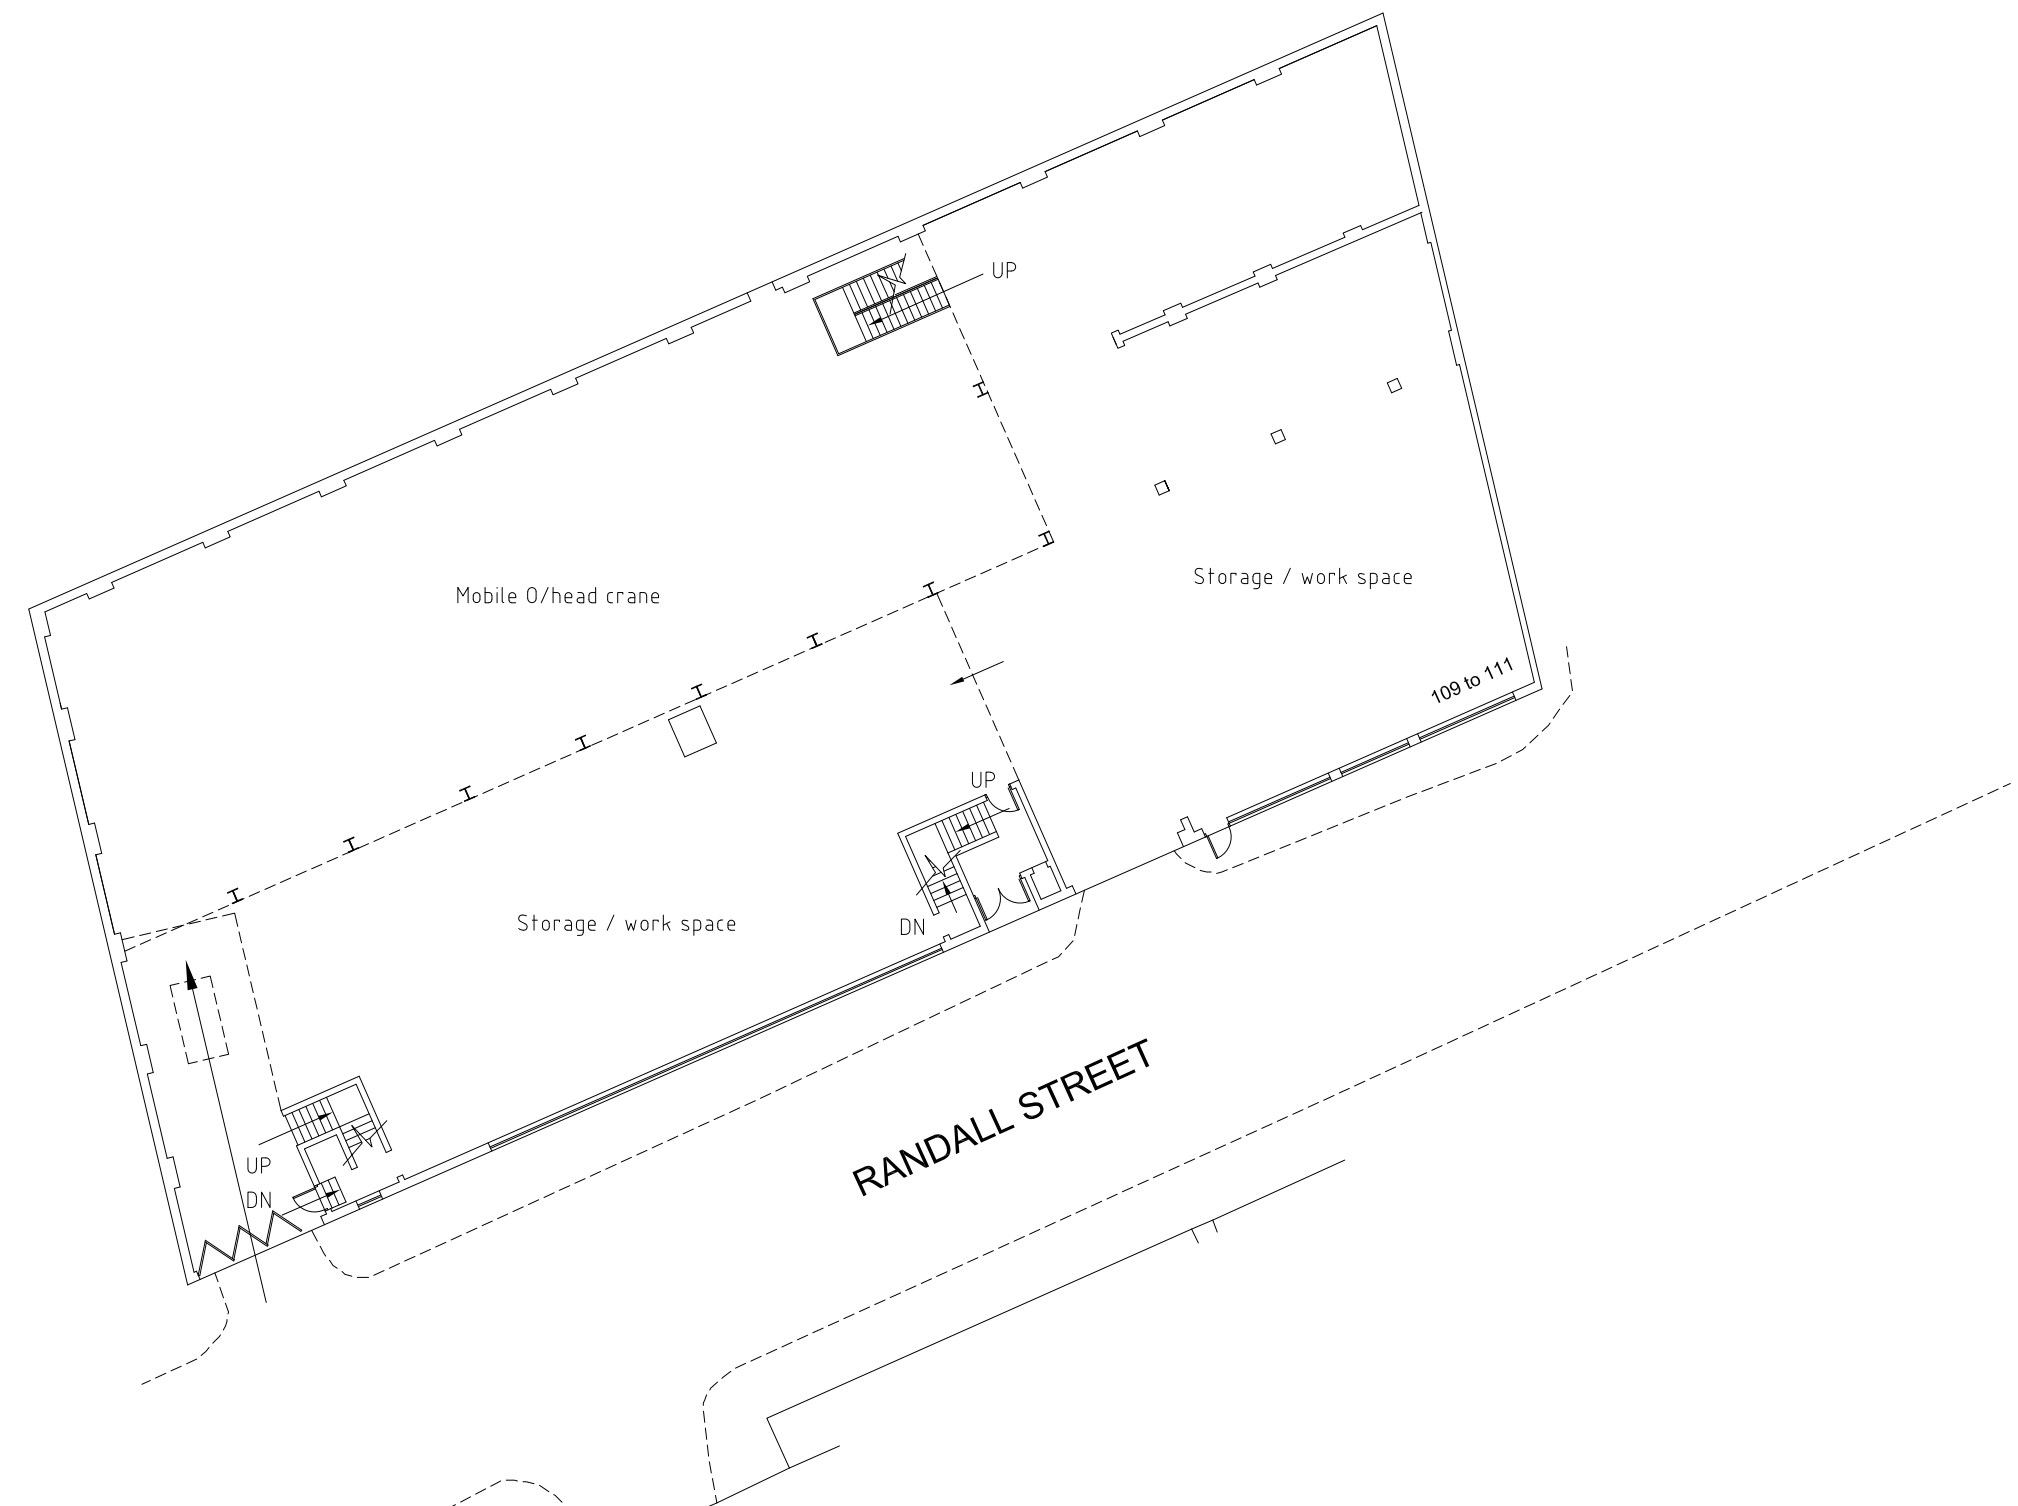


RevNo	Revision note	Date	Signature	Checked
-------	---------------	------	-----------	---------

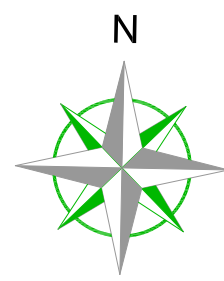

GROUND FLOOR PLAN 1:250

Leica TCR705 / Leica Geo Office Tools		Example
Point ID	Position or point measured	12
Coordinates	Values given to relate to the OS grid (if required)	98.456;116.415
Height	Value given above sea level (if required)	100.032
Stations	Specific control points within data capture	STN A
Code prop	Name specific to a point which is recognised when processing	BRICK W

The survey is carried out to an arbitrary grid and datum unless otherwise specified

ROWLEY SURVEYING
TOPOGRAPHICAL SURVEYS & BUILDING MEASUREMENT

Itemref	Quantity	Title/Name, designation, material, dimension etc			Article No./Reference	
Surveyed by TIM-ROWLEY	Checked by TIM-ROWLEY	Approved by - date TIM-ROWLEY	File name RANDALL	Date JANUARY_2023	Scale 1:250	
12 Forge Road Wales Sheffield S26 5RS 07594 093398		Land Registry Plans Topographical Building Measurement SUAV Images PICO CAA Approved	109-110_RANDALL_STREET SHEFFIELD_SOUTH_YORKSHIRE			
			A3-02	Edition 01	Sheet A3	

