


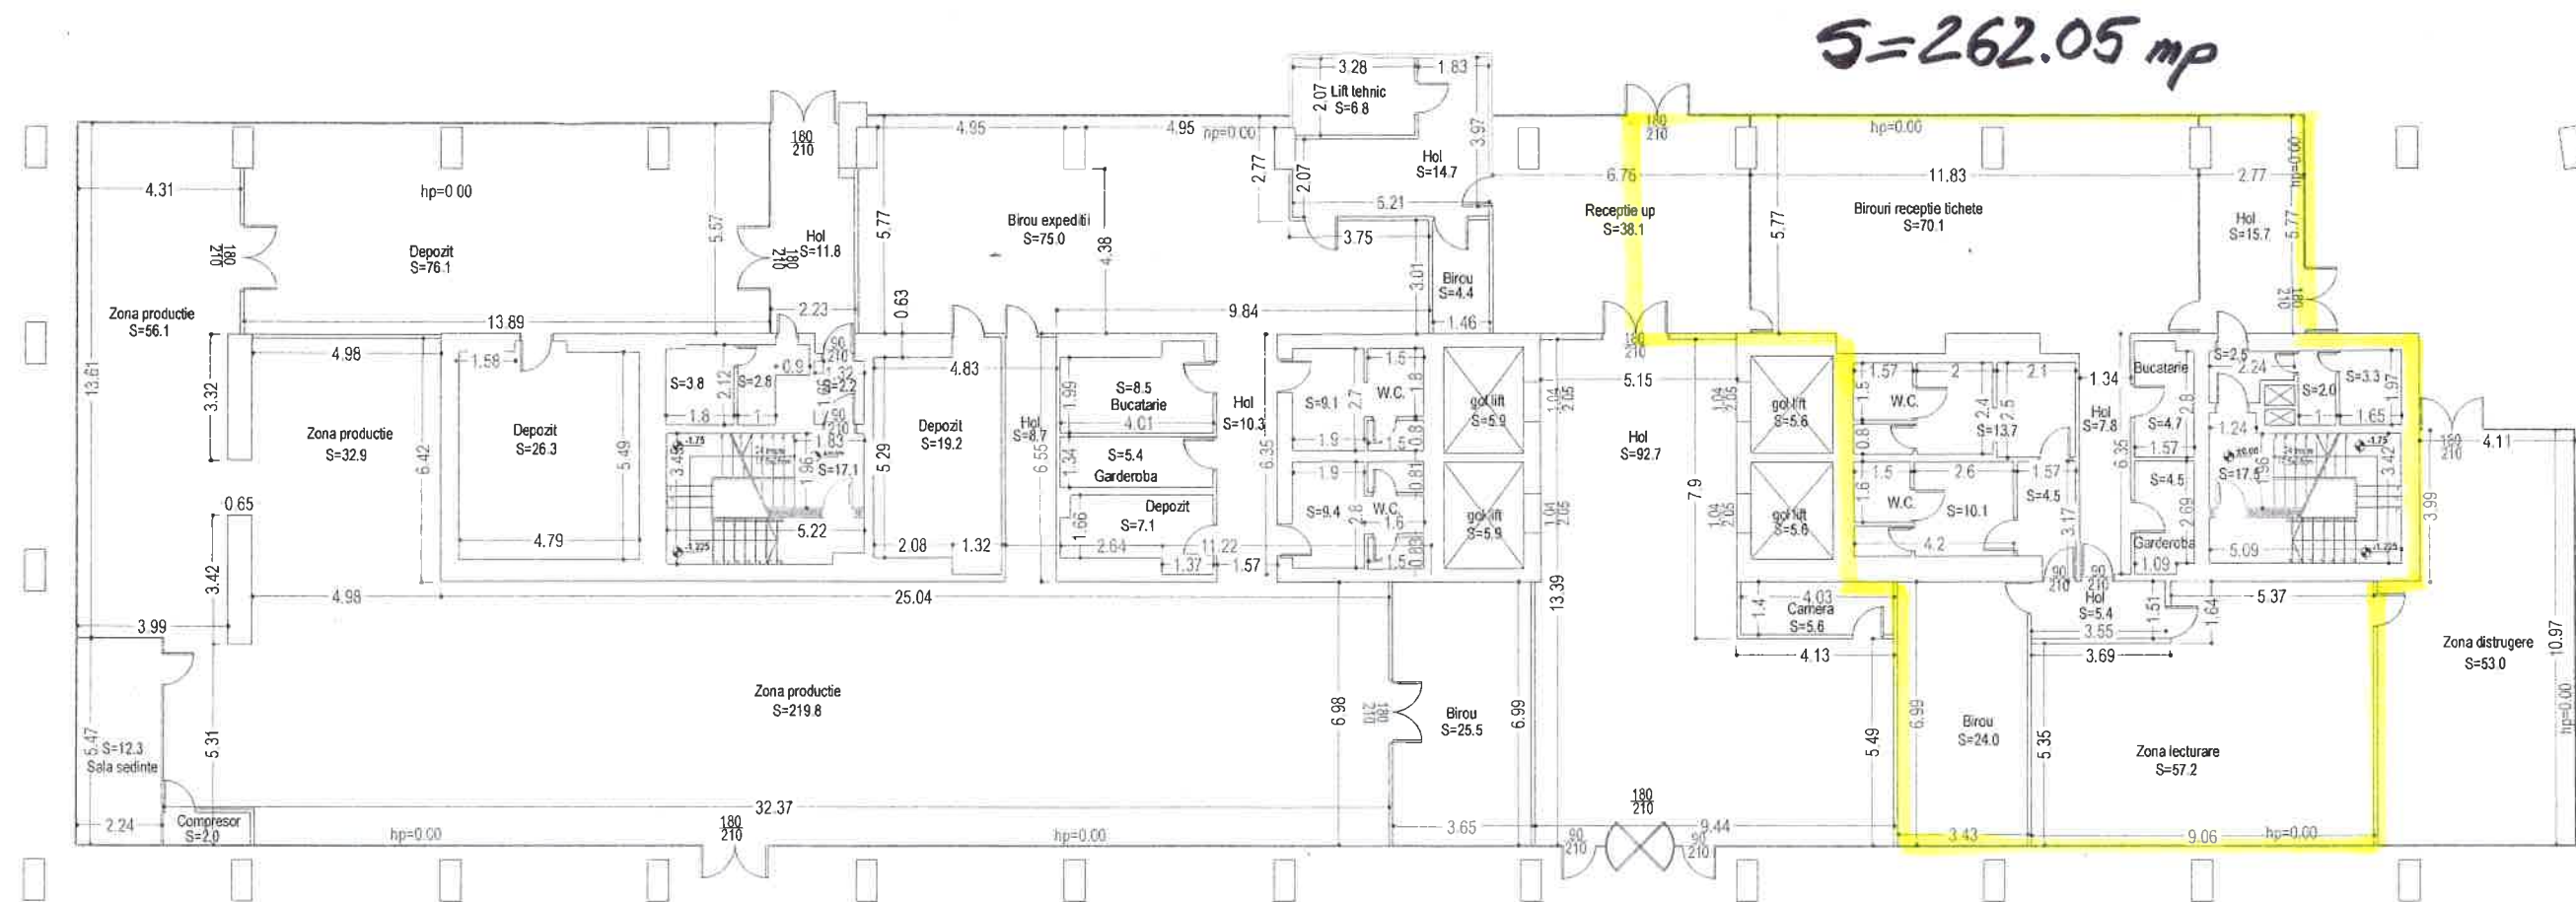

Suprafetele incaperilor reprezinta suprafetele utile calculate in m.p.
 Suprafata construita desfasurata parter (include stalpii exteriori)=1437.8 m.p.
 Suprafata utila parter (nu include lifturi si scari)=1058.3 m.p.

Doru-Alexandru Sarchis
 Doru-Alexandru Sarchis
 RO-B-F NR.0357
 2021.04.27 09:04:59 +03'00'

 Land Survey Consulting Ing. Doru Sarchis - 031 40 181118 Serviciu de proiectare si consultanta in domeniul constructiilor		PLANSĂ
		COMANDA
PROIECTAT Ing. Doru Sarchis DESENAT Ing. Doru Sarchis VERIFICAT Ing. Doru Sarchis SEF COLECTIV Ing. Doru Sarchis APROBAT Ing. Doru Sarchis		SCARA 1:100
		DATA Apr 2021
		RELEVU PARTER Str. Duceș-Panăron nr. 42 sector 2 București
		Beneficiar: RAMIS BUSINESS PARK