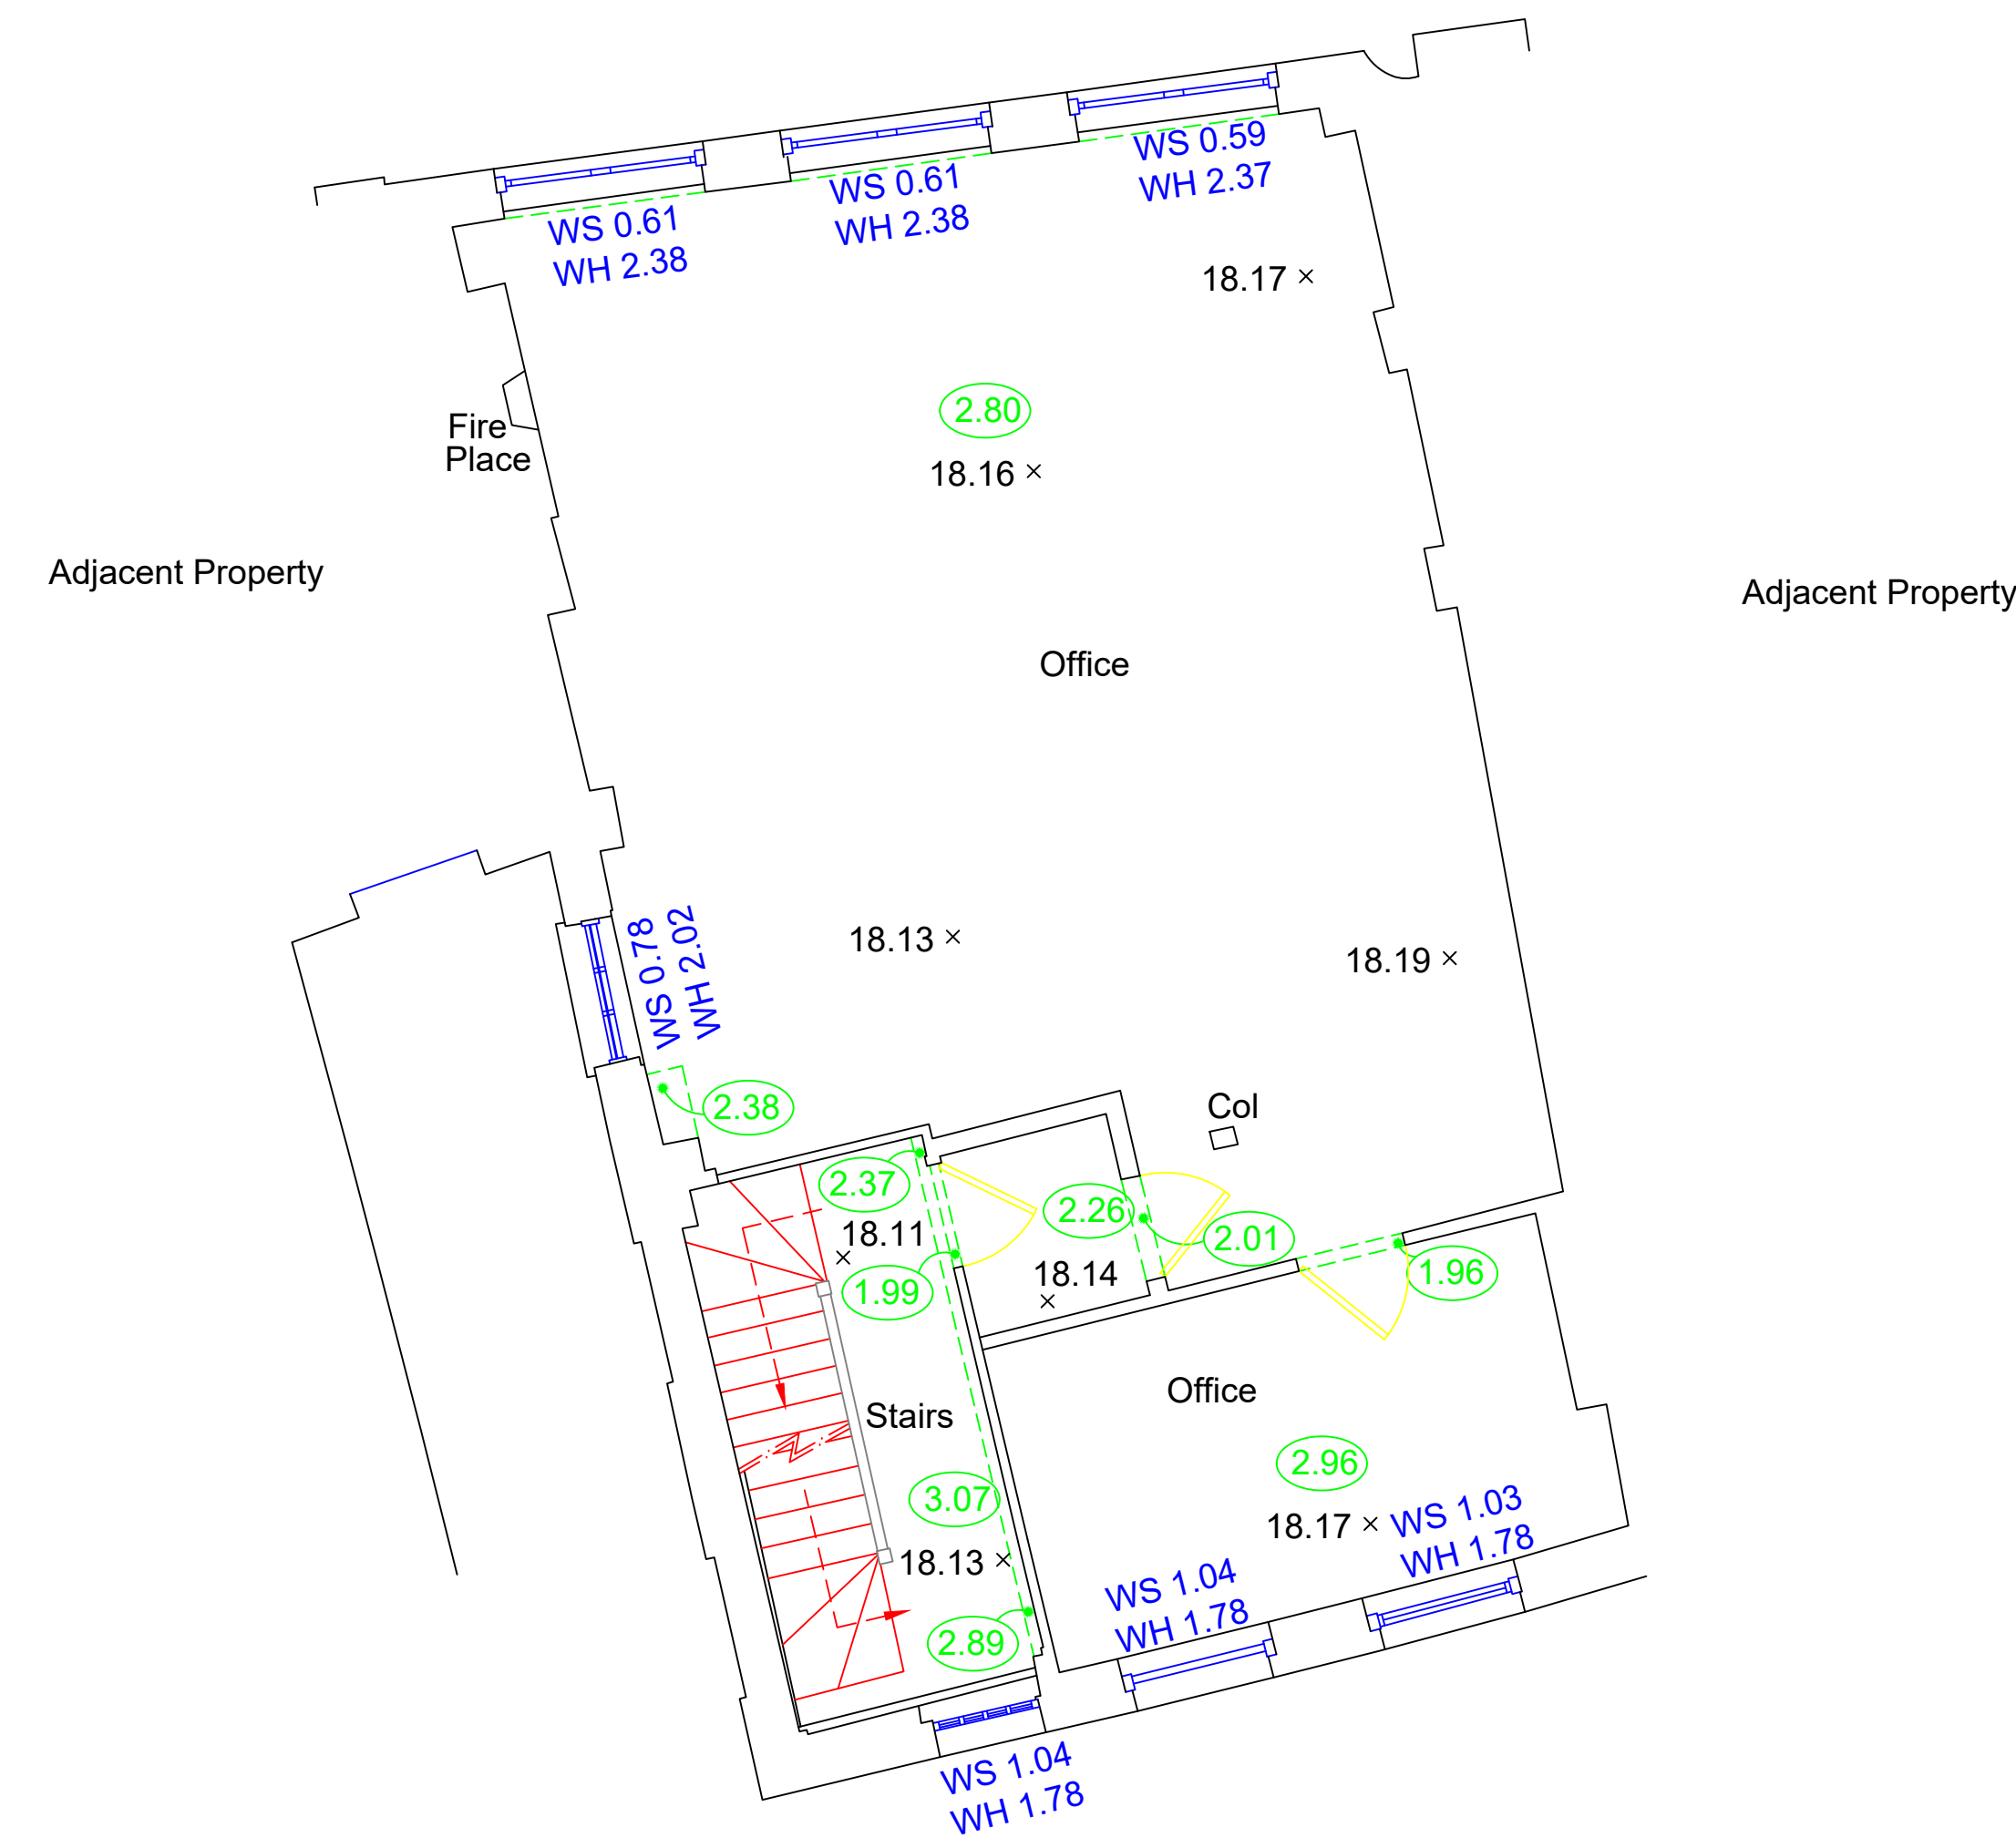


$$\begin{array}{r} 181165 \\ 531320 \end{array}$$


POINT
surveyors