





Basement

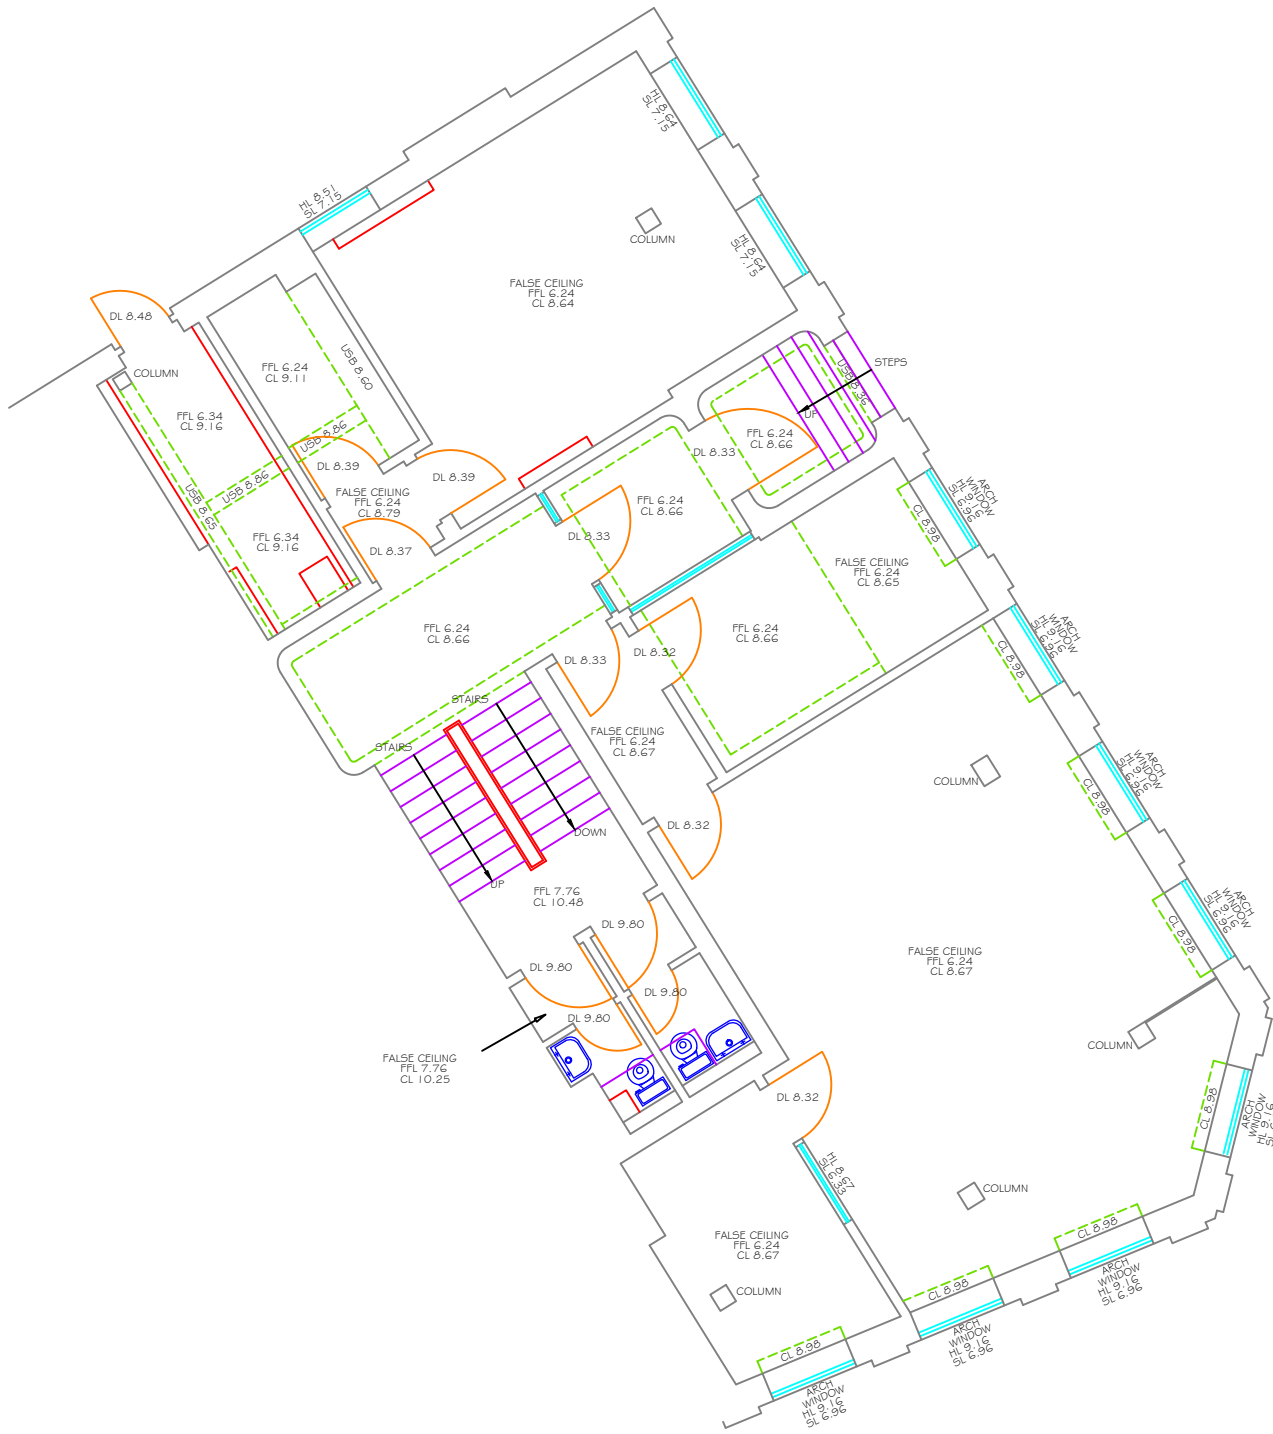

Ground Floor





First Floor

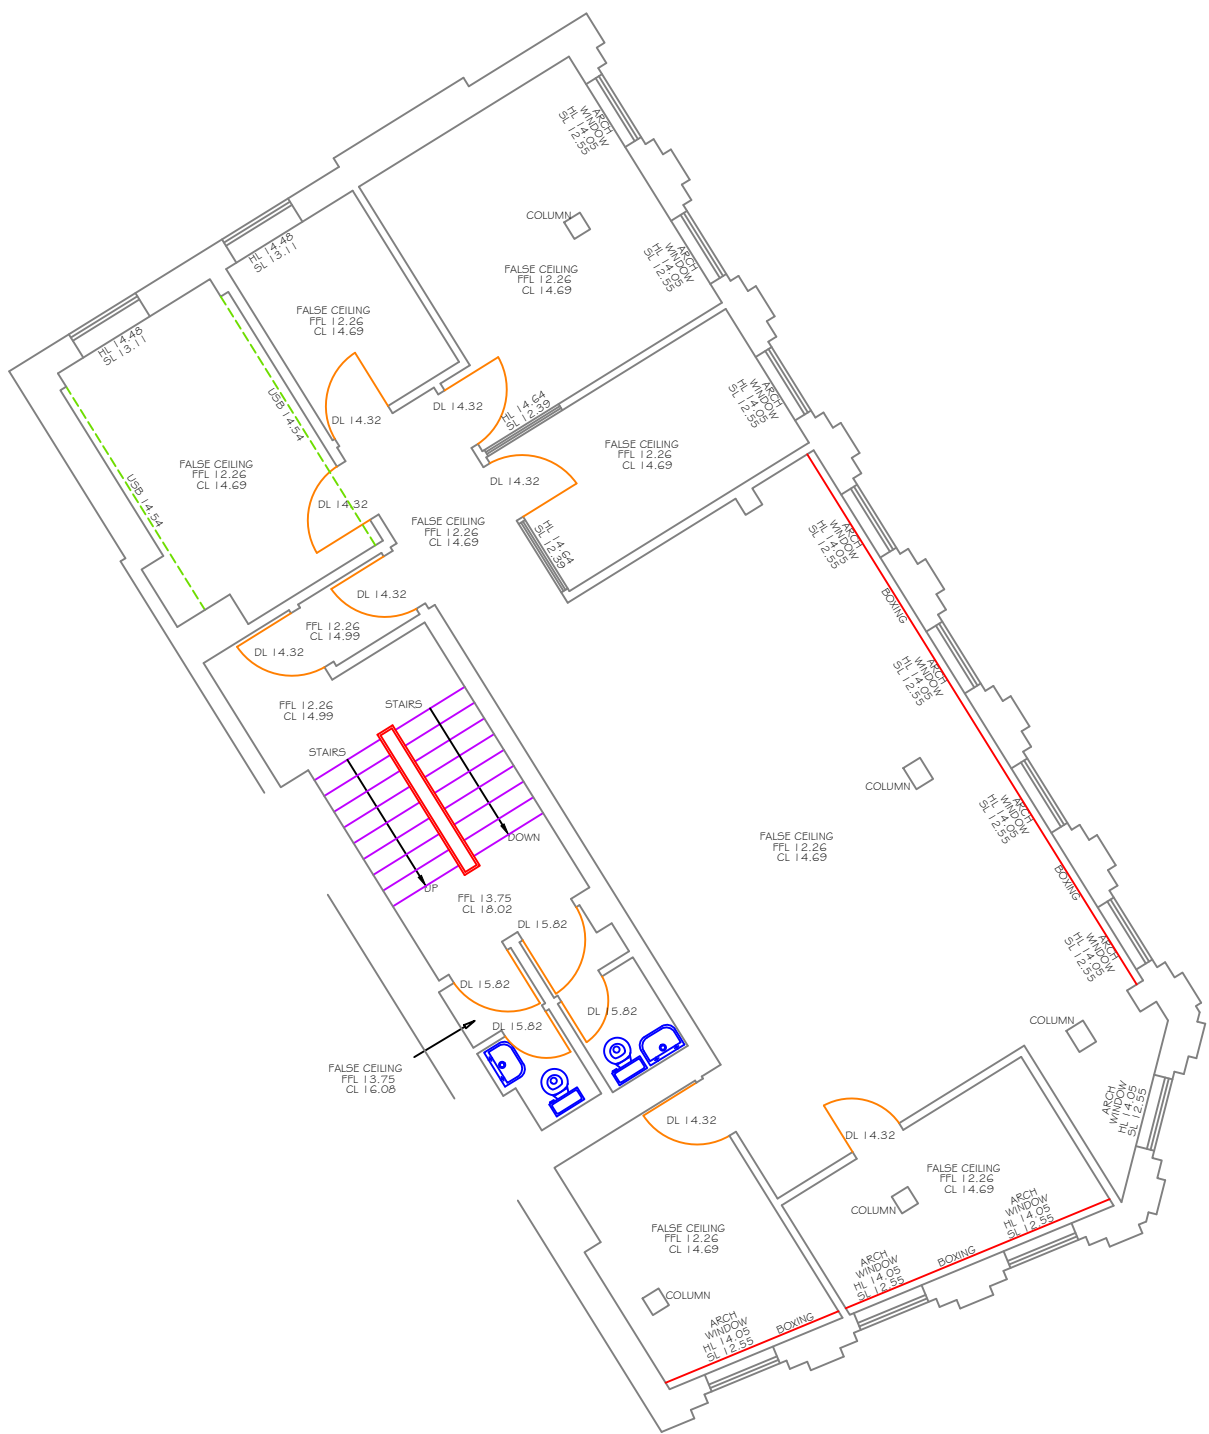

Second Floor



All levels and co-ordinates related to GPS
OSGB36

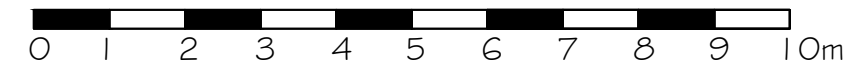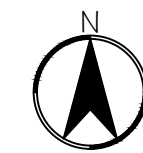

NOTES:
No dimensions are to be scaled from this drawing.
All dimensions are to be checked on site, where
discrepancy occurs between specification and
drawings the supervising officer must be notified.

REV:	DATE:	DESCRIPTION:	CHECK:
------	-------	--------------	--------



DCADD
Digital CAD Dimensions

MEASURED BUILDING SURVEYS
LEASING PLANS
TOPOGRAPHICAL SURVEYS

Business Design Solutions Limited trading as
DCADD Digital CAD Dimensions

The Old Bakery, 5 Vine Hill,
Clerkenwell, London EC1R 5DX
W: www.dcadd.co.uk

PROPERTY:
**104 New Kings Road
London
SW6 4LP**

DRAWING TITLE:
**Basement
Ground Floor
First Floor
Second Floor
As Existing**

SCALE @ A1: 1:100	DATE: 12.12.2023	DRAWN: SJ
	CHECKED: *	

DRAWING NUMBER: 10468-01	REV: *
------------------------------------	------------------



 DATUM




REV:	DATE:	DESCRIPTION:	CHECK:
------	-------	--------------	--------

PROPERTY: 104 New Kings Road London SW6 4LP
DRAWING TITLE: Third Floor Roof Plan As Existing

DRAWING NUMBER: 10468-02	REV: *
------------------------------------	------------------

No dimensions are to be scaled from this drawing
All dimensions are to be checked on site, where
discrepancy occurs between specification and
drawings the supervising officer must be notified.

A compass rose with an arrow pointing North, labeled 'N'. Below it is a scale bar marked from 0 to 10 meters, with alternating black and white segments for each meter.

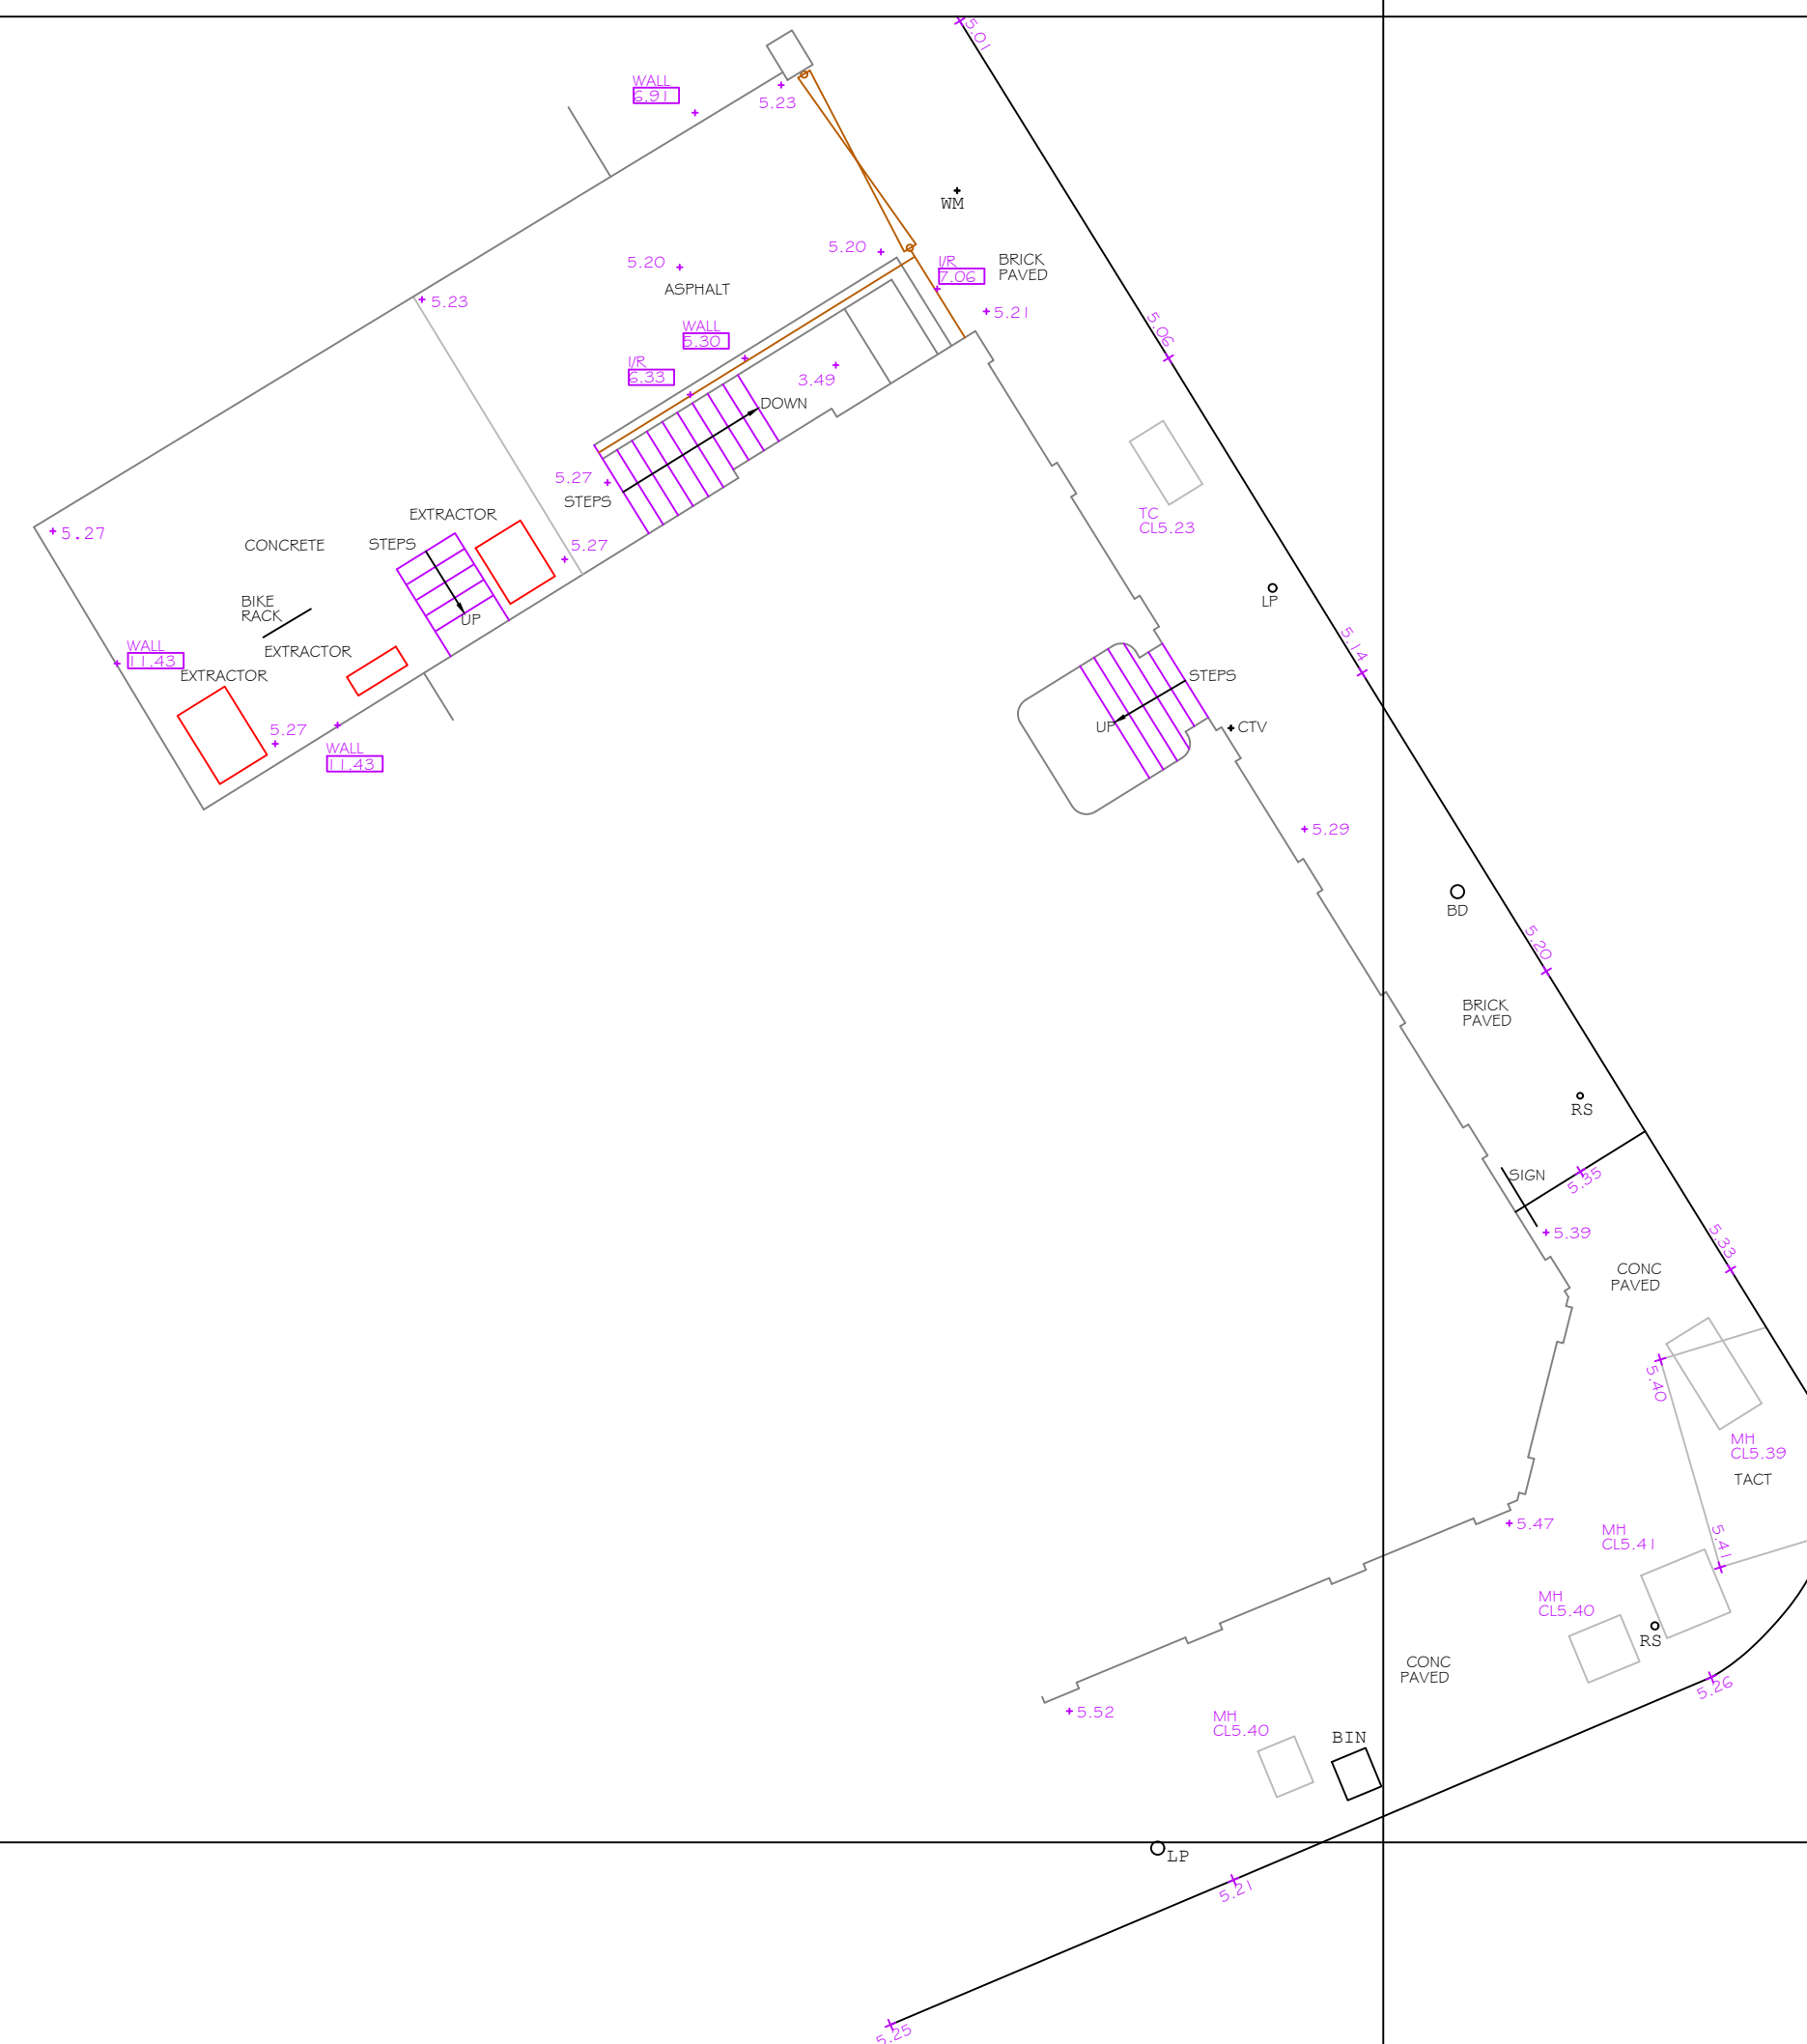

REV:	DATE:	DESCRIPTION:	CHECK:
------	-------	--------------	--------



MEASURED BUILDING SURVEYS
LEASING PLANS
TOPOGRAPHICAL SURVEYS

Business Design Solutions Limited trading as
DCADD Digital CAD Dimensions


The Old Bakery, 5 Vine Hill,
Clerkenwell, London EC1R 5DX
W: www.dcadd.co.uk

PROPERTY:
104 New Kings Road
London
SW6 4LP


DRAWING TITLE:
Site Plan
As Existing

SCALE @ A1: 1:100	DATE: 12.12.2023	DRAWN:	SJ
		CHECKED:	*


DRAWING NUMBER: 10468-03	REV: *
------------------------------------	------------------

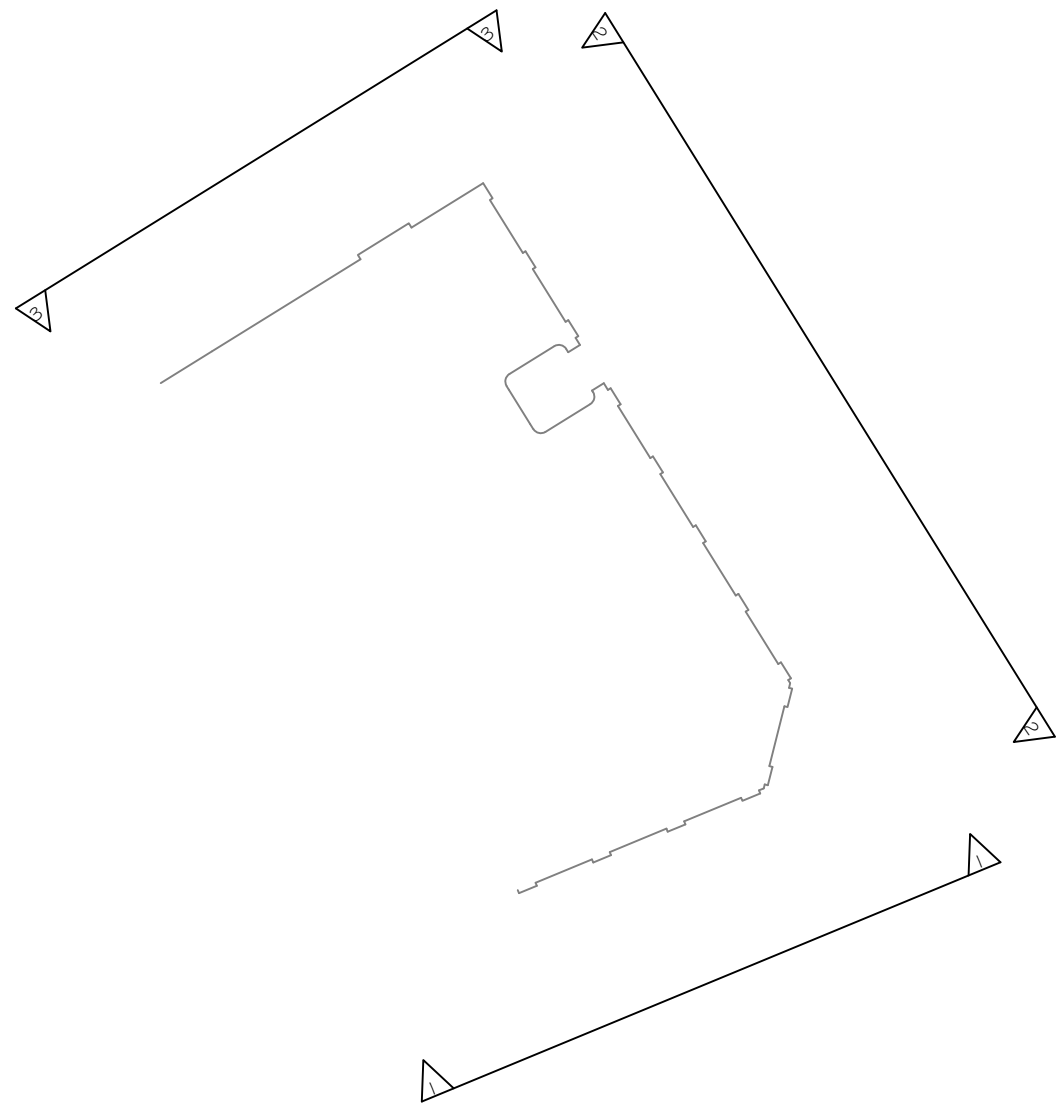

All levels and co-ordinates related to GPS
OSGB36

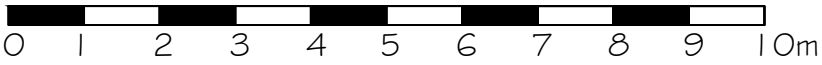

ELEVATION 1

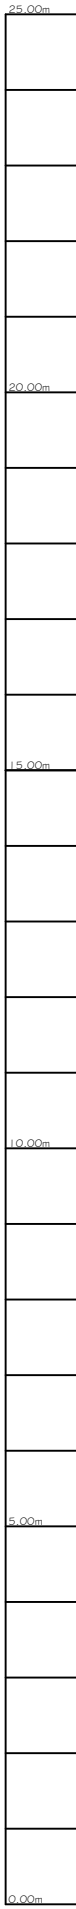

ELEVATION 2



NOTES:
No dimensions are to be scaled from this drawing.
All dimensions are to be checked on site, where
discrepancy occurs between specification and
drawings the supervising officer must be notified.

REV:	DATE:	DESCRIPTION:	CHECK:
------	-------	--------------	--------



MEASURED BUILDING SURVEYS
LEASING PLANS
TOPOGRAPHICAL SURVEYS

Business Design Solutions Limited trading as
DCADD Digital CAD Dimensions


The Old Bakery, 5 Vine Hill,
Clerkenwell, London EC1R 5DX
W: www.dcadd.co.uk

PROPERTY:
104 New Kings Road
London
SW6 4LP

DRAWING TITLE:
External Elevations 1 & 2
As Existing

SCALE @ A1: 1:100	DATE: 12.12.2023	DRAWN: SJ
	CHECKED:	*

DRAWING NUMBER: 10468-04	REV: *
------------------------------------	------------------

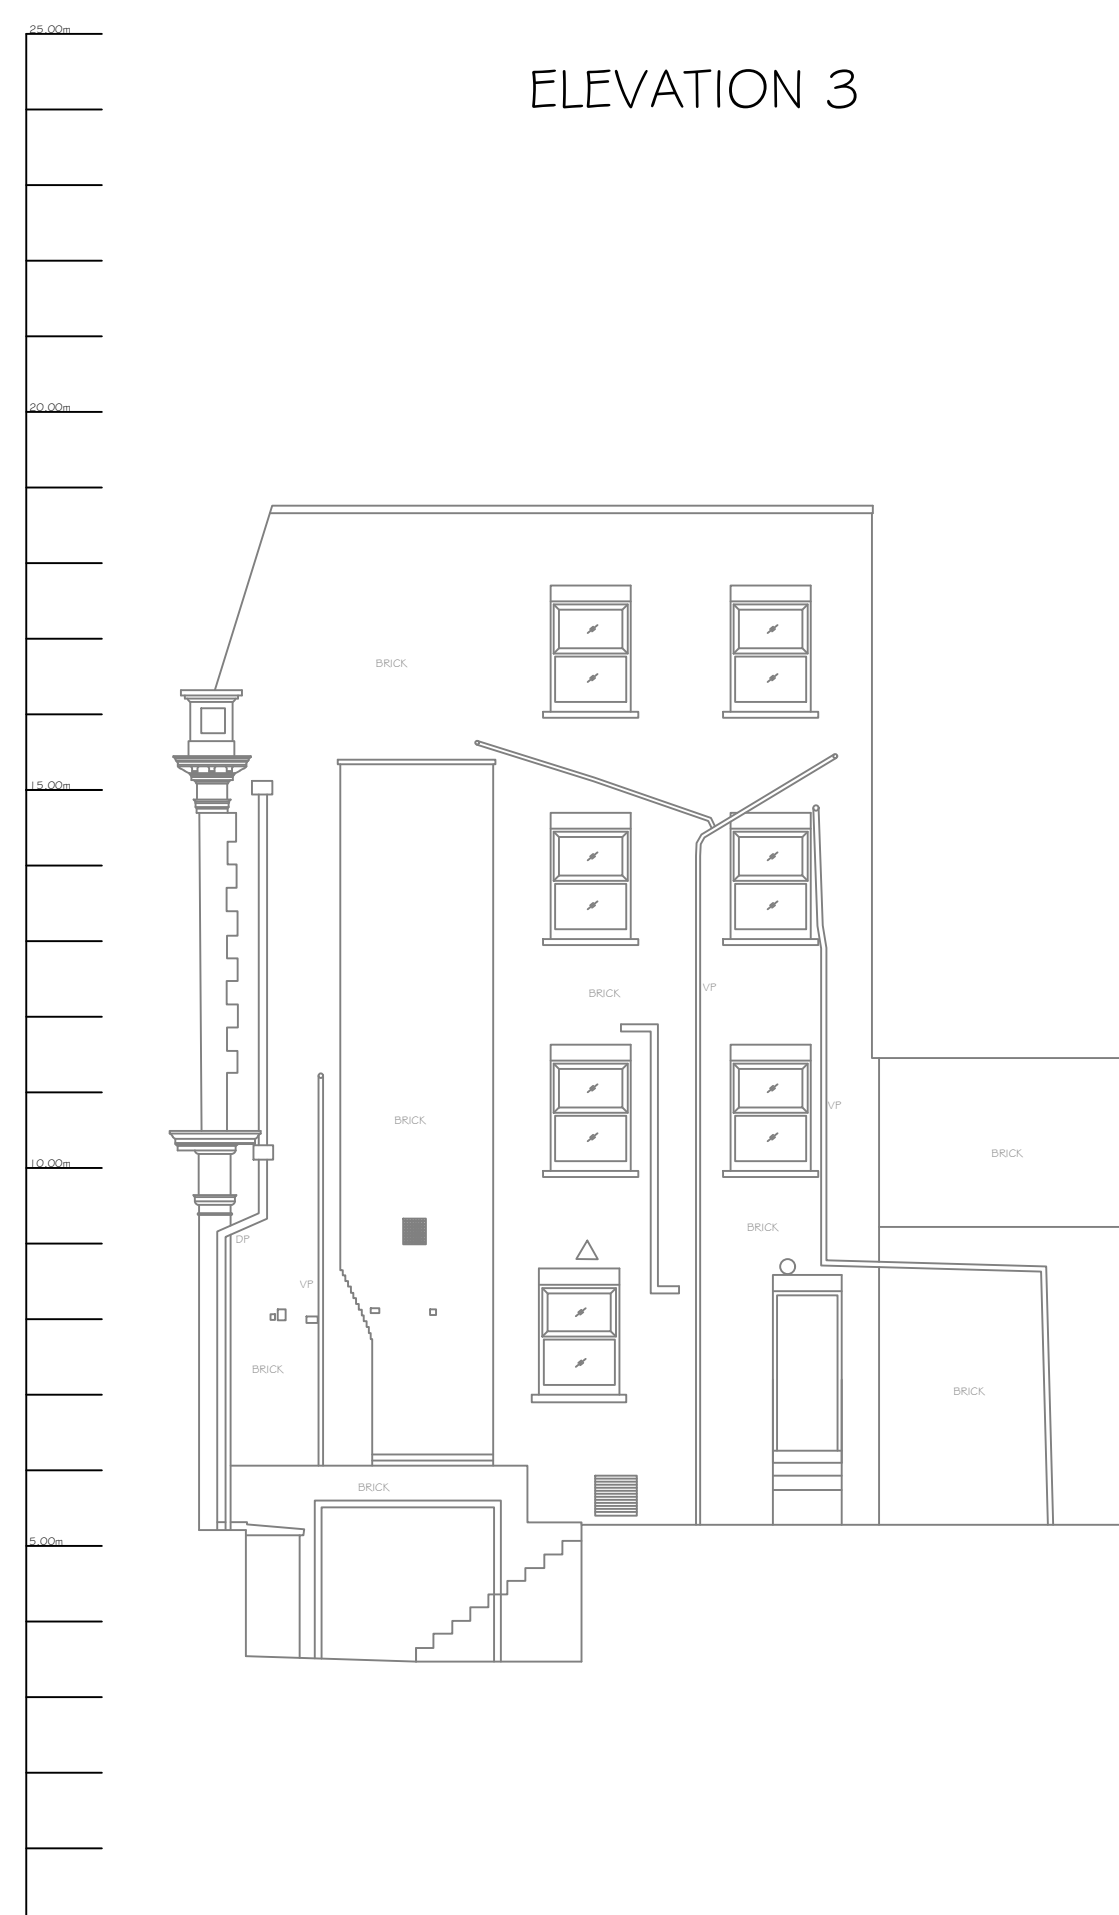

NOTES:
No dimensions are to be scaled from this drawing.
All dimensions are to be checked on site, where
discrepancy occurs between specification and
drawings the supervising officer must be notified.

•	•	•	•
REV:	DATE:	DESCRIPTION:	CHECK:

DCADD
Digital CAD Dimensions

MEASURED BUILDING SURVEYS
LEASING PLANS
TOPOGRAPHICAL SURVEYS

Business Design Solutions Limited trading as
DCADD Digital CAD Dimensions


The Old Bakery, 5 Vine Hill,
Clerkenwell, London EC1R 5DX
W: www.dcadd.co.uk

PROPERTY:
104 New Kings Road
London
SW6 4LP



DRAWING TITLE:
**External Elevation 3
As Existing**

SCALE @ A1: 1:100	DATE: 12.12.2023	DRAWN:	SJ
		CHECKED:	*


DRAWING NUMBER: 10468-05	REV: *
------------------------------------	------------------

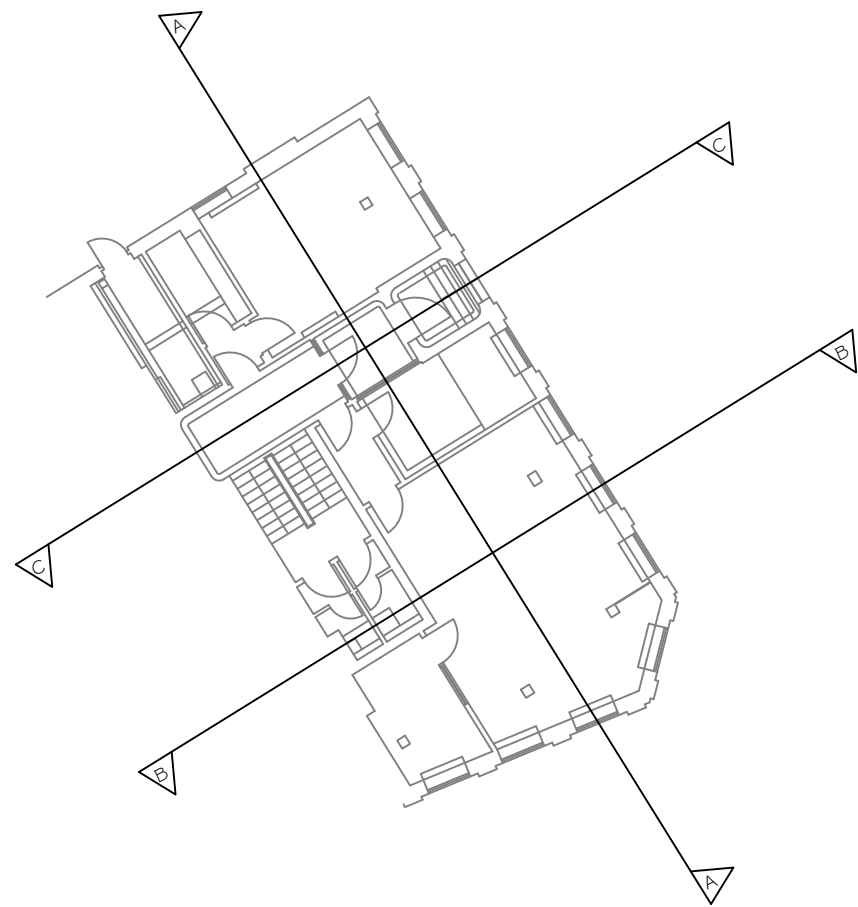

All levels and co-ordinates related to GPS
OSGB36

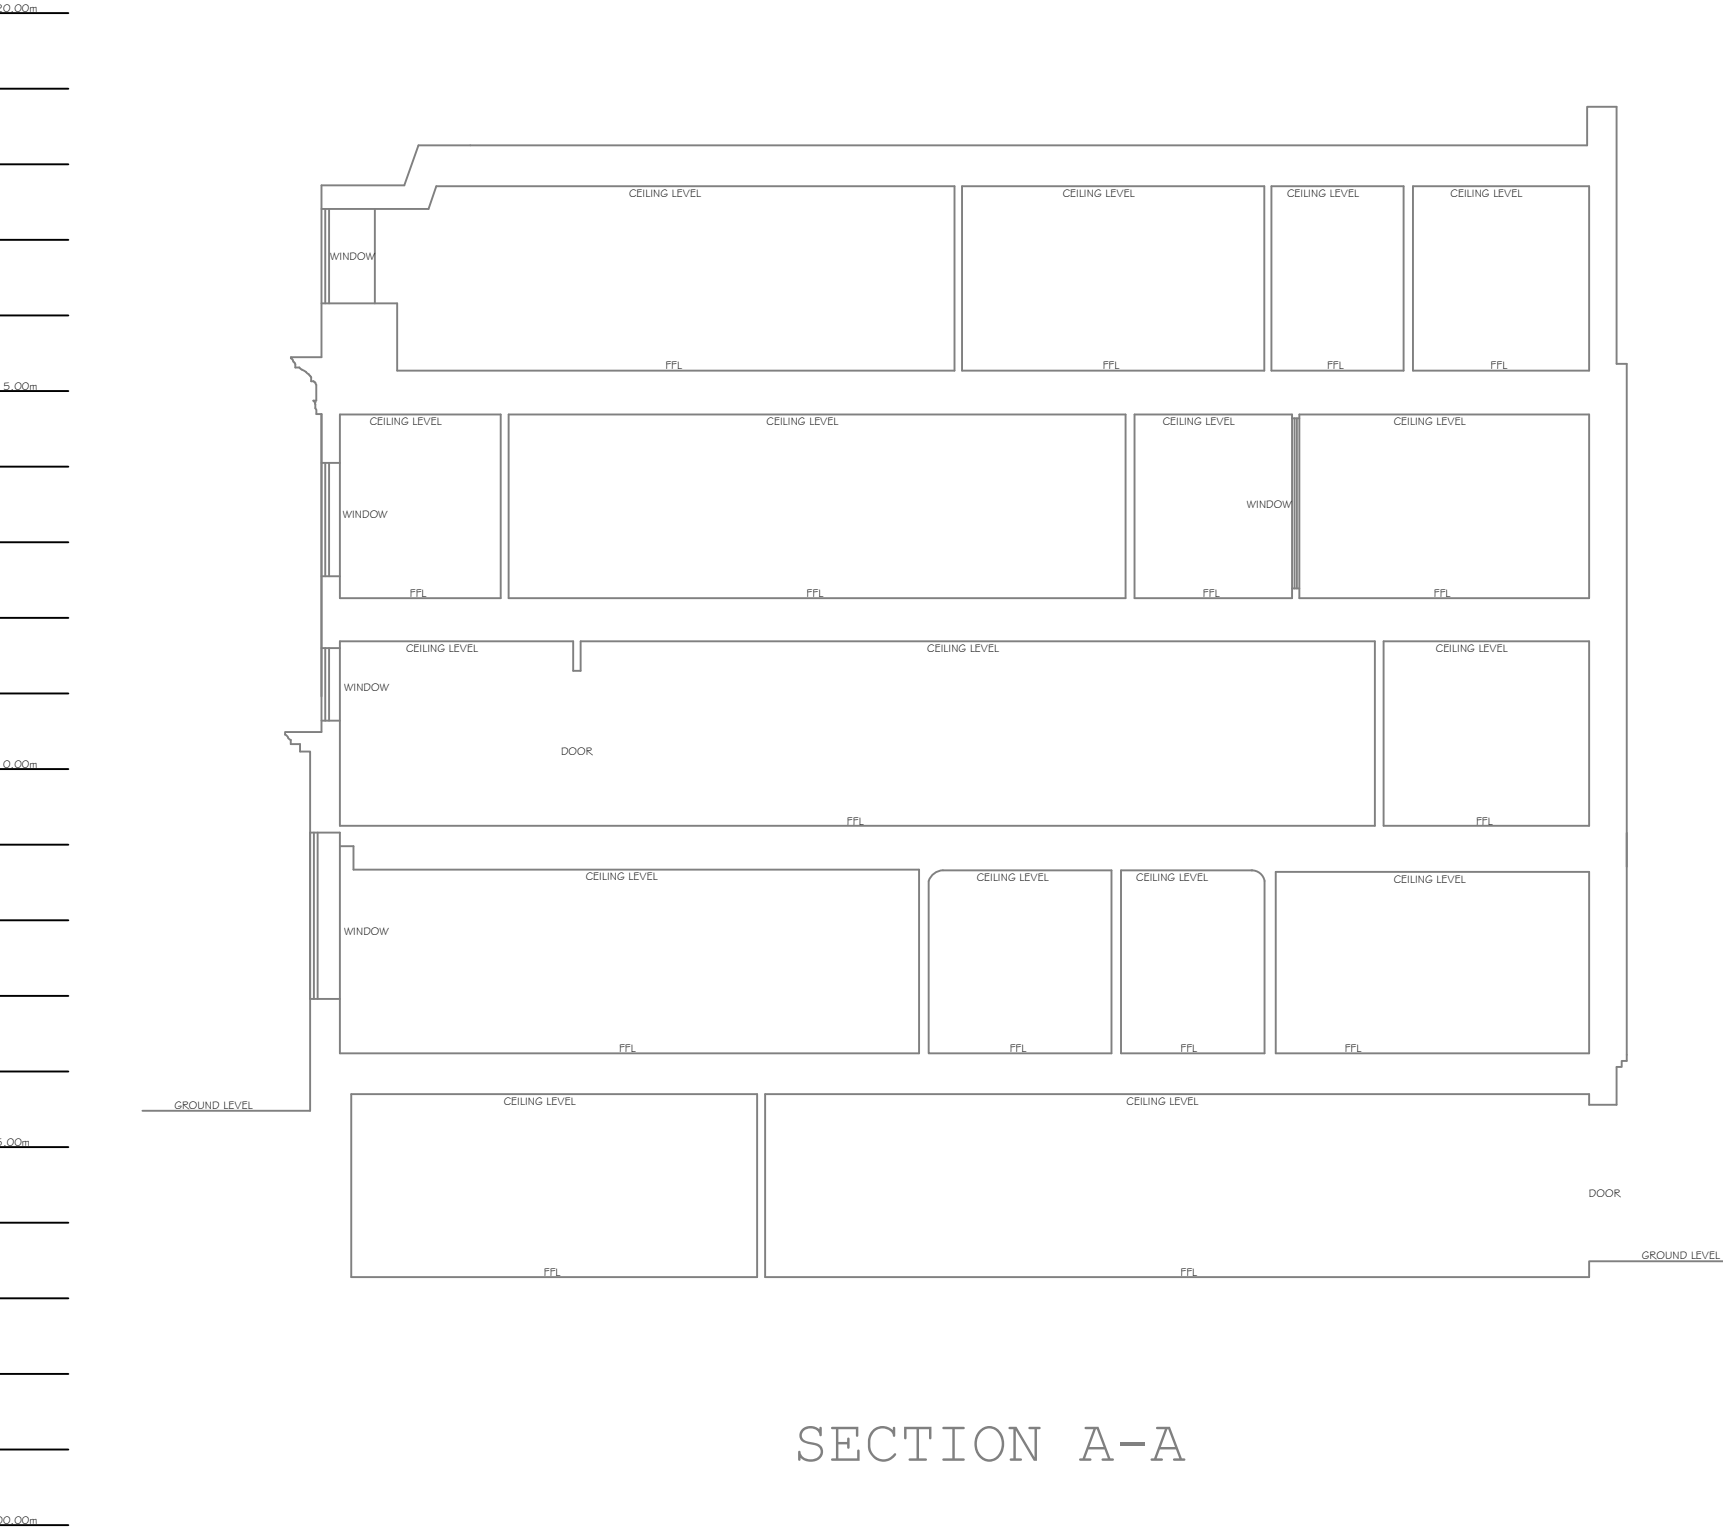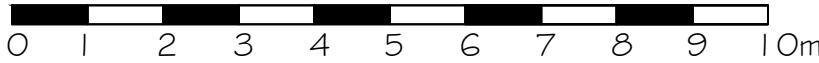

SECTION A-A

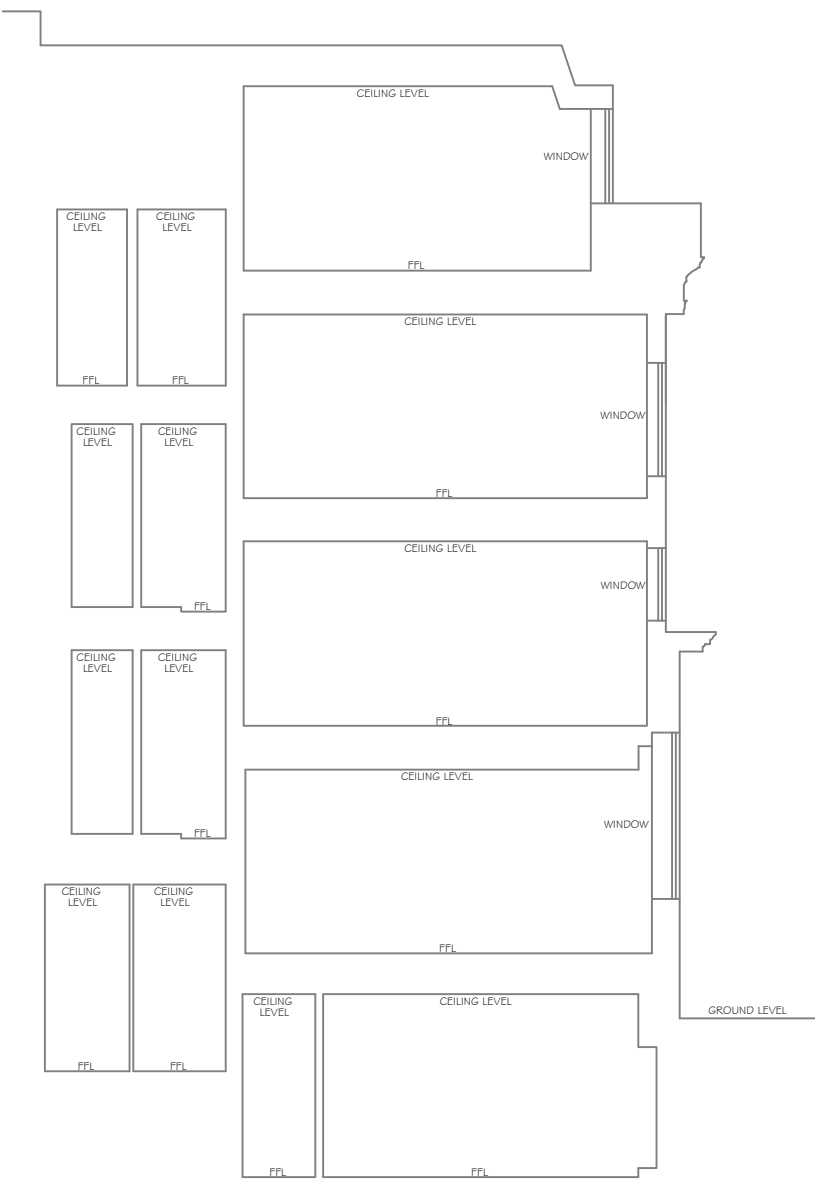

SECTION B-B



SECTION C-C

NOTES:
No dimensions are to be scaled from this drawing.
All dimensions are to be checked on site, where
discrepancy occurs between specification and
drawings the supervising officer must be notified.

REV:	DATE:	DESCRIPTION:	CHECK:
------	-------	--------------	--------



MEASURED BUILDING SURVEYS
LEASING PLANS
TOPOGRAPHICAL SURVEYS

Business Design Solutions Limited trading as
DCADD Digital CAD Dimensions

The Old Bakery, 5 Vine Hill,
Clerkenwell, London EC1R 5DX
W: www.dcadd.co.uk

PROPERTY:
**104 New Kings Road
London
SW6 4LP**

DRAWING TITLE:
**Sections Through
As Existing**

SCALE @ A1: 1:100	DATE: 12.12.2023	DRAWN: SJ
	CHECKED:	*

DRAWING NUMBER: 10468-06	REV: *
------------------------------------	------------------