


Floor plan 1:100

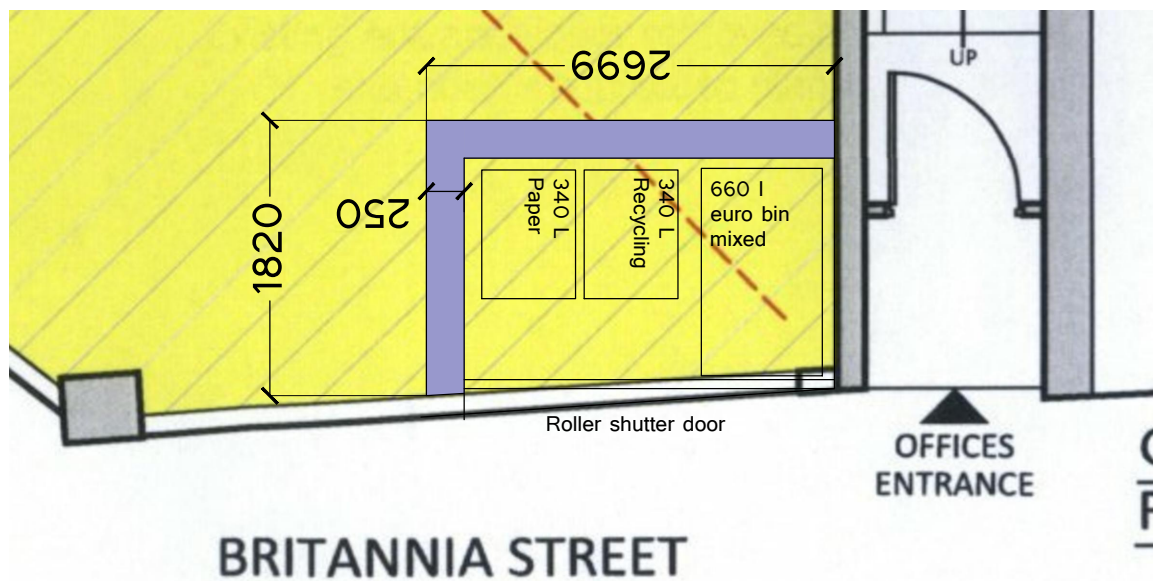

Detail 1:50