




VINYL FLOORING
HERRINGBONE PATTERN

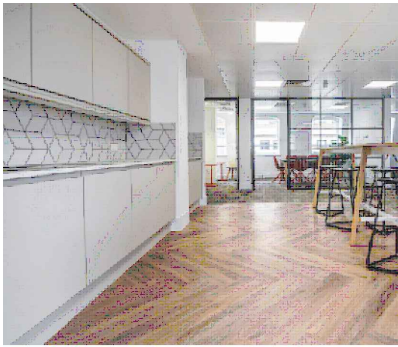


STAFF AREA OPTION

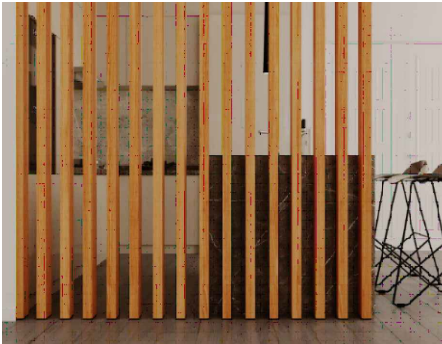

TIMBER SLAT SCREEN

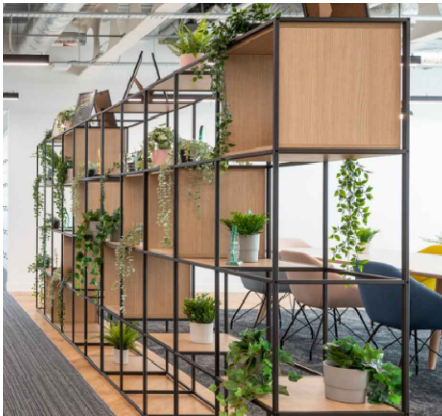

STORAGE / ROOM DIVIDER

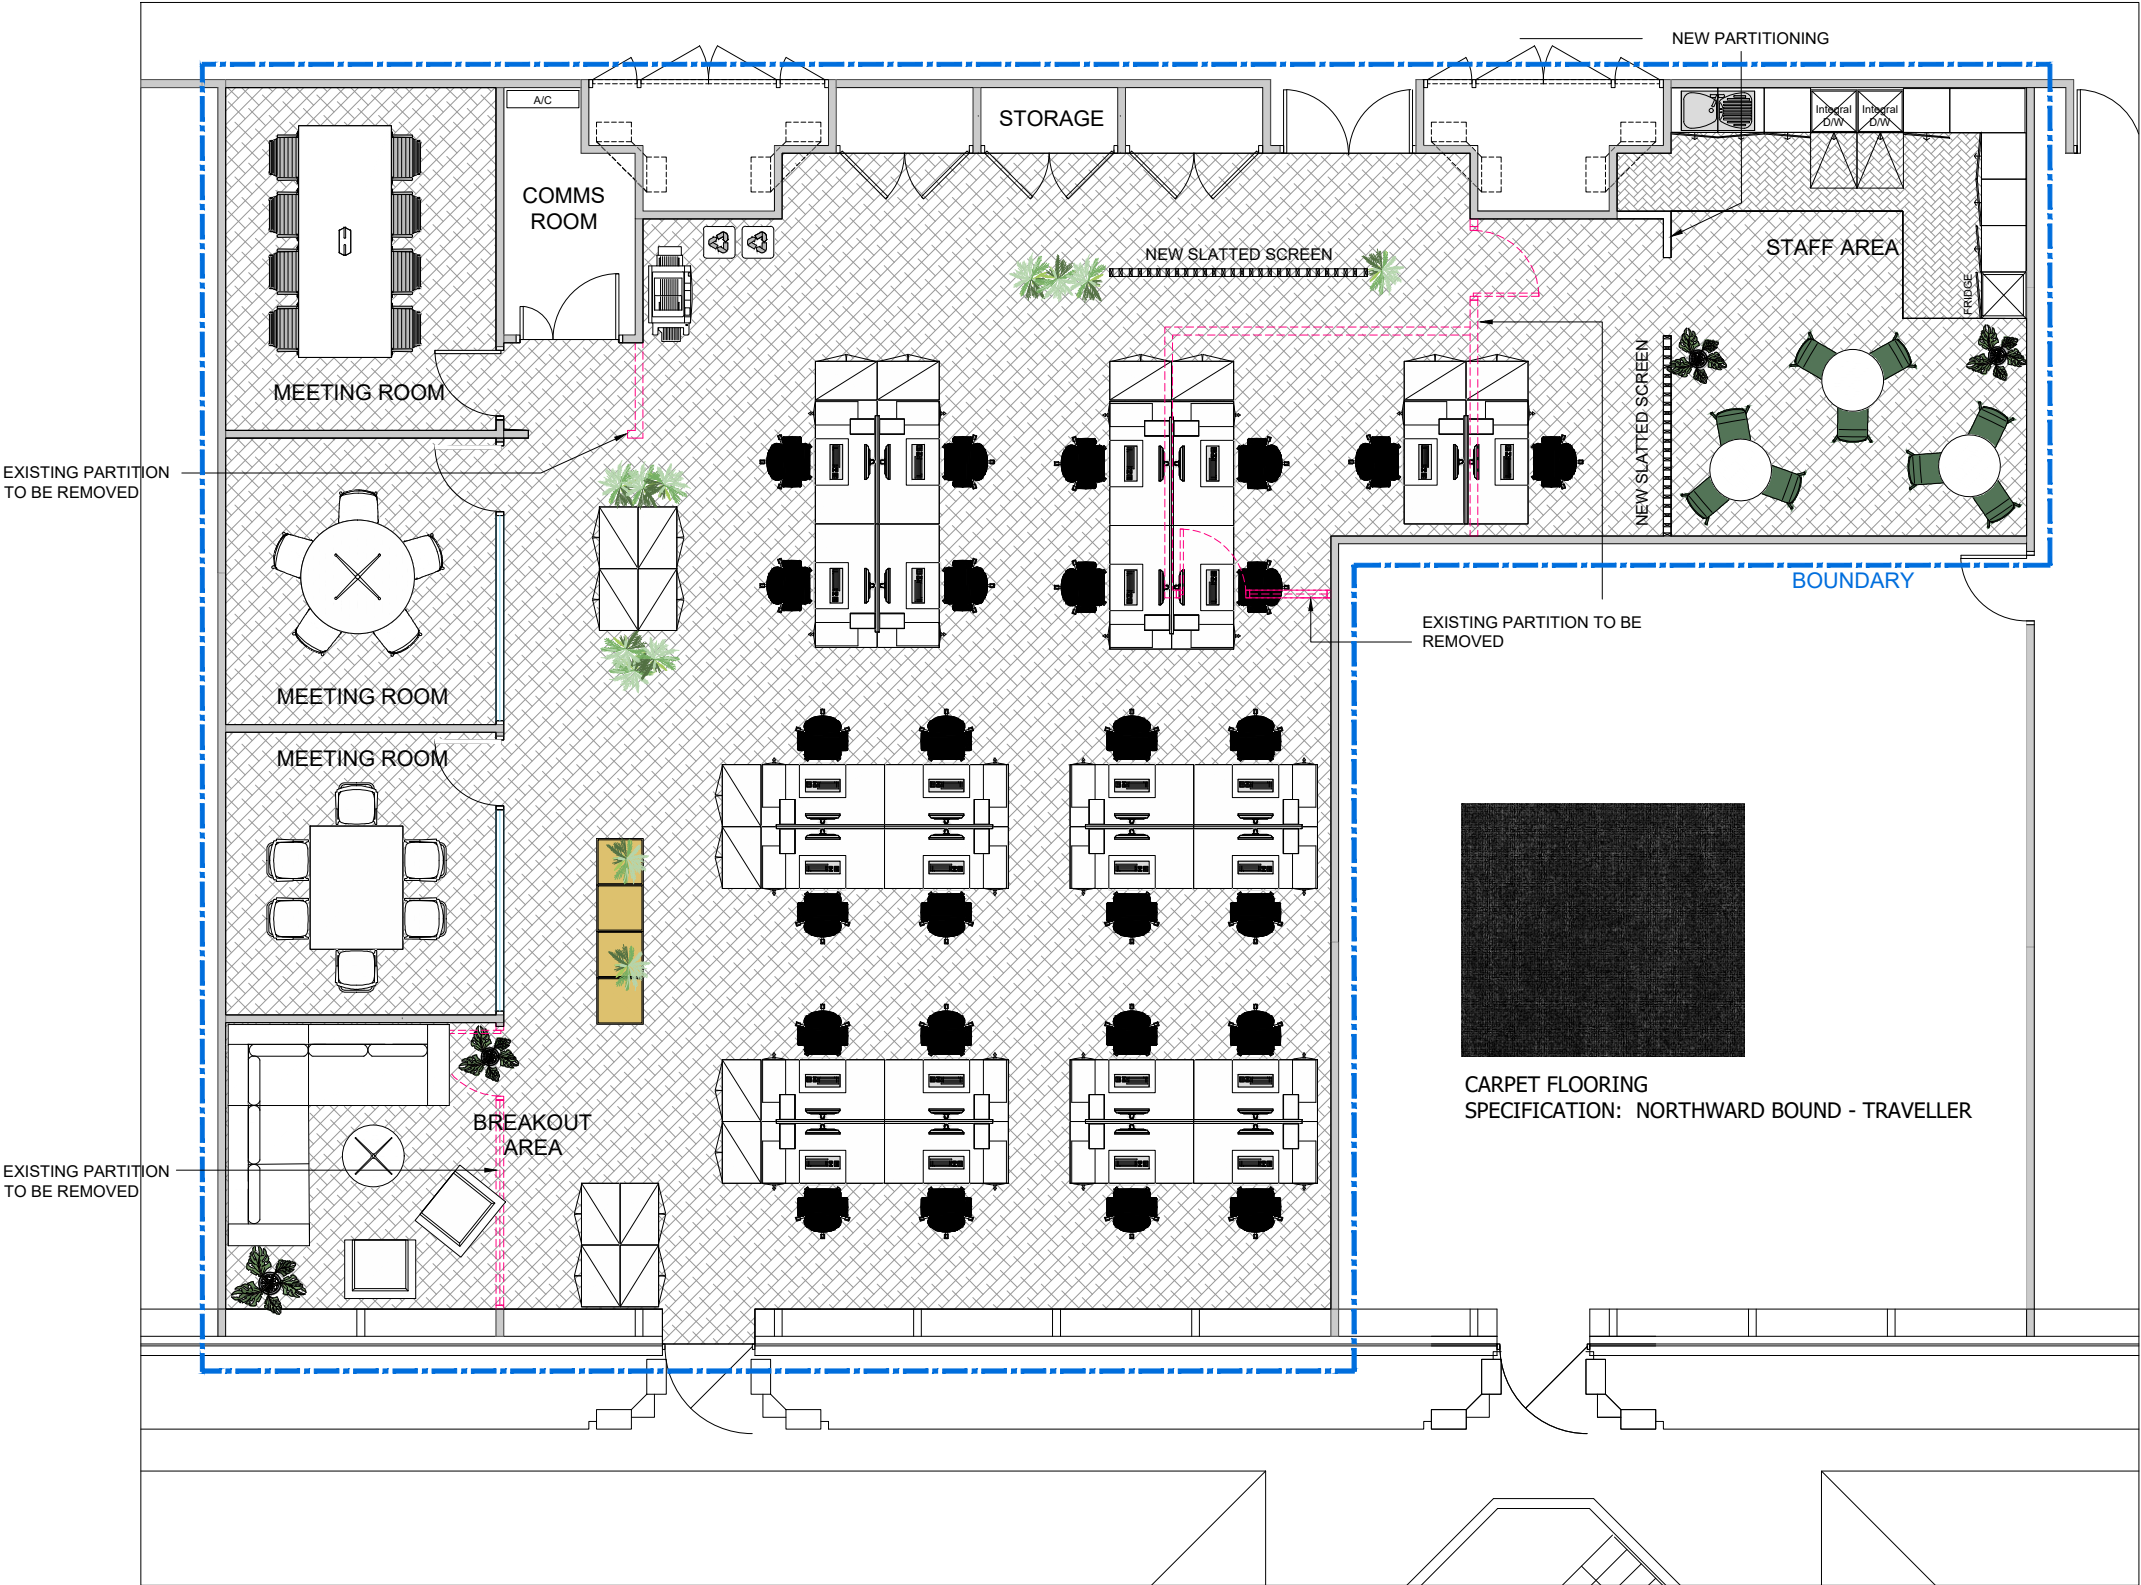

OFFICE
IRC Interiors
1000 Lakeside, Western Road
Portsmouth, Hampshire, PO6 3EN
023 9226 8580 / 07767 405818

CLIENT

PROJECT SUITE 002 LAKESIDE NORTH HARBOUR			
DRAWING TITLE PROPOSED FLOOR PLAN			
SCALE 1:100	DATE 27.01.25	DRAWN BY KB	CHECKED BY
PROJECT No. 3582	DRAWING No. 002	REVISION -	