


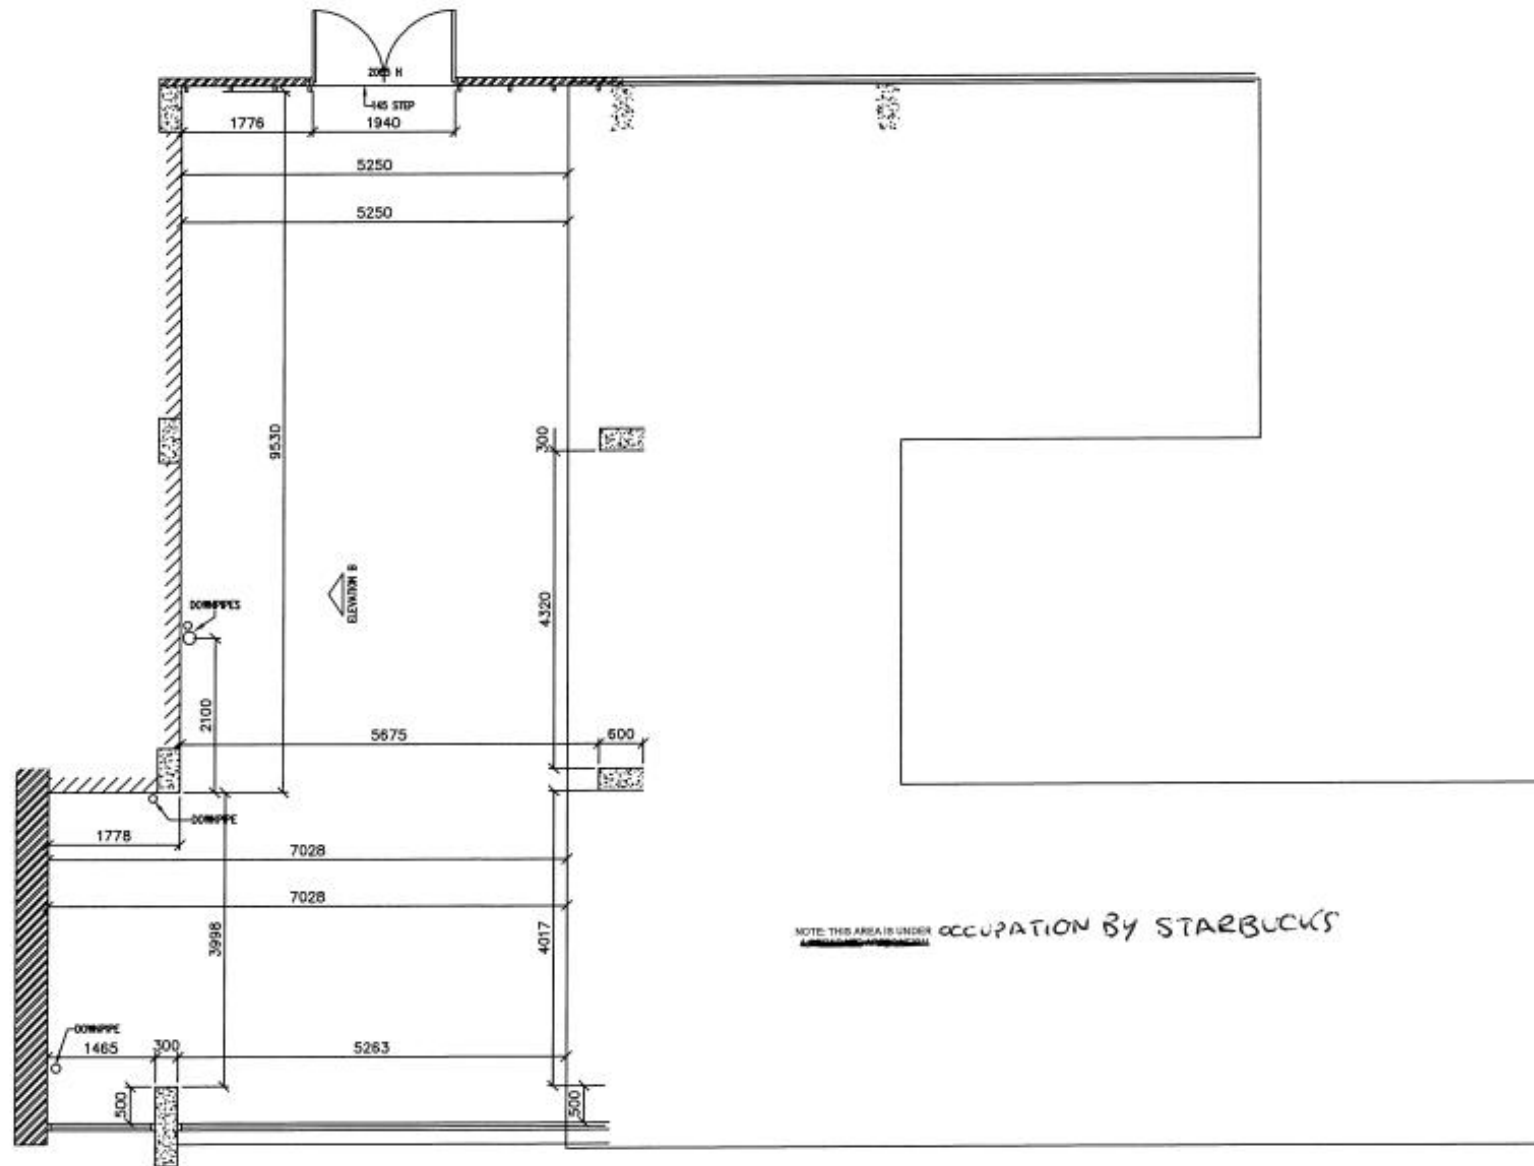

EXISTING PLAN