



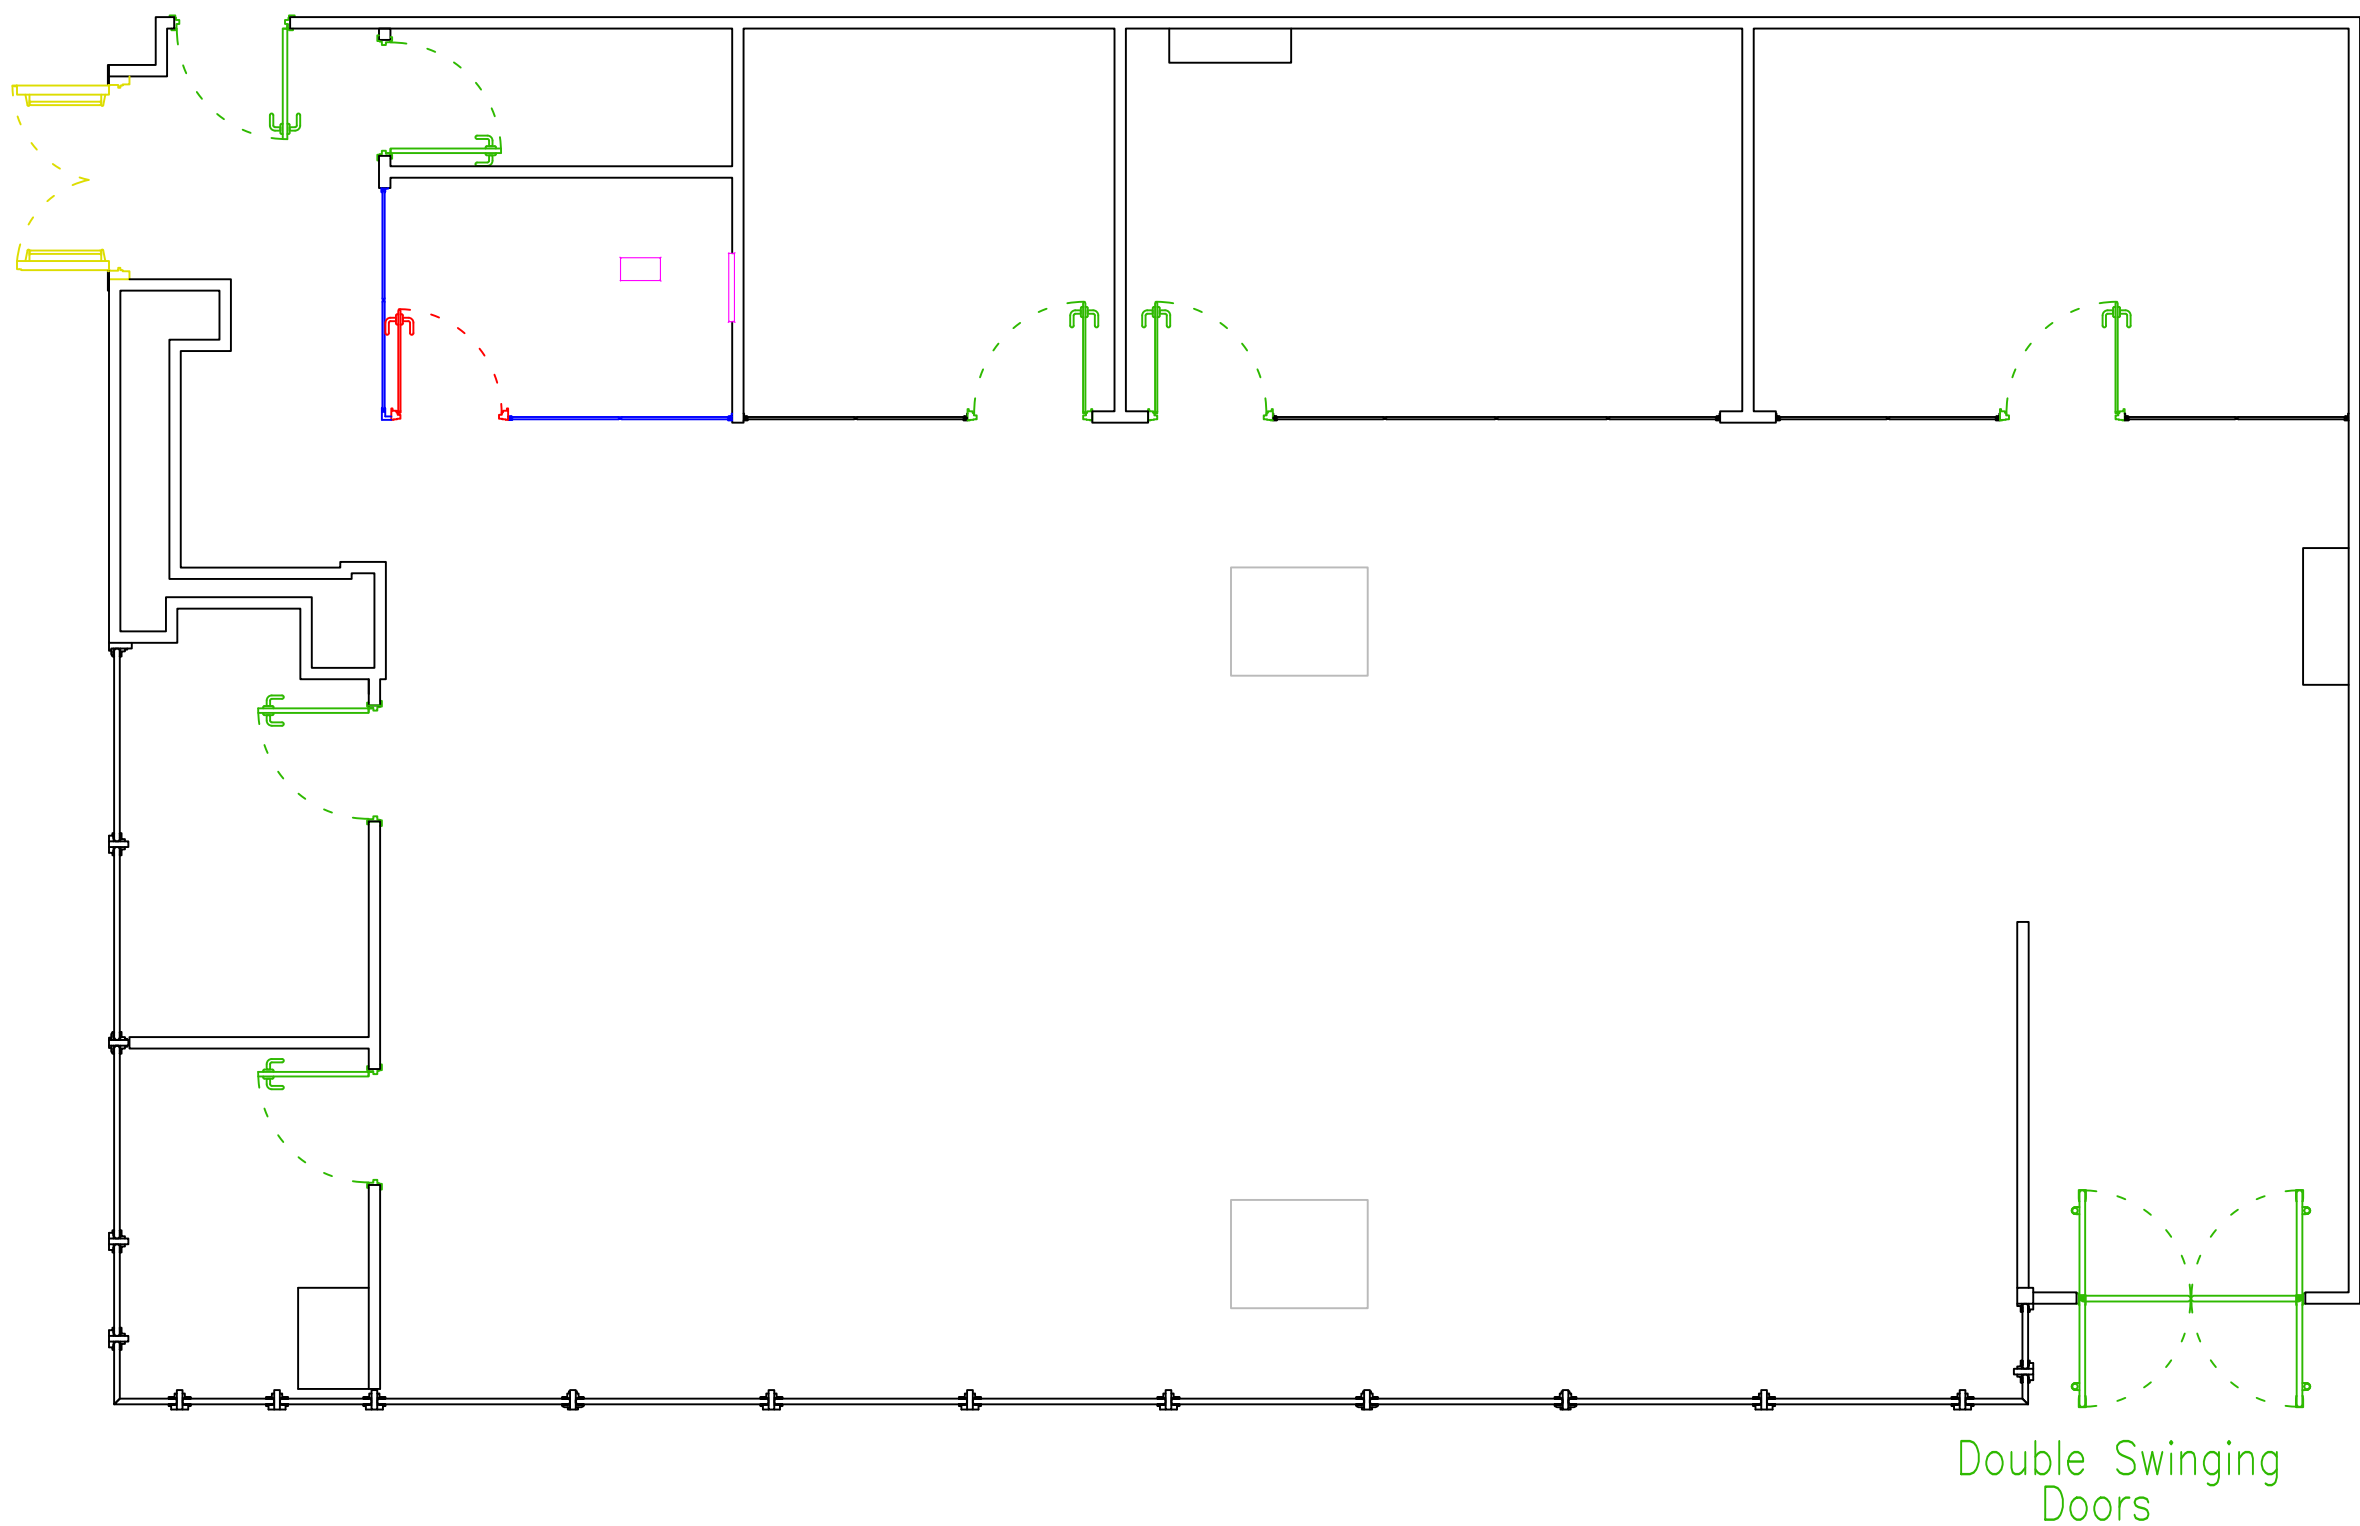

KEY

- Original Partitionings
- Original Doors
- Fire Doors
- Intended Partitionings
- Intended Door
- Plug Sockets & Electrics
- Pillars

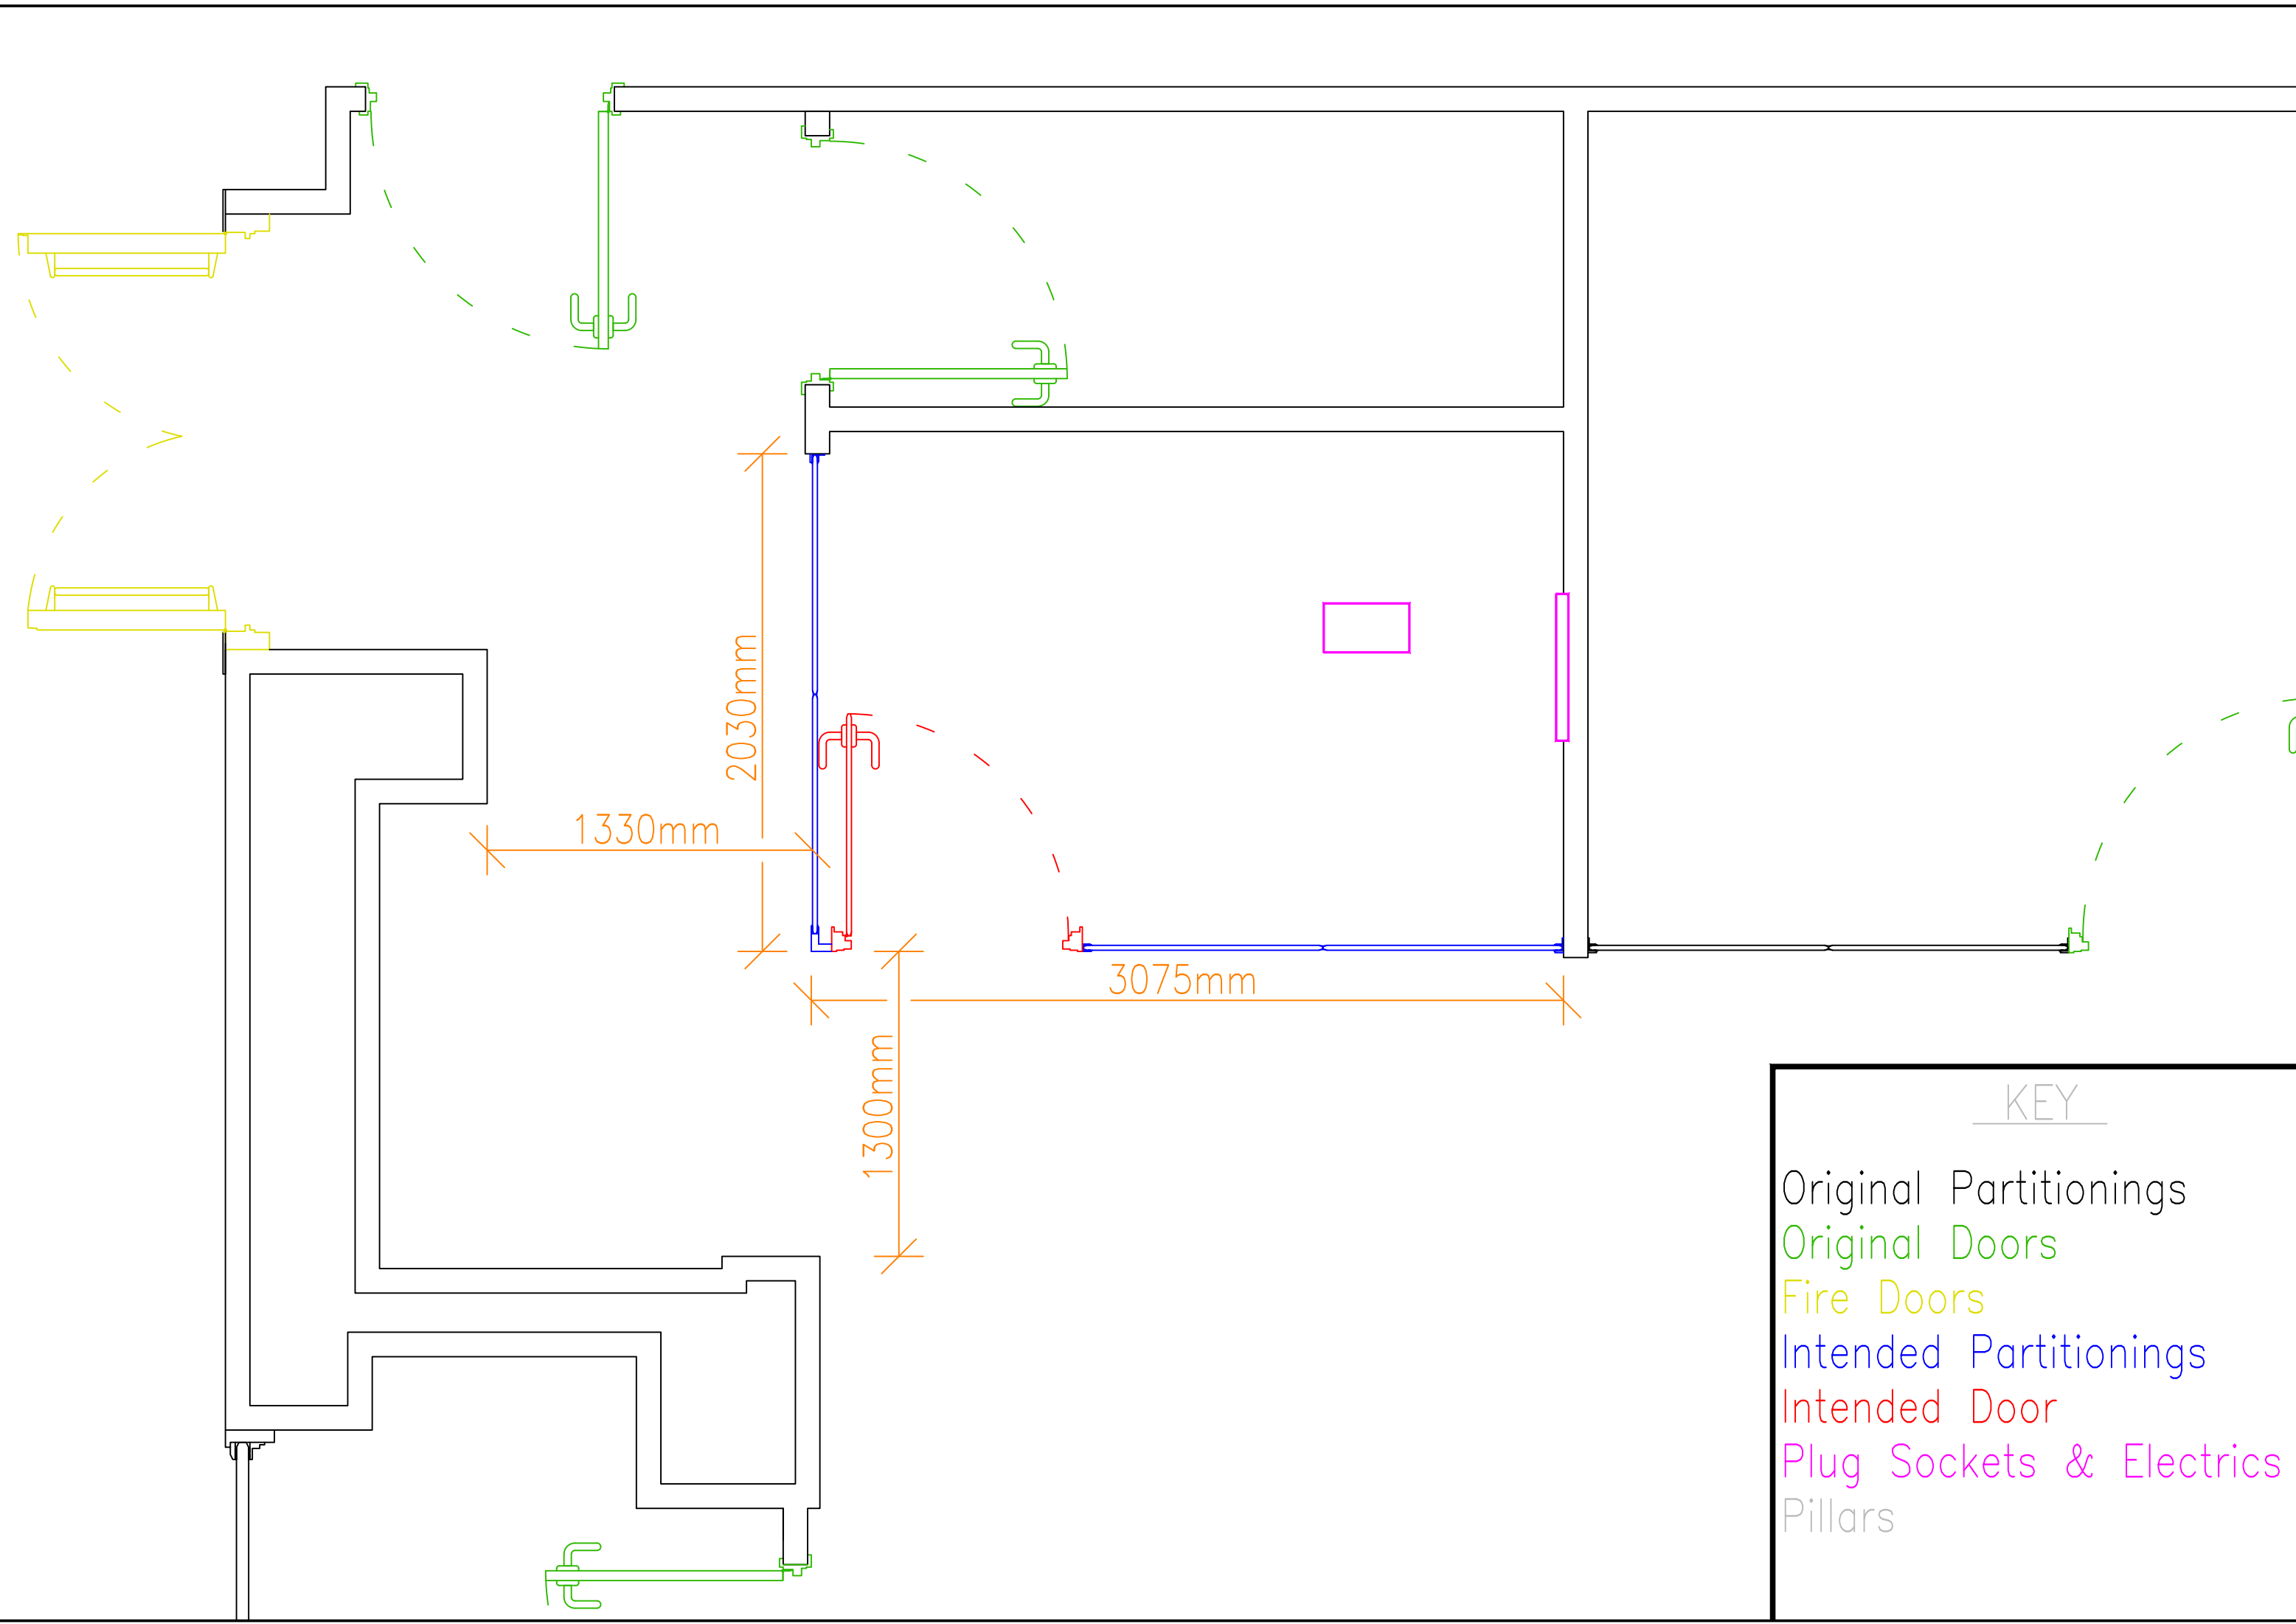

KEY

Original Partitionings

Original Doors

Fire Doors

Intended Partitionings

Intended Door

Plug Sockets & Electrics

Pillars