


Education Option - 01 First Floor Plan

1 : 200




Education Option - 00 Ground Floor Plan

1 : 200

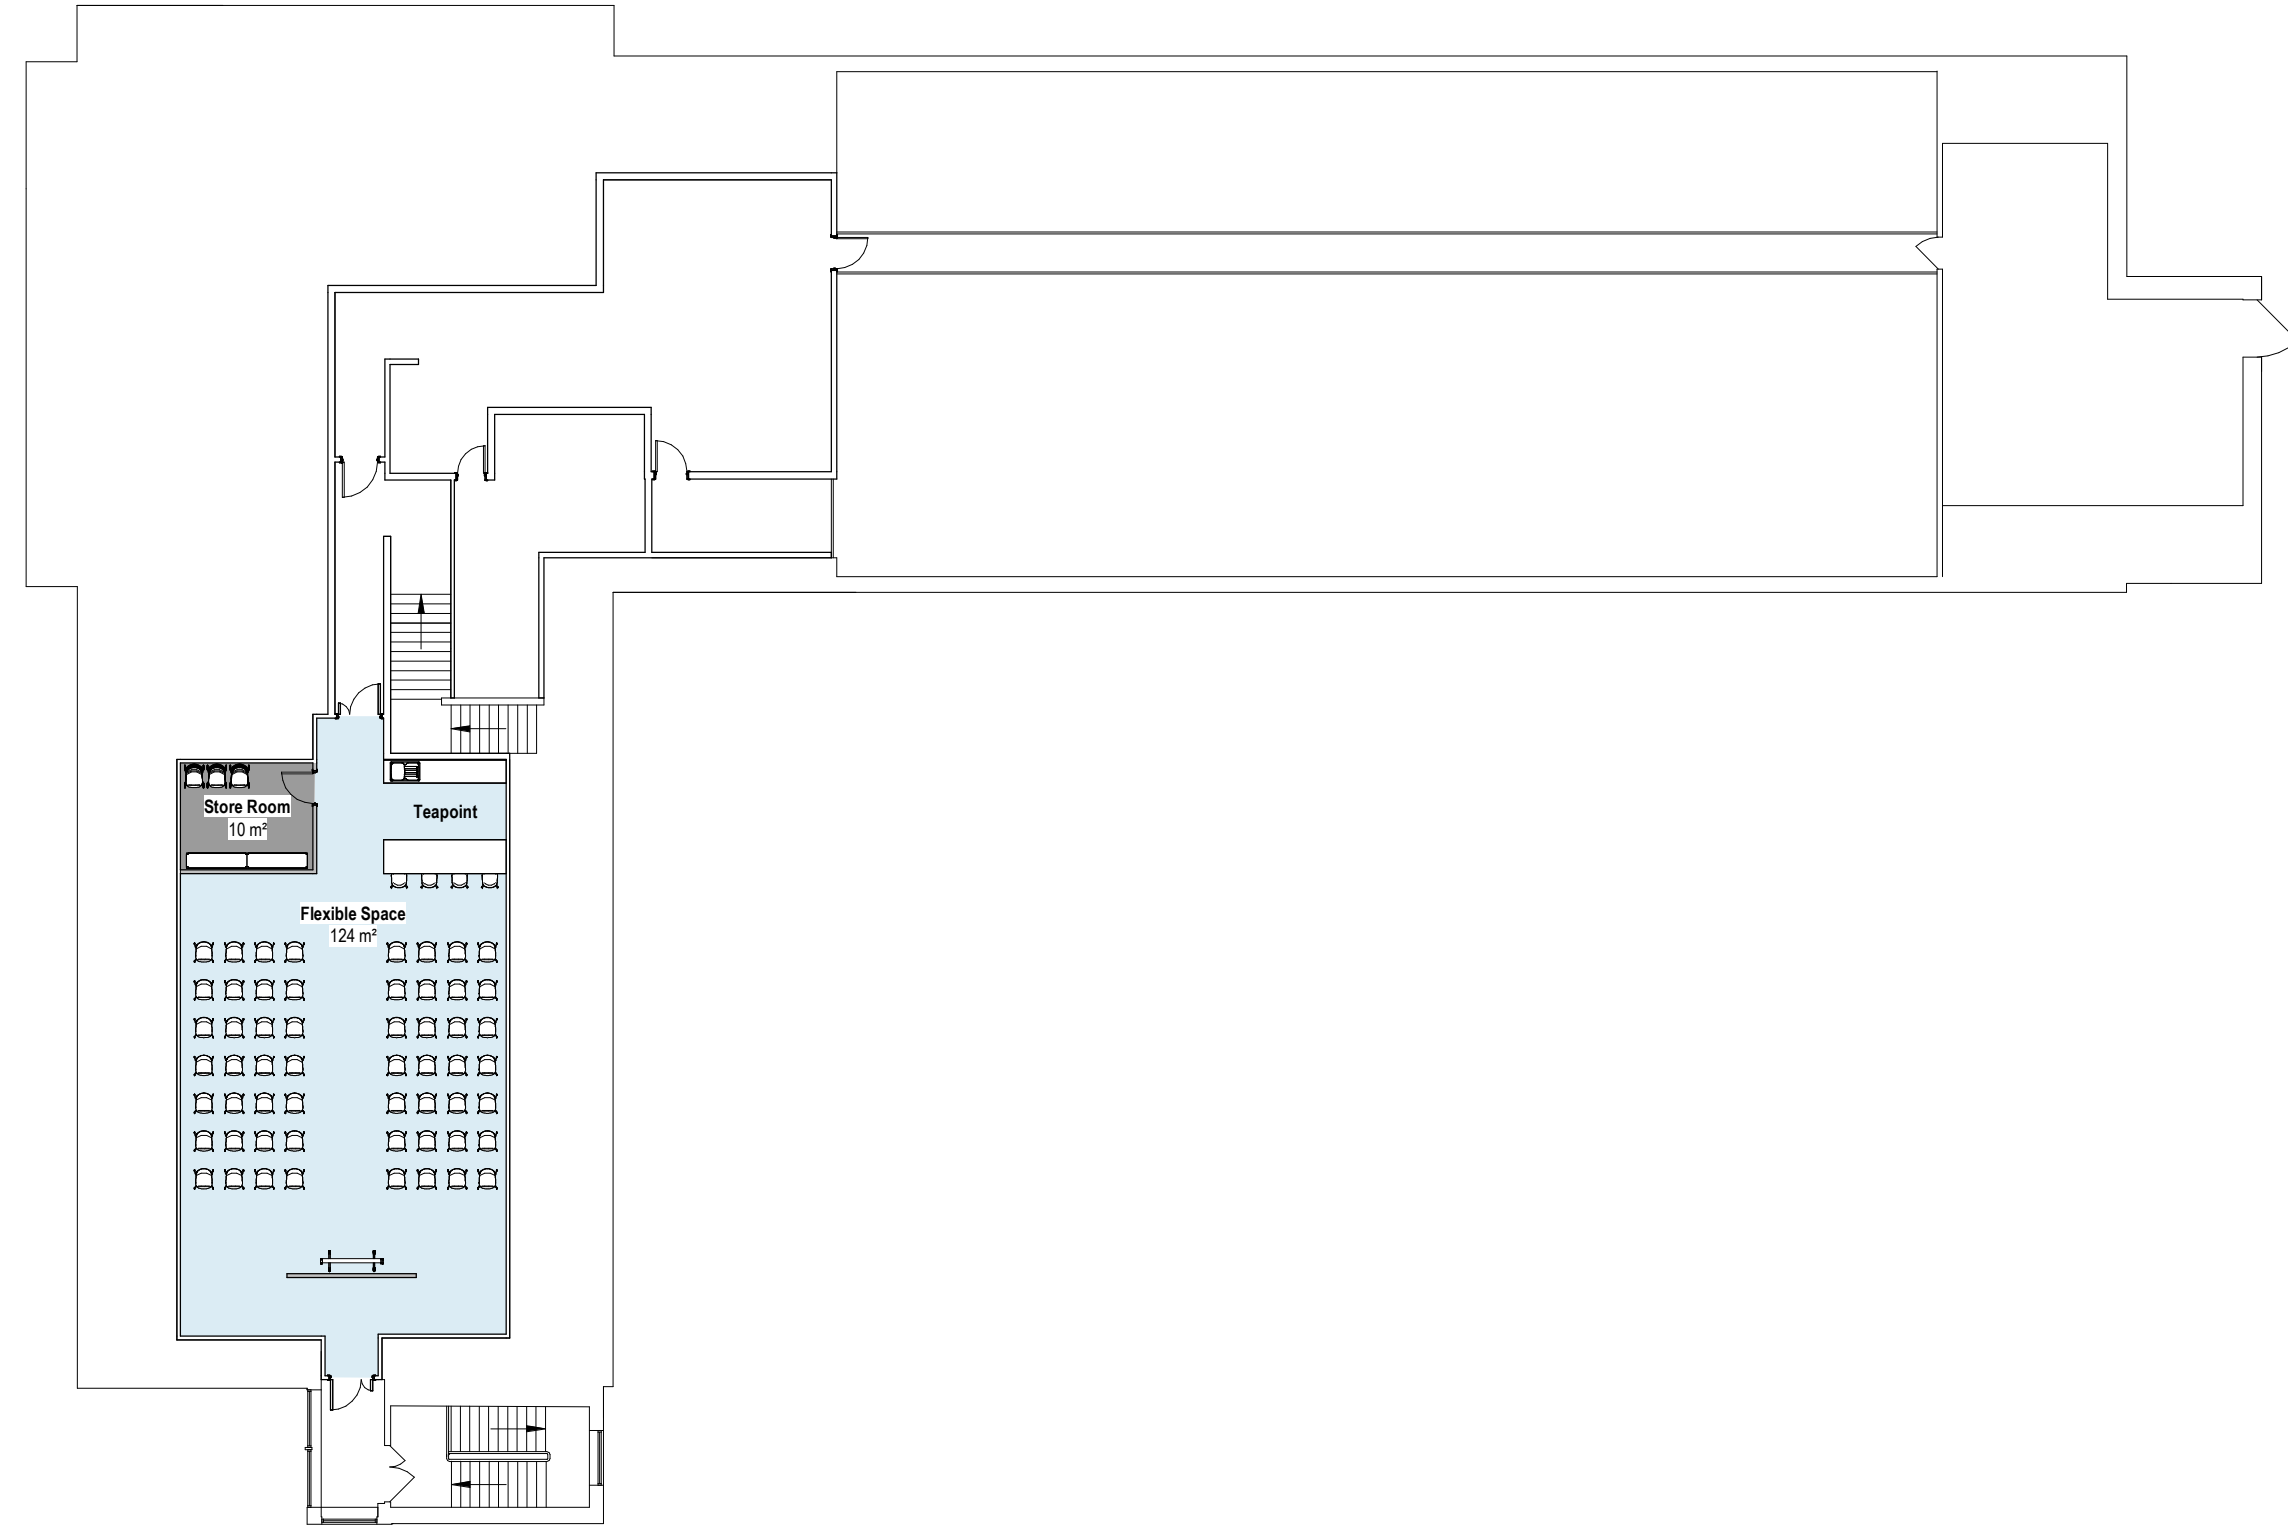

Education Option - RF Roof

1 : 200

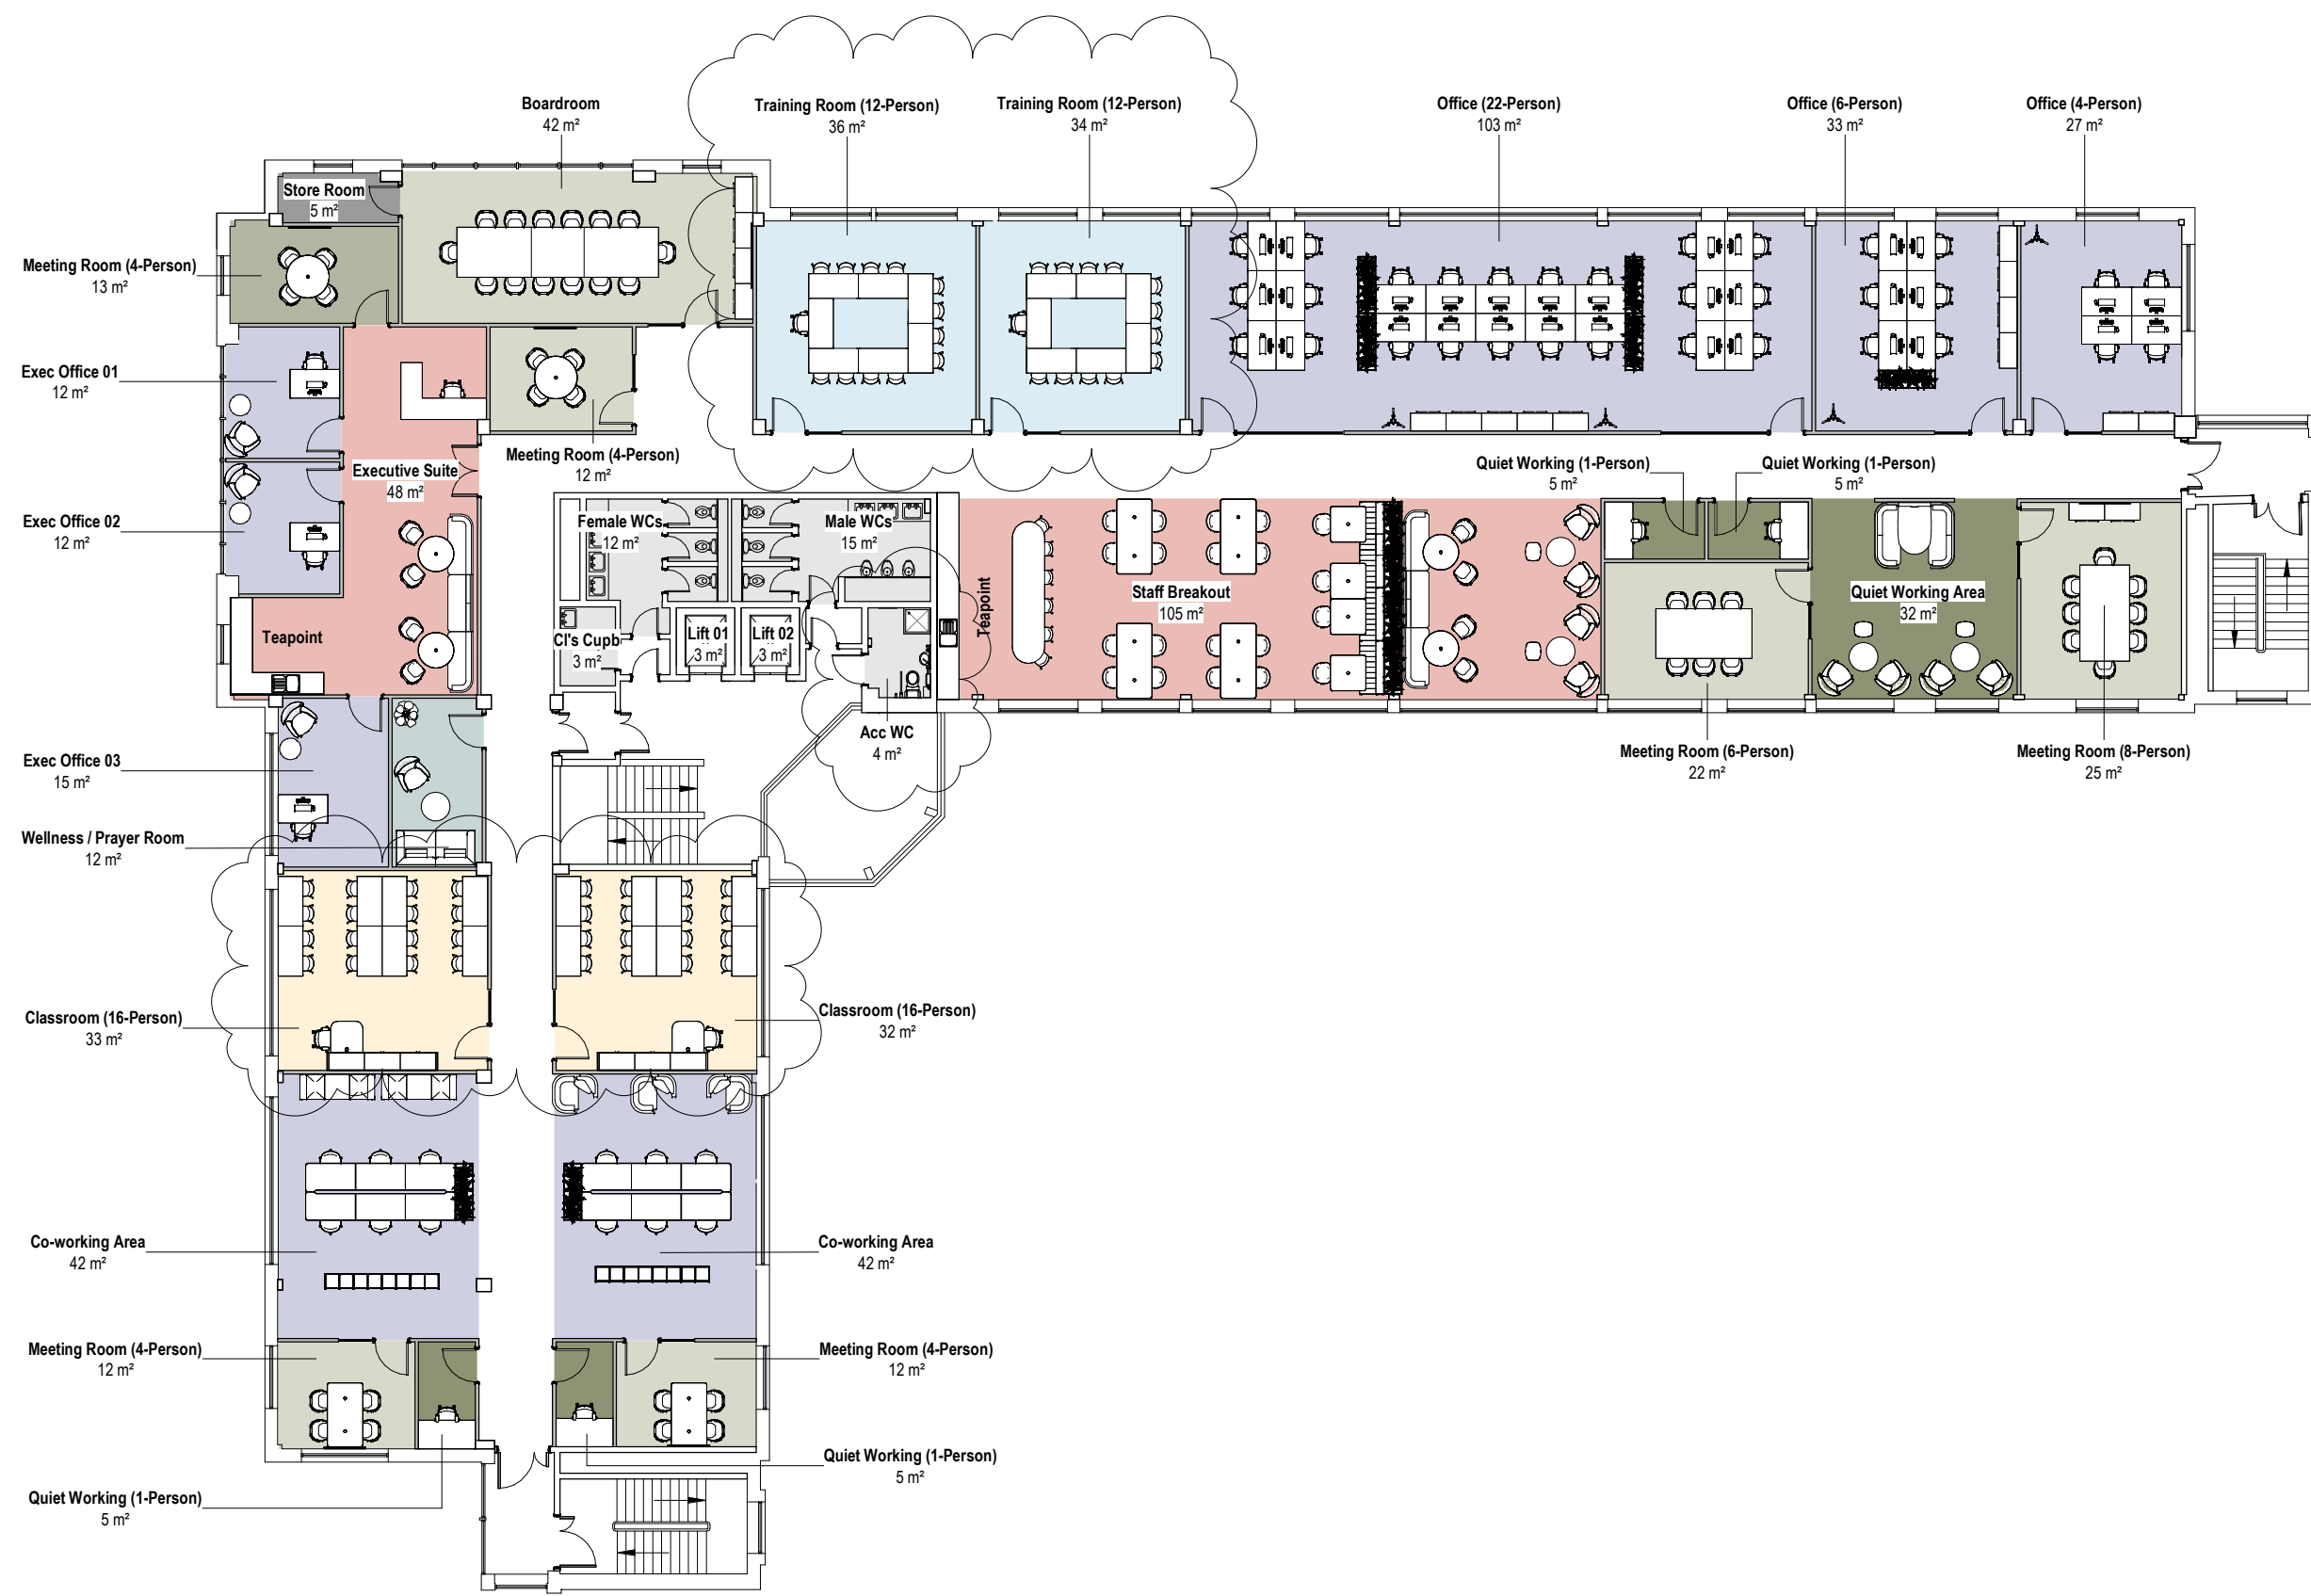




Education Option - 02 Second Floor Plan

1 : 200

GENERAL NOTES:

1. DO NOT SCALE FROM THIS DRAWING.
2. THIS DRAWING IS TO BE READ IN CONJUNCTION WITH THE CONTRACT SPECIFICATION AND ALL RELEVANT ARCHITECTS', ENGINEER'S AND SPECIALIST'S DRAWINGS.
3. THE EXISTING SERVICES SHOWN ON THIS DRAWING ARE NOT NECESSARILY COMPLETE NOR IS THEIR LOCATION WITH REGARD TO POSITION AND DEPTH PRECISE. IT IS THE CONTRACTORS RESPONSIBILITY TO LIAISE WITH ALL RELEVANT SERVICES COMPANIES TO ENSURE THE SERVICES ARE ACCURATELY LOCATED AND ADEQUATELY PROTECTED DURING CONSTRUCTION.
4. ALL DIMENSIONS PROVIDED TO BE CHECKED ON SITE AGAINST CONSTRUCTION ISSUED DRAWINGS





 

 






Key:

-  Existing
 Demolition
 New Construction

 Note:

All existing walls and doors on Second Floor (excluding central core) to be demolished. Demolished items not shown on proposed Second Floor Plan to ensure a clearer view.

Area Type Key:

-  Breakout
-  Changing Rooms
-  Classroom
-  Collaborative Area
-  Facilities
-  Meeting Room (External)
-  Meeting Room (Internal)
-  Office
-  Quiet Working
-  Reception
-  Store
-  Support Services
-  Training Room

P02	22.07.25	Existing shower tray added to Acc WC on each floor. Main entrance door changed to double door. Additional 2no. classrooms and training rooms added to 02 Second Floor.	DY
P01	18.07.25	First Issue	DY

Rev No	Date	Notes	By
--------	------	-------	----

formm
SPACES TO INSPIRE, CONNECT & COLLABORATE

The Quadrant
99 Parkway Ave
Sheffield S9 4WG

PROJECT:
Blenheim House

CLIENT:
Sorkin Brown

SITE ADDRESS:
Blenheim House
Leeds
LS1 4PL

DRAWING NAME:
Education Option Test Fit Layouts

DRAWING NUMBER
25-035-ID1ZZ00

DRAWN:
DY

SCALE:
1 : 200 @ A1

PURPOSE OF ISSU
Information

REVISION:
P02