



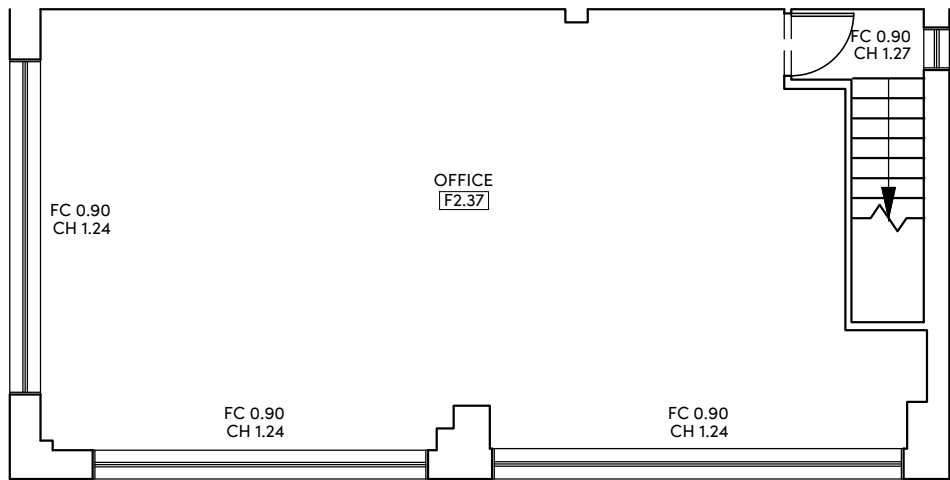

Existing First Floor Plan

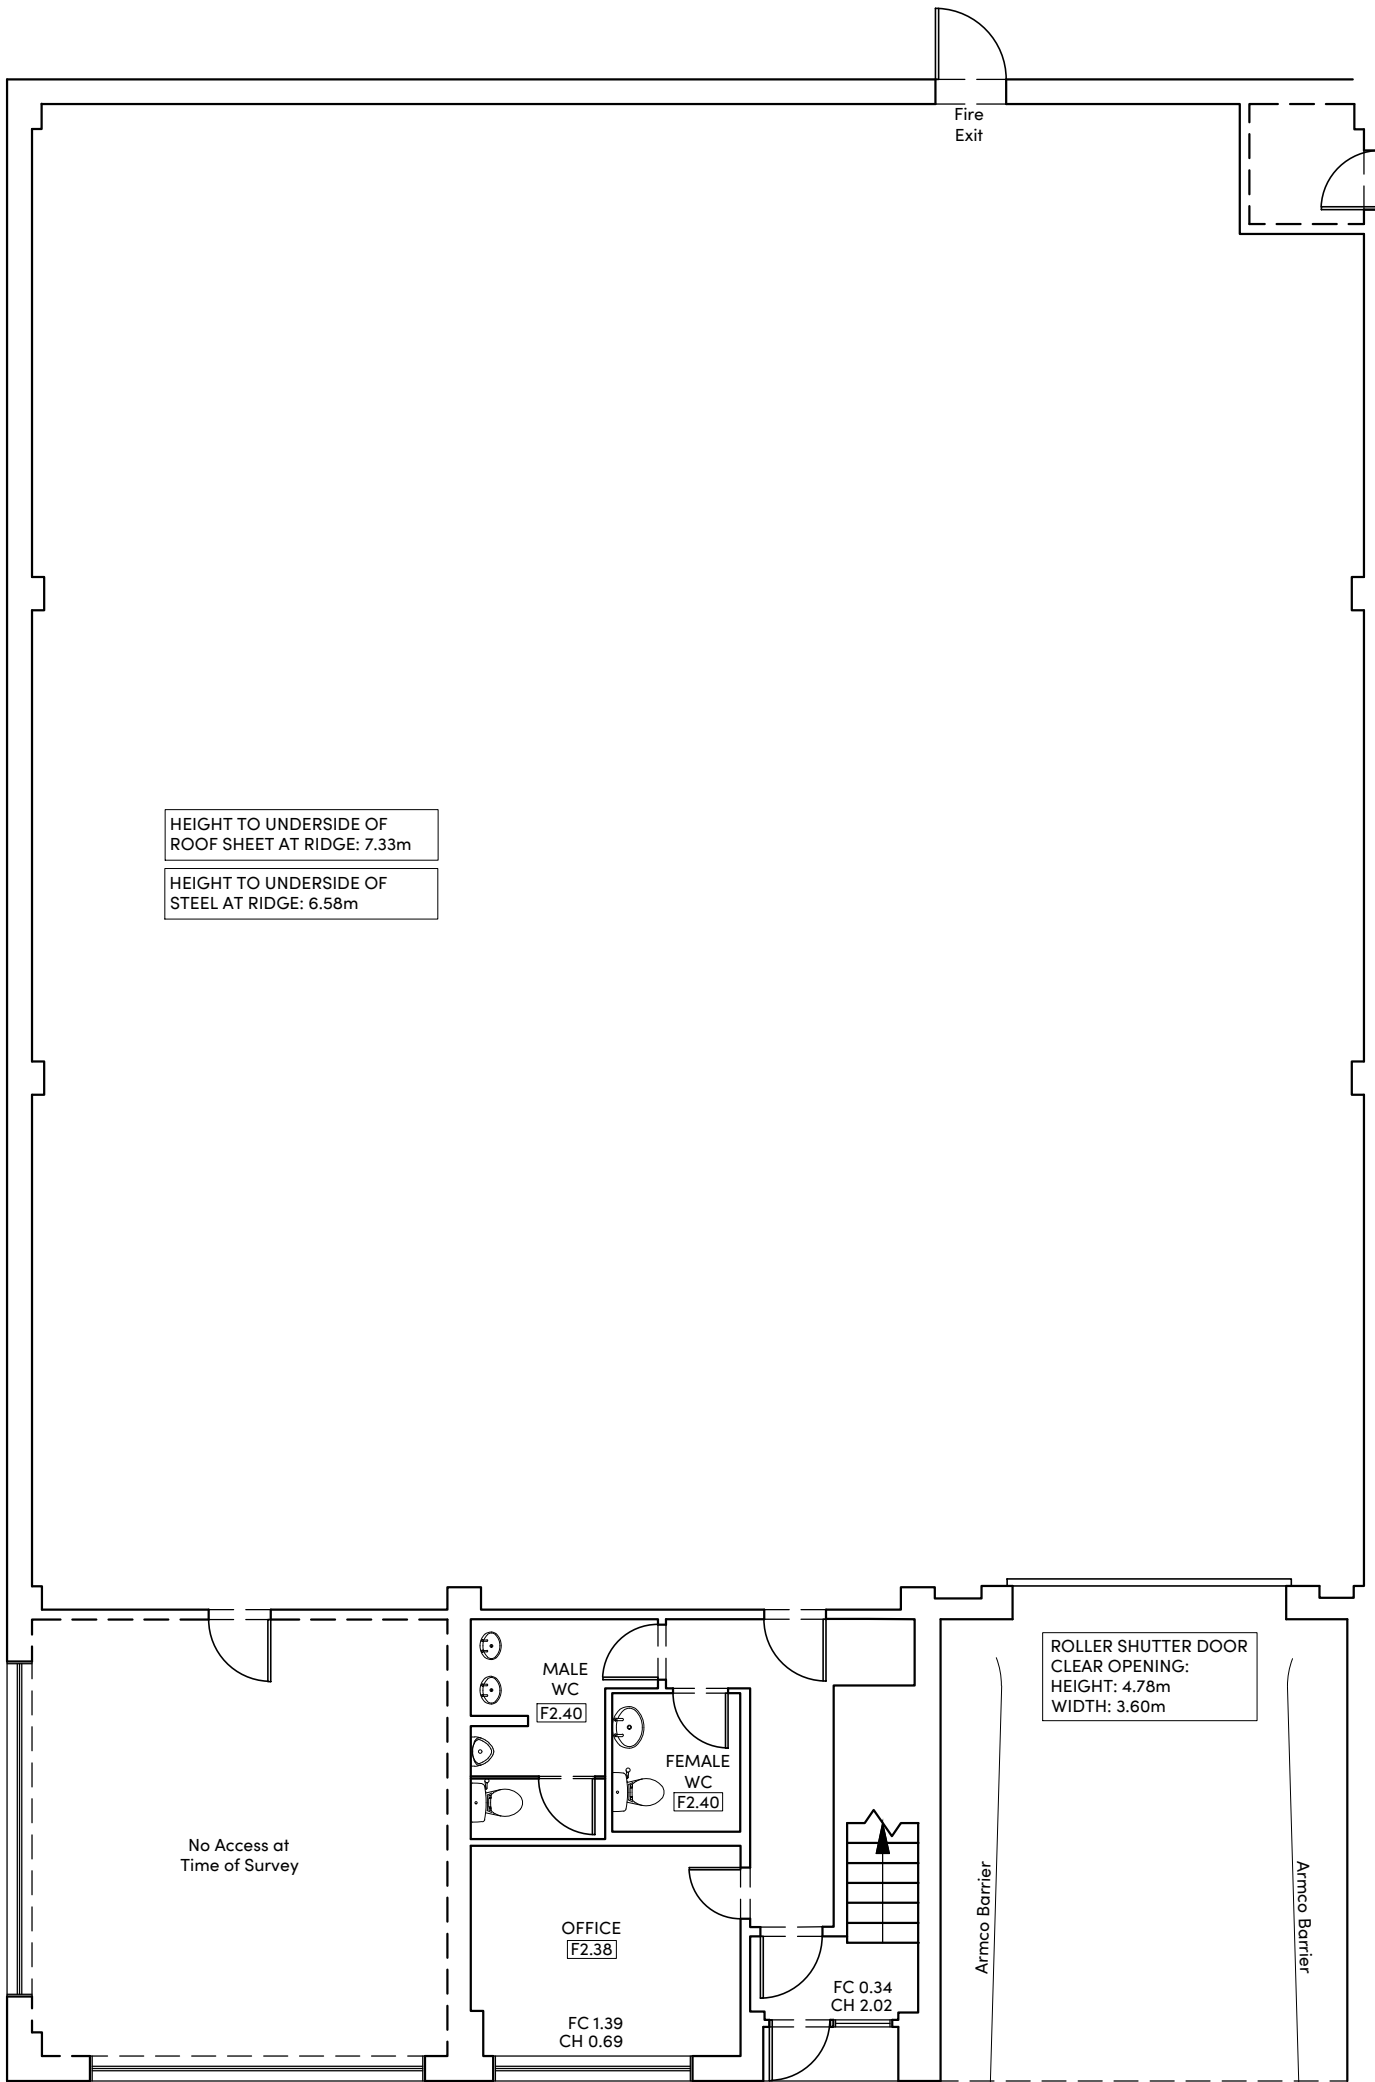

Existing Ground Floor Plan


NOTES

- 1) ALL DIMENSIONS TO BE CHECKED ON SITE AND NOT SCALED FROM THIS DRAWING.
- 2) HOLLIS SHALL BE INFORMED IN WRITING OF ANY DISCREPANCIES.
- 3) ALL DIMENSIONS ARE IN METRES ONLY.
- 4) THE ORIGIN AND ORIENTATION OF THE SURVEY GRID RELATE TO AN ARBITRARY GRID.
- 5) ALL LEVELS ARE BASED ON AN ARBITRARY DATUM.

KEY

A	Alarm	h	Height
A/C	Air Conditioner	HB	Hand Bath
Alt	Arch Height	HD	Handrail
AL	Arch Level	IC	Inspection Cover
AltH	Arch Spring Height	IBF	Iron-Baling Fence
ASL	Arch Spring Level	JB	Junction Box
ATM	Automated Teller Machine	L	Light
B	Balloon	LS	Litter Bin
BGP	Break Glass Point	M	Maximum
BH	Floor To Beam Height	Mn	Minimum
Bf	Brick	O/H	Overhead
BRW	Brick Retaining Wall	OSF	Open Boarded Fence
BSL	Beams Soffit Level	OSBM	Obstruction Survey Bench Mark
BW	Brick Wall	P	Post
BWF	Brickwork Fence	PL	Plasterboard
CBF	Close Boarded Fence	PF	Post and Rail Fence
CCTV	Closed Circuit Television	PS	Paving Stones
CH	CH To Head Height	PWF	Post and Wire Fence
Chy	Chimney	Rd	Road
CF	Corrugated Iron Fence	RDW	Recessed Door Mat
CL	Cover Level	R	Riser
CLF	Chain Link Fence	RSD	Roller Shutter Door
Col	Column	RJ	Roller Shutter Door
Conc	Concrete	RJF	Roller Shutter Door
CoW	Cable on Wall	SB	Sign Board
CPS	Concrete Paving Slabs	SBM	Site Bench Mark
Cup	Cupboard	SC	Stop Cock
DH	Door Height	SF	Security Fence
DP	Down Pipe	SH	Spring Height
D/C	Drainage Channel	SK	Skylight
DH	Duct Height	SO	Smoke Outlet
EJB	Electrical Junction Box	SP	Sign Post
EM	Electric Meter	SS	Security Screen
ESG	Electrical Switchgear	T	Telephone
FA	Fire Alarm	TBM	Temporary Bench Mark
FB	Flower Bed	T/W	Top Of Wall
FC	Floor To CH Height	Tp	Trip
FE	Fire Extinguisher	U/L	Unable To Lift
FL	Floor Level	V	Vent
FR	Flaplight	VP	Vent Pipe
G	Gully	W	Window
GA	Gas Meter	W/C	Whodden C/L Level
GM	Gas Meter	WH	Water Heater
GV	Gas Valve	WHL	Window Head Level
		WM	Water Meter

FLOOR PLAN SYMBOLS

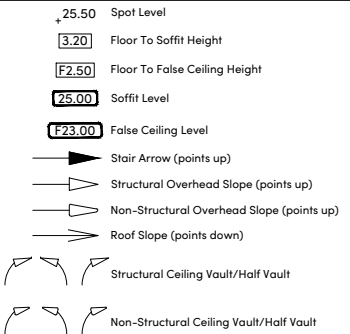

REVISIONS

REV	DATE	AMENDMENTS	INITIAL
-----	------	------------	---------

THIS DRAWING IS FOR THE FOLLOWING PURPOSE ONLY:
PRELIMINARY ☐ TENDER ☐ CONSTRUCTION ☐
SKETCH ☐ MEASURED SURVEY ☒ CONTRACT ☐

TITLE
EXISTING GROUND &
FIRST FLOOR PLAN

CLIENT
JLL
4 Longwalk, Stockley Park
Uxbridge
UB11 1FE

PROJECT NAME
Unit 16
Trident Industrial Estate,
Blackthorne Road,
Poyle, SL3 0AX

HOLLIS



140 London Wall
London
EC2Y 5DN

T +44 20 7622 9555
W hollisglobal.com

DATE 02.11.2020		DRAWN BY MRob		
SCALE 1:100 @A2		CHECKED PV		
PROJECT	ORIGINATOR	VOLUME/ ZONE/BLDG	LEVEL	FILE TYPE
87628	HLS	U16	ZZ	M2
DISCIPLINE/ ROLE	NUMBER	STATUS		REVISION
G	10200	A7		---