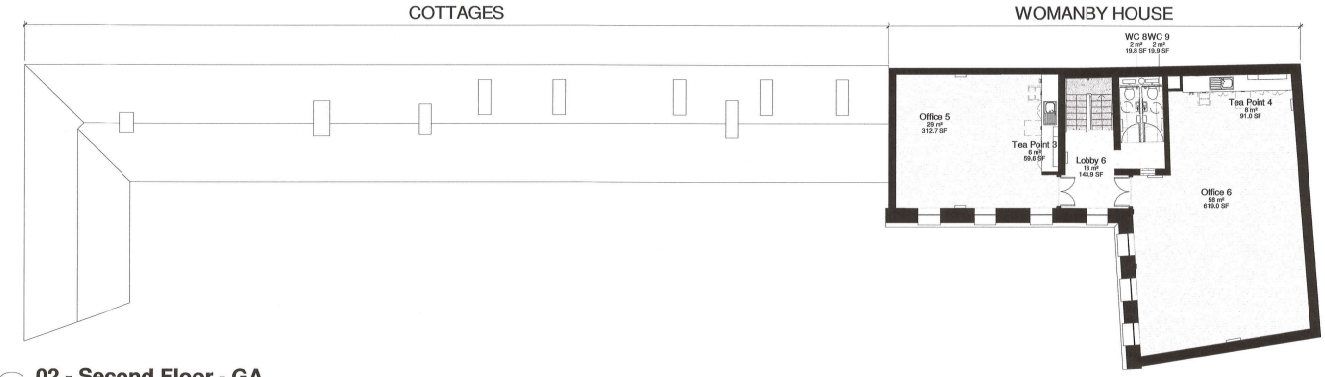

3 **02 - Second Floor - GA**
1 : 100

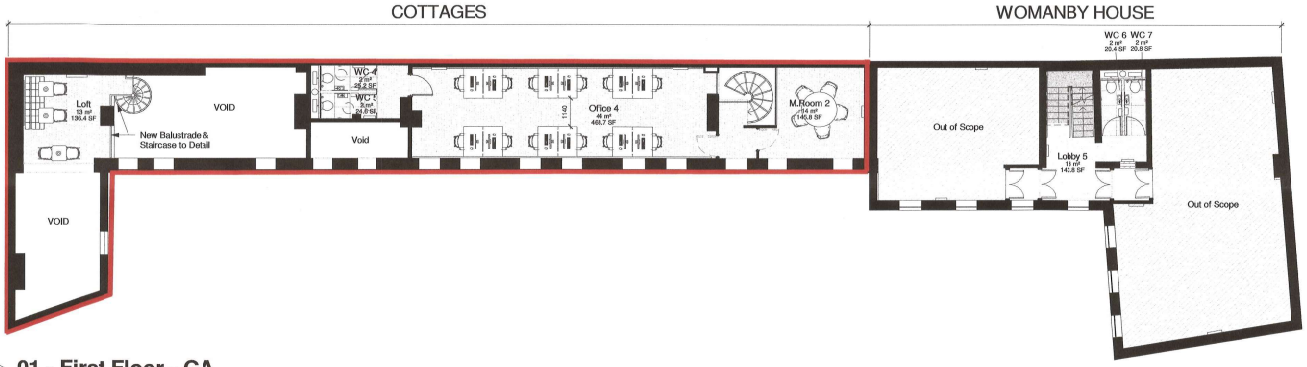

2 **01 - First Floor - GA**
1 : 100

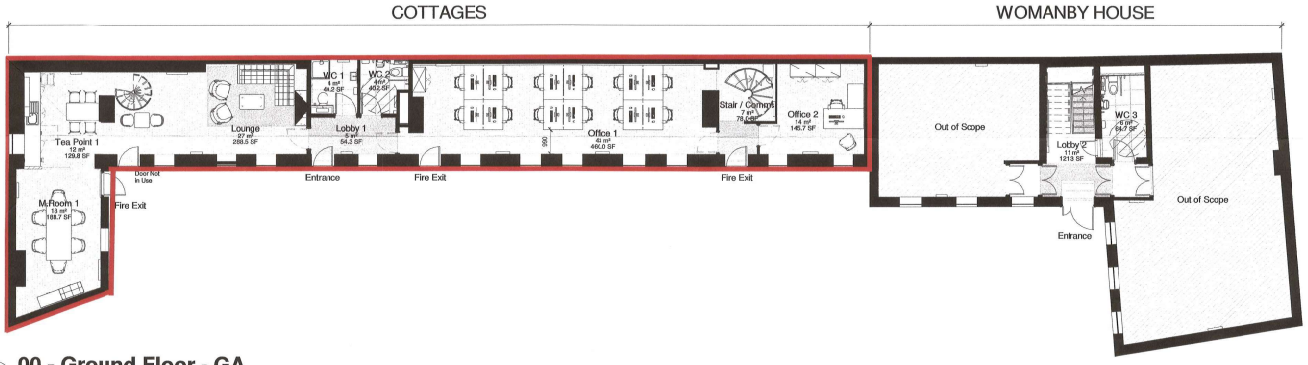

1 **00 - Ground Floor - GA**
1 : 100

Scale 1:100 @ A1 / 1:200 @ A3

0 2 5 10 m

SMARTER WORKSPACES

Written dimensions on these drawings shall take precedence over scaled dimensions. Contractors shall verify and be responsible for all dimensions and conditions on the project and Woodhouse Contracts Ltd must be notified of any variations from the dimensions and conditions shown on these drawings prior to commencement of any work. All contractors are deemed to have made themselves aware of site conditions prior to entering into any contract.

This drawing is the property of Woodhouse Contacts Ltd. copyrigh is reserved by them and the drawing is issued on condition that it is not copied, reproduced retained or disclosed to any unauthorised person either wholly or in part without the consent in writing from Woodhouse Contracts Ltd.

Revision	Description	Drawn	Date
-	As Built Issue		23.04.21

Client: Kames Capital

Title: General Arrangement Plans

Number: 20C288_200_GA

Project Status: As Built

Revision: -

First Issue Date: 21.10.20

Project Site: Jones Court, Womanby St. Cardiff CF10 1BR

Scale: 1 : 100 @ A1

WOODHOUSE

Woodhouse Contracts Ltd. 40 Beaconsfield Road
Hatfield, Hertfordshire, AL10 8BB
T: 01707 255 300
E: sales@woodhouseworkspace.com
W: www.woodhouseworkspace.com