


Approved 27/05/2009


Figured dimensions only to be taken from this drawing. All scaled dimensions to be checked on site before any work is put in hand. The copyright remains within the control of Philip Design Associates.

No.	Date	Revision
A	14/04/09	Roof lights added.

AI

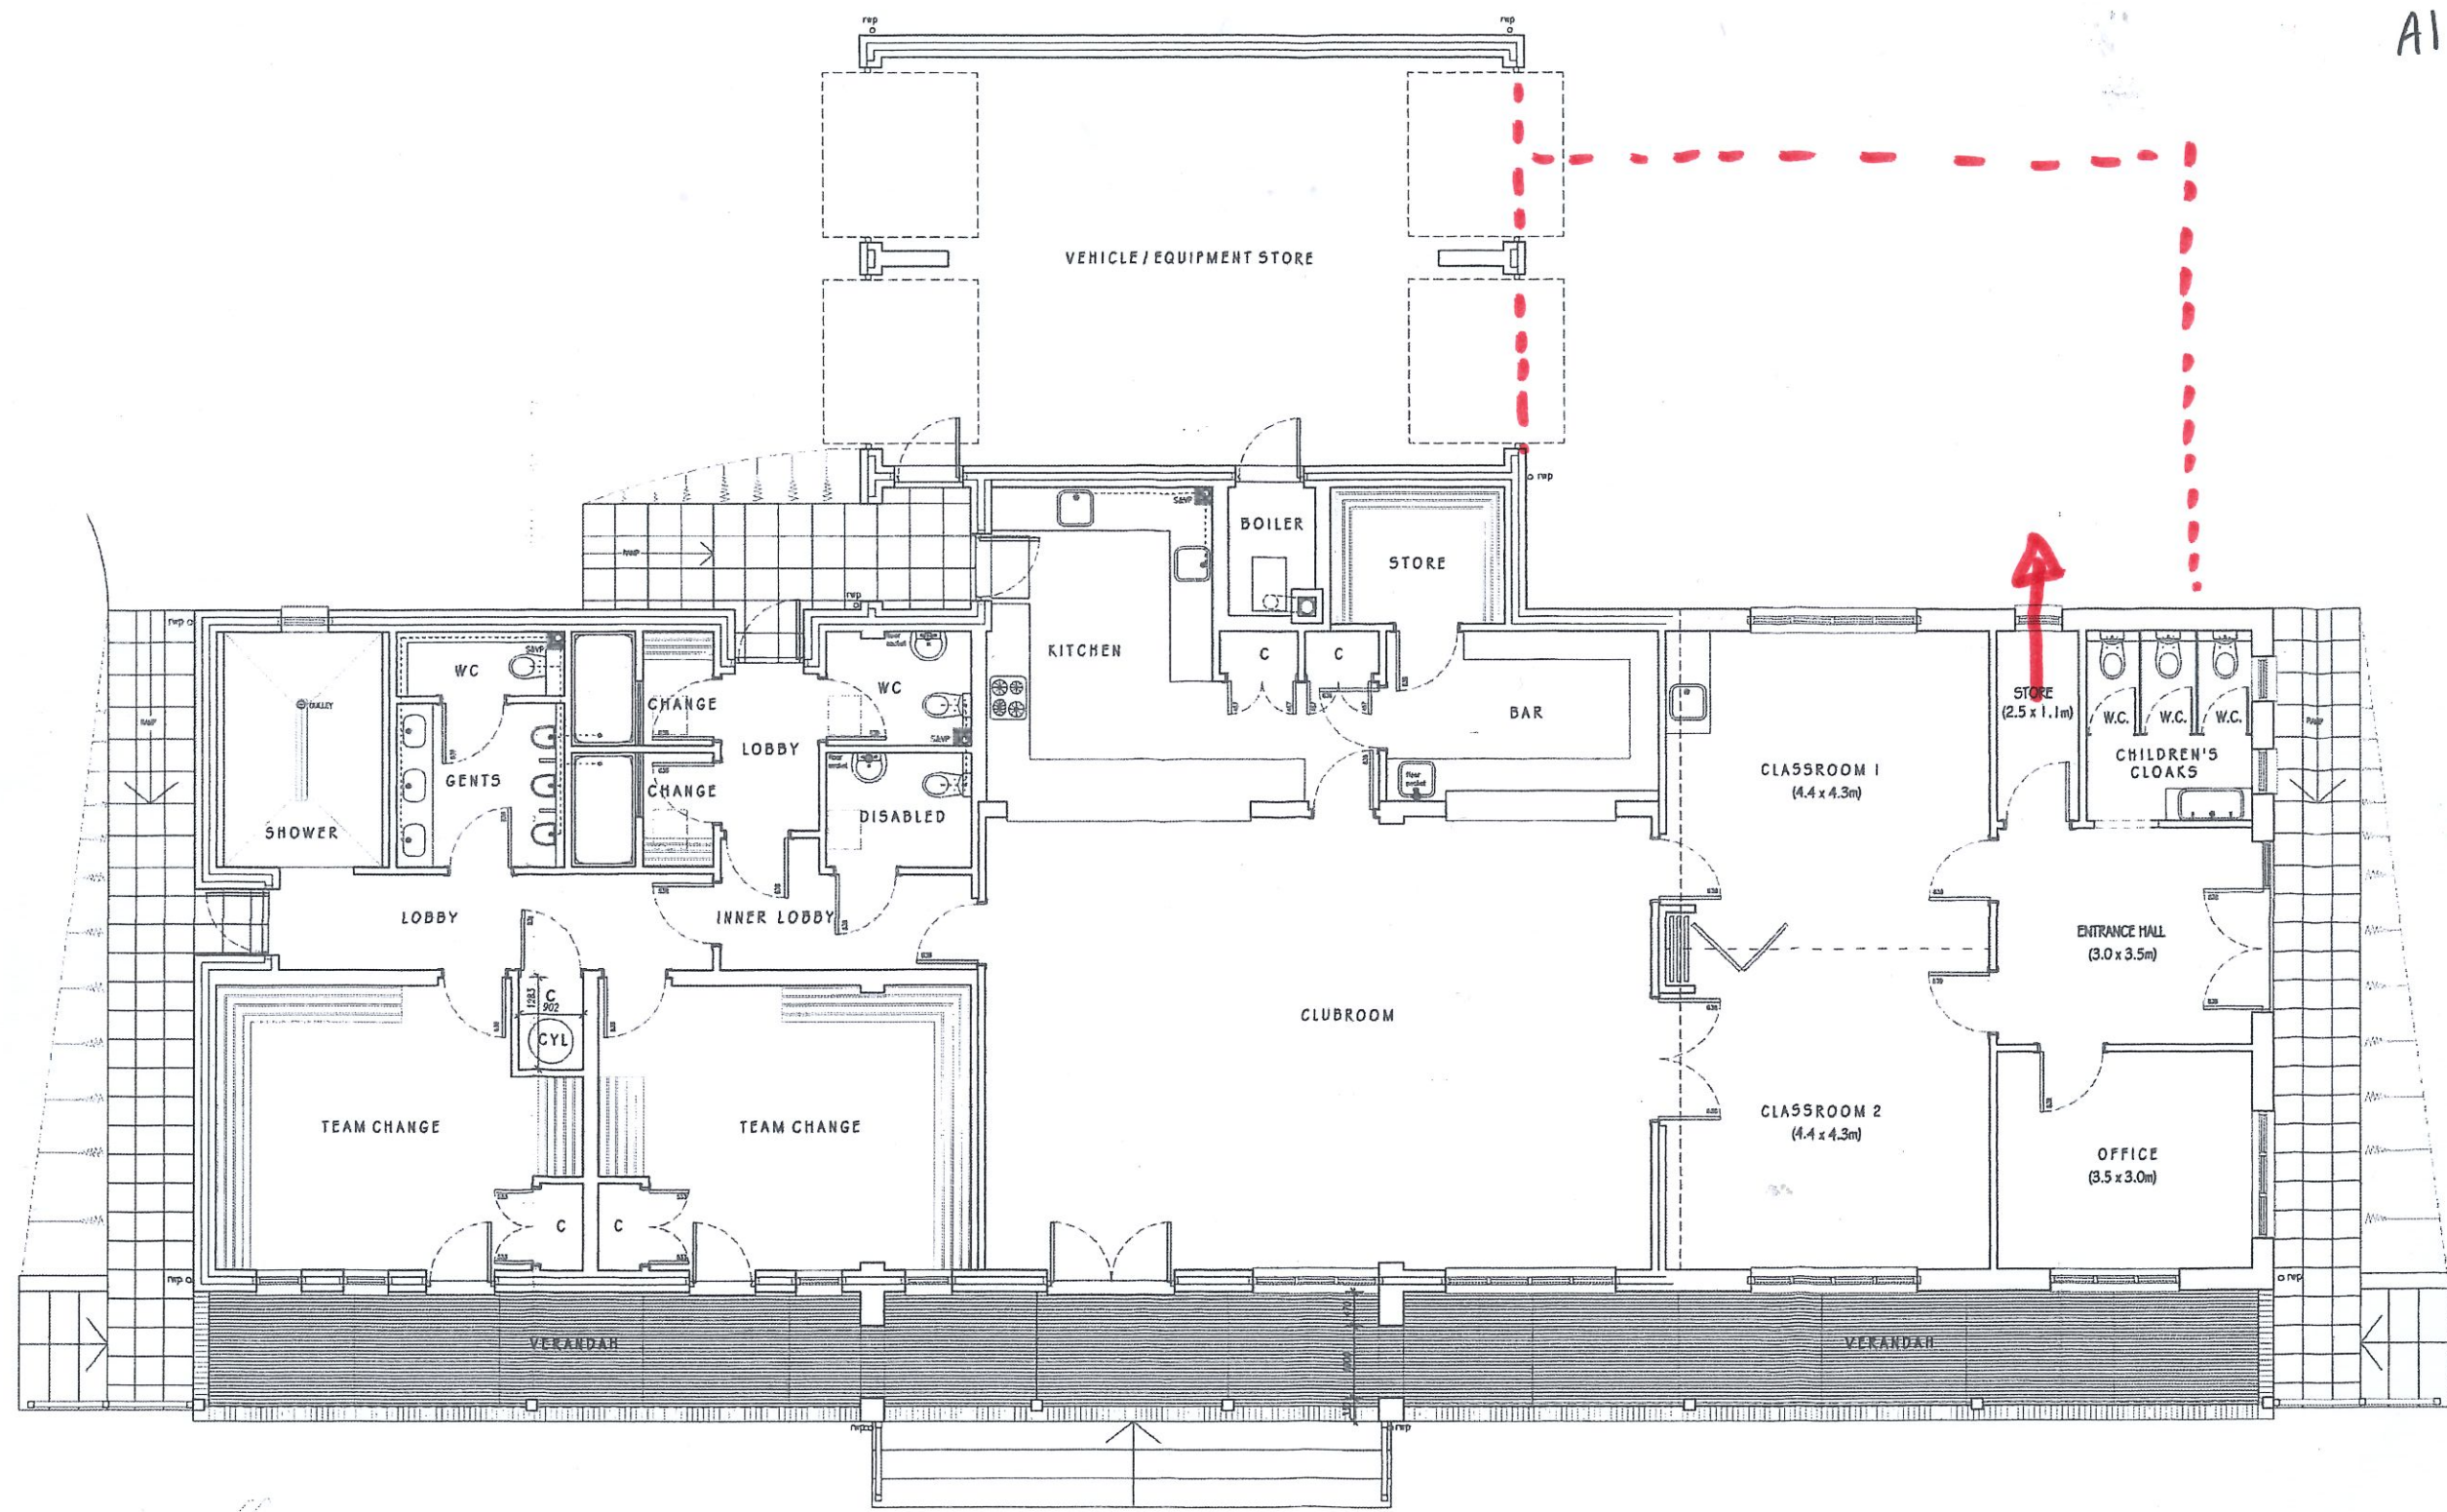

FLOOR PLAN

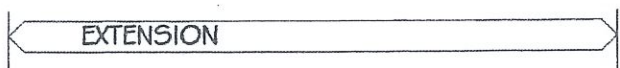

Application No
108 - 7 0 4 9 0

BASINGSTOKE & DEANE
BOROUGH COUNCIL
15 APR 2009
DEVELOPMENT CONTROL

project
NASHES GREEN FIELD
HERRIARD
HAMPSHIRE

title
THE PAVILLION
FLOOR PLAN

date	DEC 2008	scale	1:50
drawing number	08.42.02	rev	A

**PHILIP
DESIGN ASSOCIATES**
Architects and Surveyors
64 Portsmouth Road
Guildford Surrey GU2 4DU
Tel: 01483 533011 Fax: 01483 576647
e-mail: philipdesign@btconnect.com