


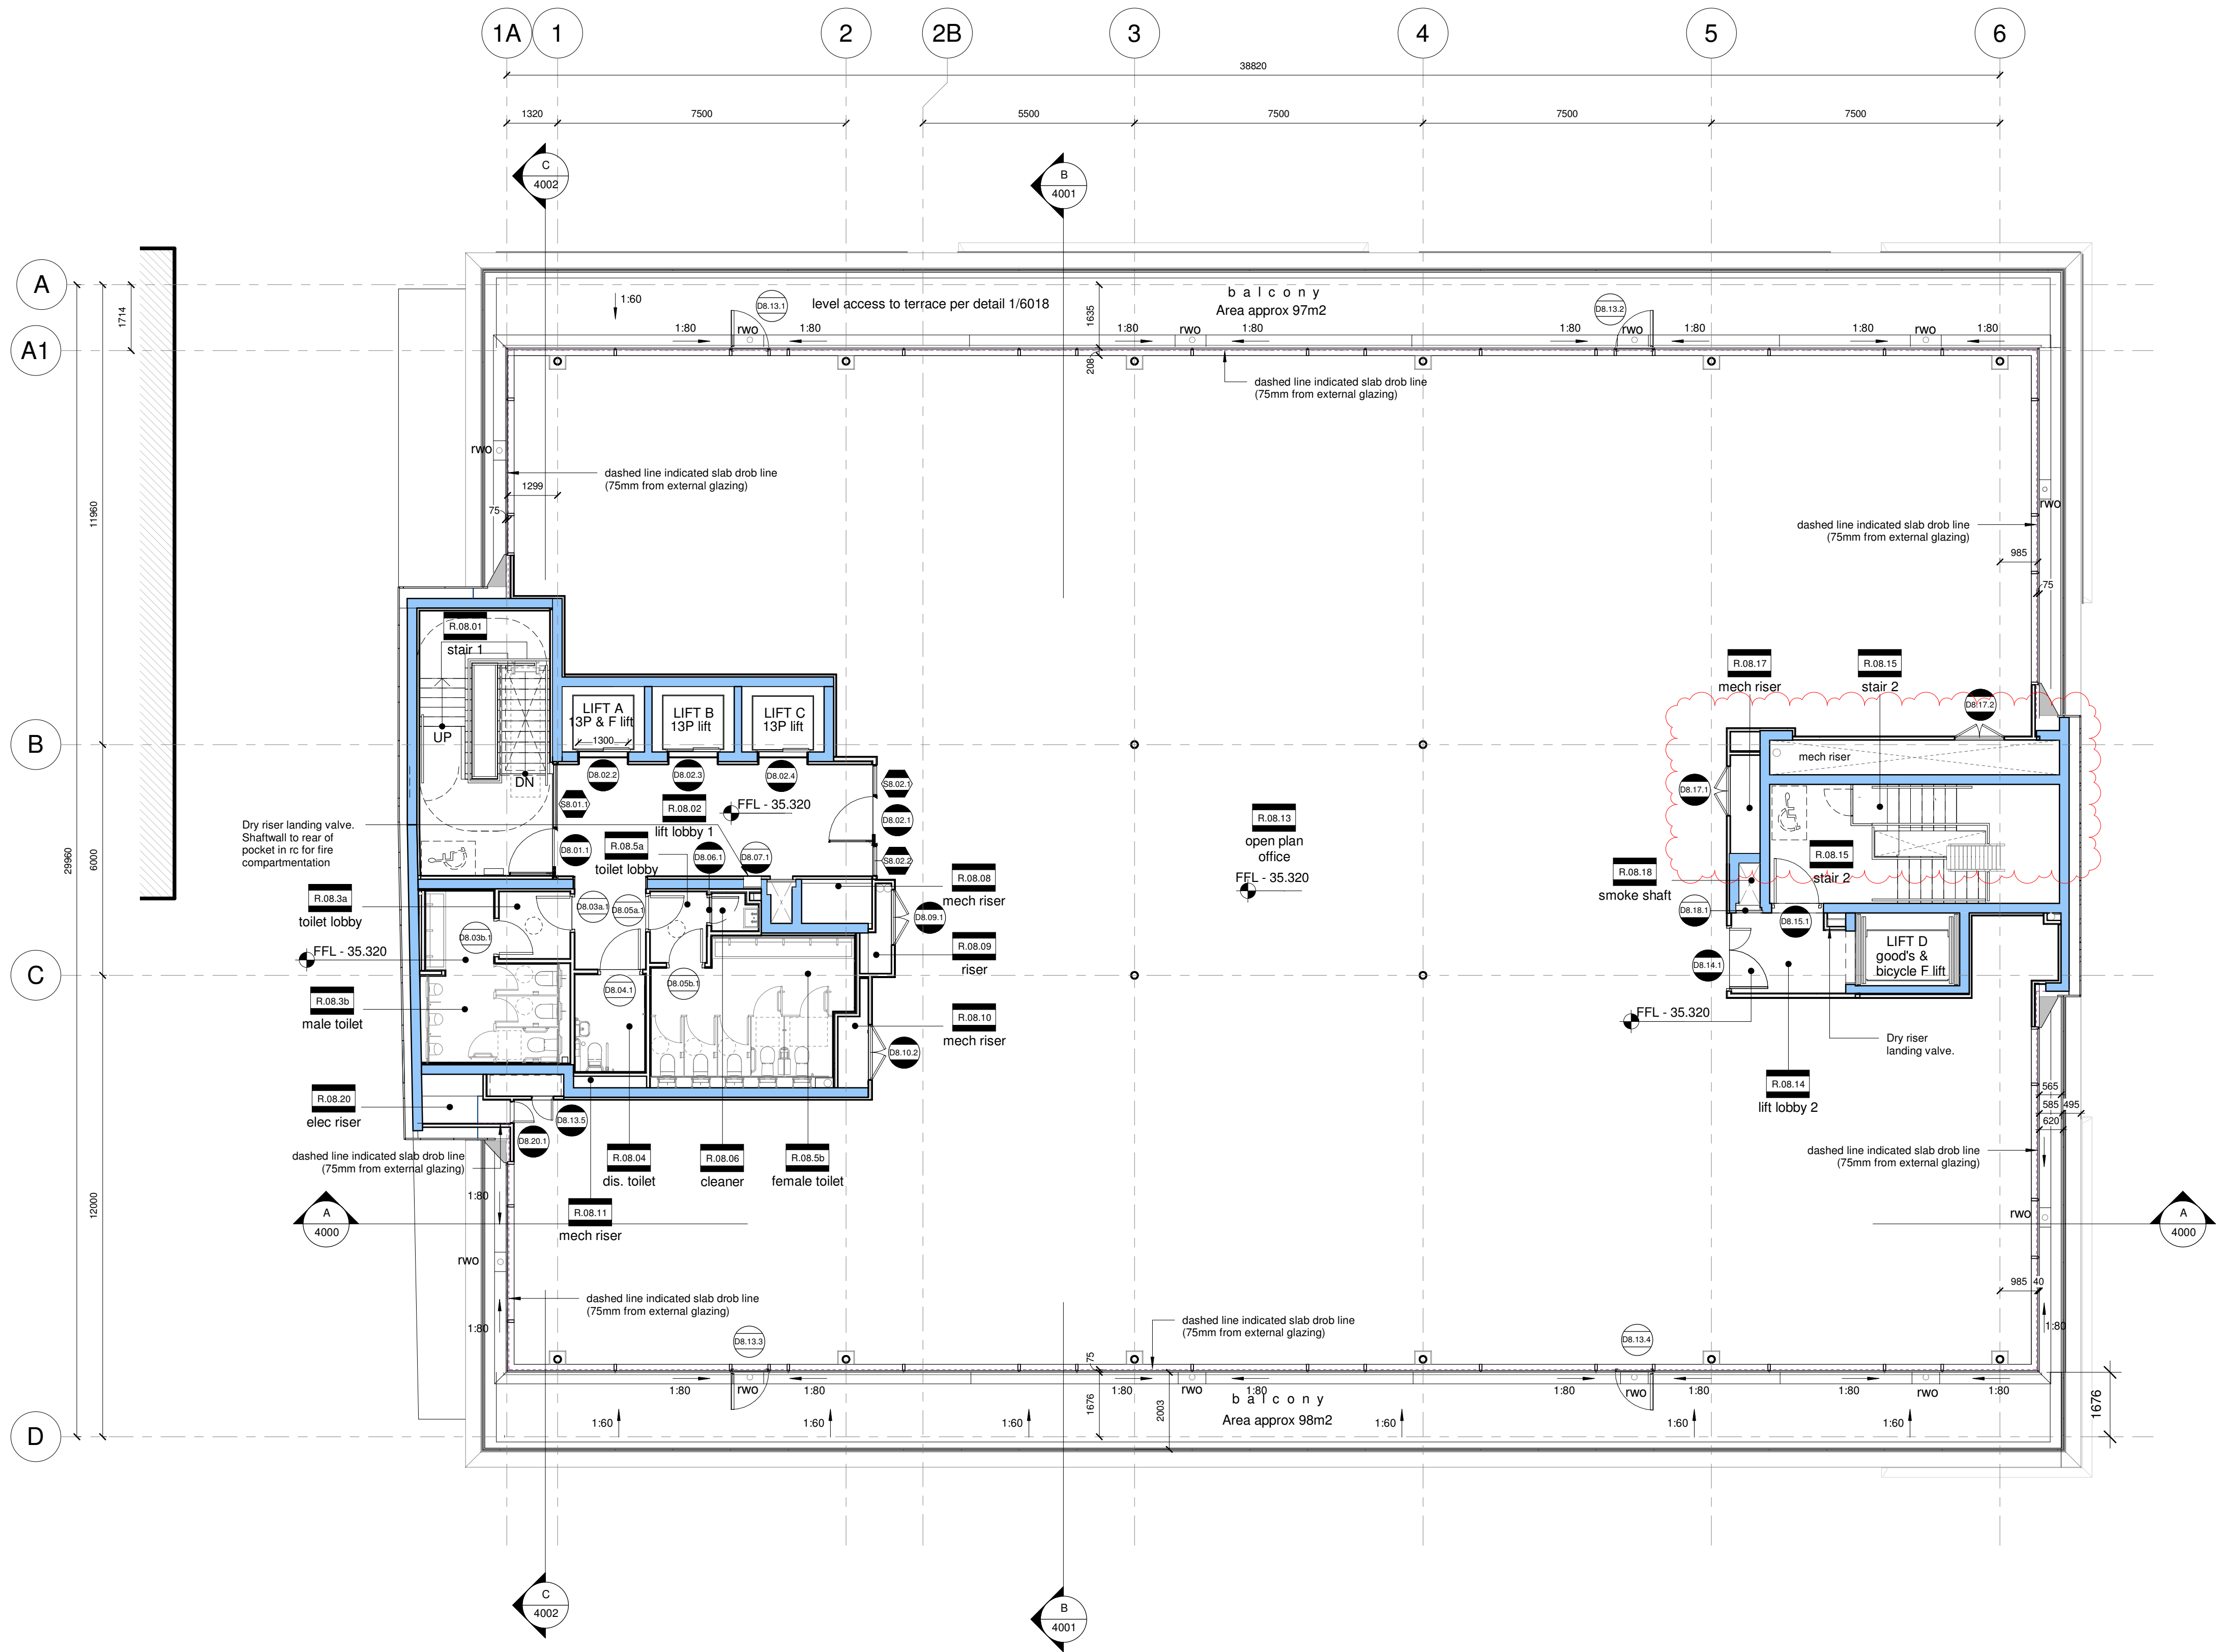

NOTES:

Check all dimensions on site. Do not rely on scaled dimensions. This drawing must be read in conjunction with all relevant contract documents.

This drawing is the property of Michael Collins Associates Ltd. (trading as MCA Architects). The drawing shall not be copied, reproduced or otherwise used without the consent of Michael Collins Associates Ltd.

Legend:

--- site boundary

Door with no fire rating requirement

Fire resisting door(set) achieving 30 minutes integrity\ rating in accordance with BS 476: Part 8/22 and fitted with an appropriate self closer and a cold smoke seal which limits the leakage past the hean and jambs of the door to 3m3/m/hour when subject to a pressure of 25 Pascals.

Fire resisting door(set) achieving 60 minutes integrity\ rating in accordance with BS 476: Part 8/22 and fitted with an appropriate self closer and a cold smoke seal which limits the leakage past the hean and jambs of the door to 3m3/m/hour when subject to a pressure of 25 Pascals.

Screen with no fire rating requirement

Fire rated glazing/screen acheiving 30 minute fire resistant rating (integrity & insulation) to a height of 2.0m above floor level in accordance with BS 476: Part 8/ 20-24 and relevant provisions of Section 7 of BS 9999: 2017

Fire rated glazing/screen acheiving 60 minute fire resistant rating (integrity & insulation) to a height of 2.0m above floor level in accordance with BS 476: Part 8/ 20-24 and relevant provisions of Section 7 of BS 9999: 2017

structural frame by structural engineer

Rev	Date	Description	Dm	Chkd
C01	31/05/22	Issued for Construction	MD	SS
C02	17/11/22	Implications of FSC Grant: Western boundary, thermal line, and annotation clarifications	MD	SS
C03	07/07/23	Roof falls added	BW	SS
C04	26/07/23	Core 1 Lobby door moved for CFD	MD	SS
C05	15/11/23	Separating wall added to riser as per DMG request	MD	SS
C06	30/11/23	Internal doors adjusted graphically	BW	MD
C07	11/12/23	Revision to core 02 as clouded	BW	MD

MCA
ARCHITECTS

Architecture + Interior Design + Masterplanning + Project Management

4 Harover Wharf,
Asgard Road,
Dublin 2, Ireland

+353 1 6760916
info@mca.ie
www.mca.ie

Client: ALSTEAD SECURITIES LTD

Project: 157/164 TOWNSEND STREET

Drawing: PROPOSED EIGHTH FLOOR - GENERAL ARRANGEMENT PLAN

Stage: CONSTRUCTION

Status: FOR CONSTRUCTION

Drawing Number: TSH-MCA-00-08-DR-A-3800

Job No:

2022.09

Sheet: A1

Scale: 1 : 100

Status Code: A

Revision:

C07