


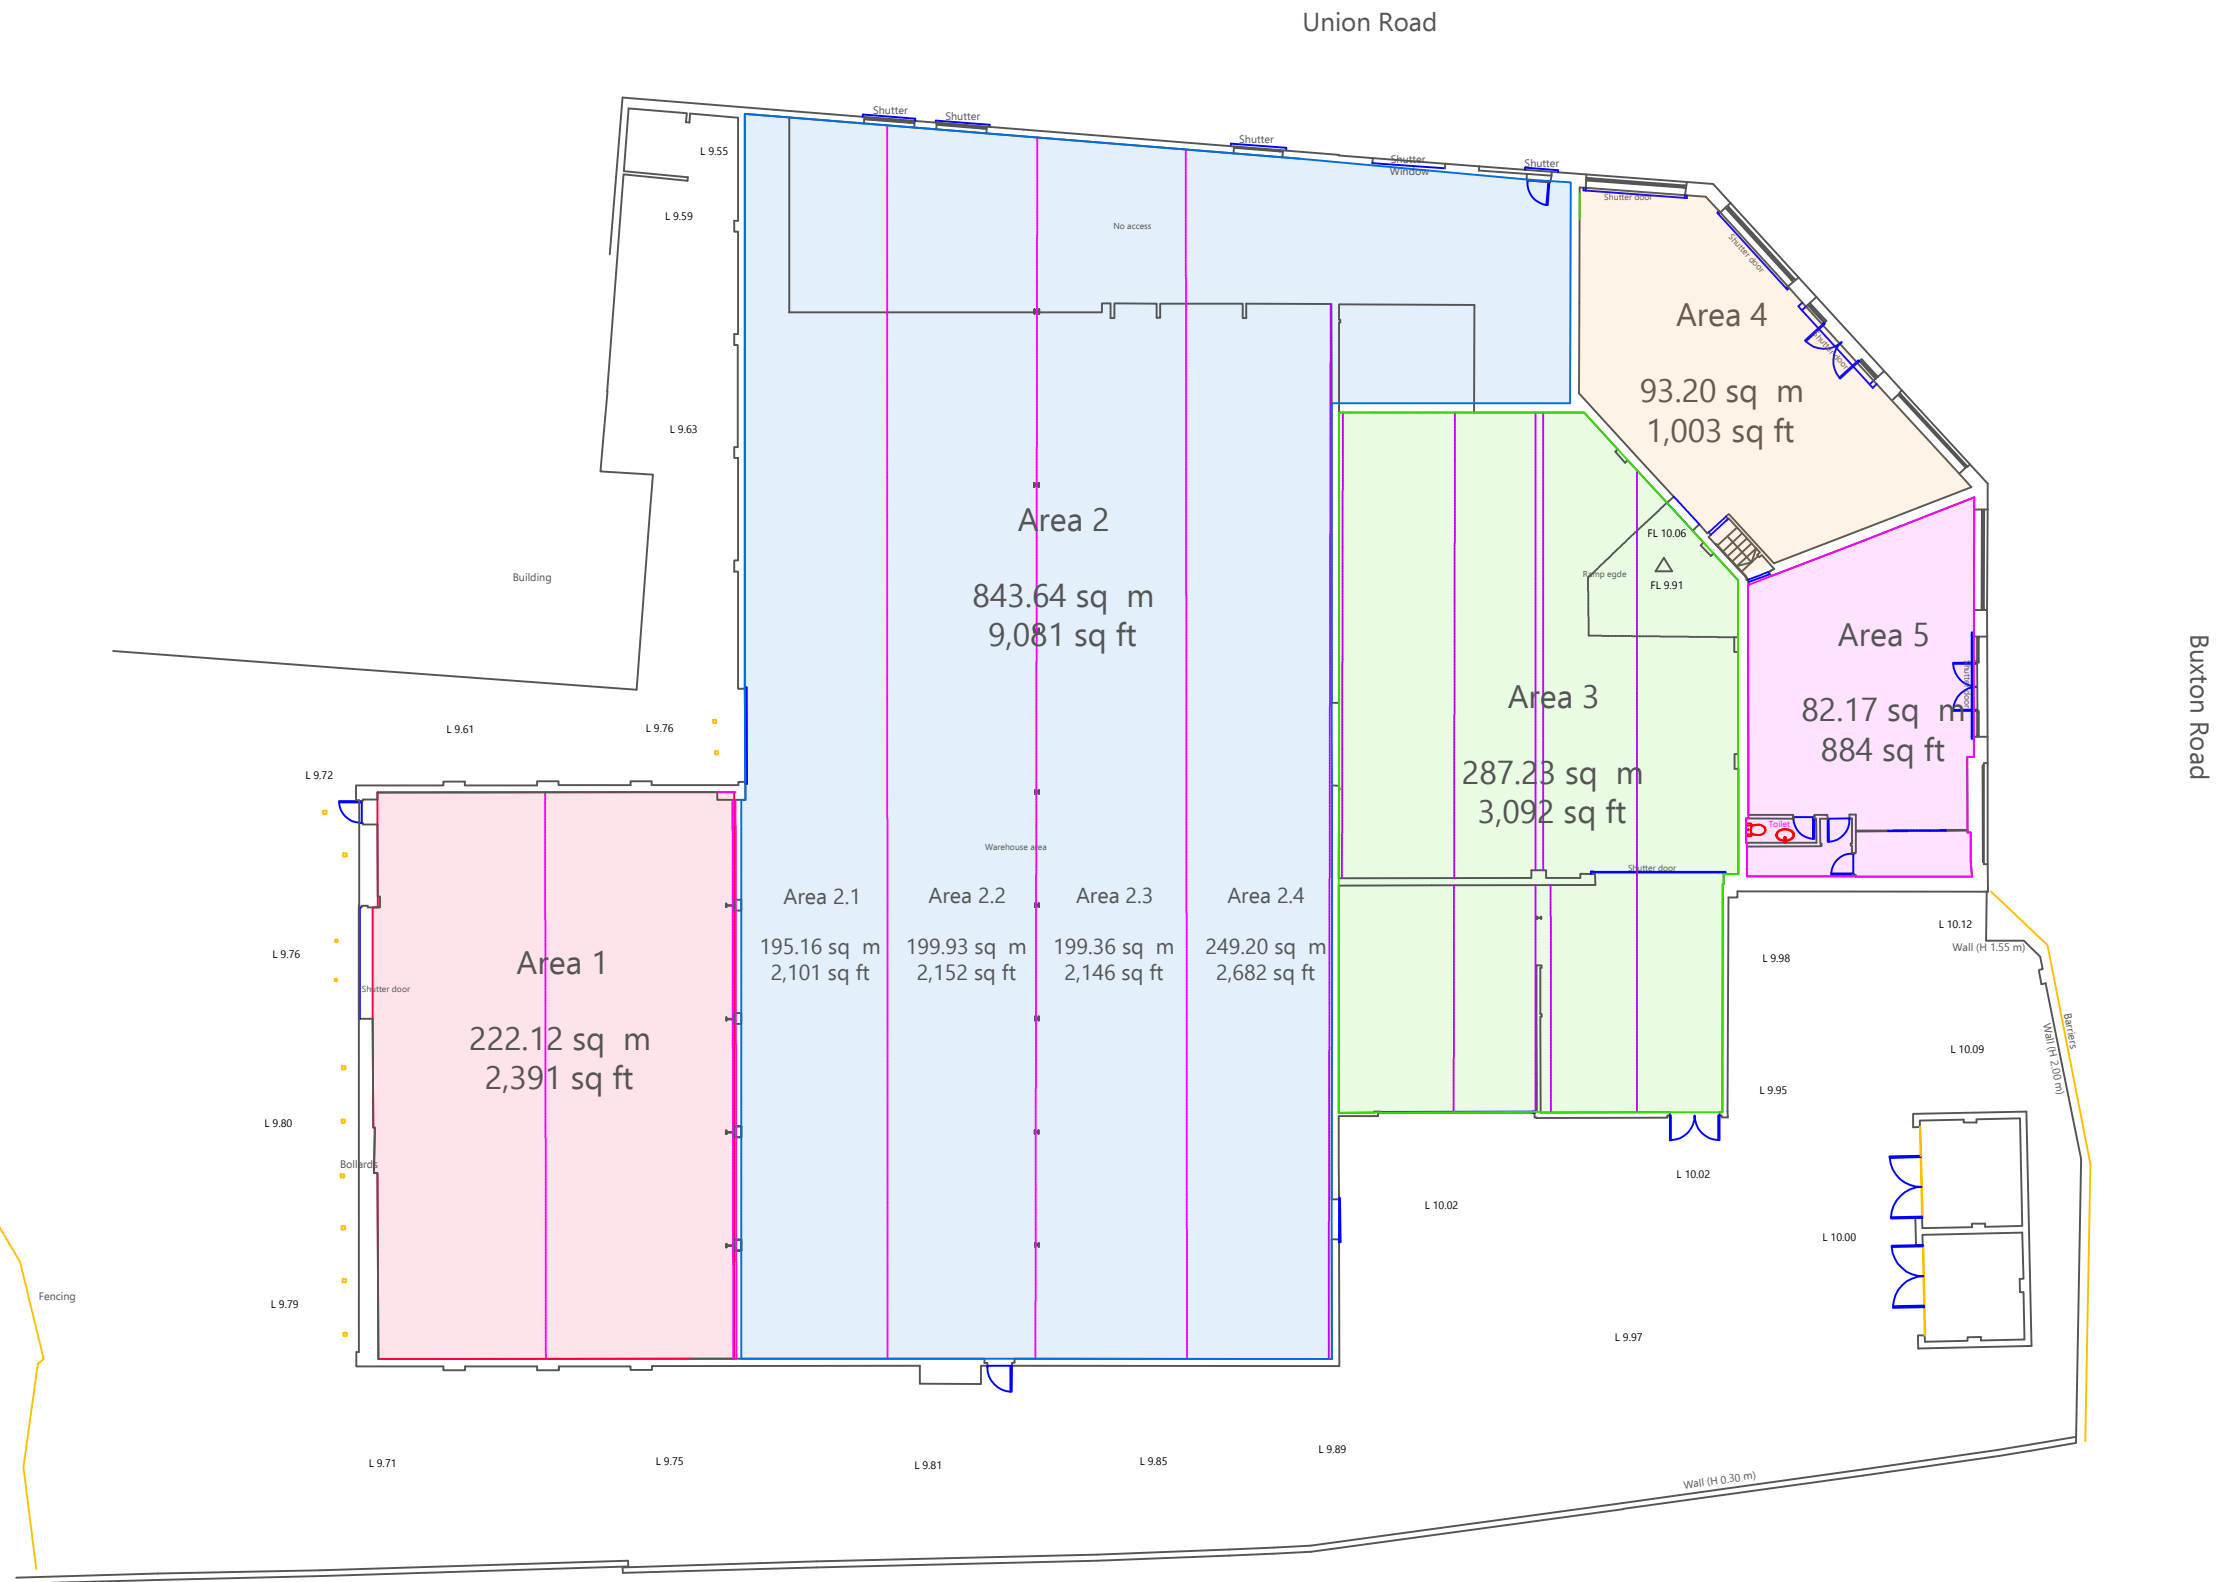

		Asda Buxton Road				Notes: - Dimensions are measured in meters - Areas converted from m² to ft² using a factor of 10.764. - All dimensions should be checked on site prior to construction. - Hatching indicates inaccessible areas where a professional estimated has been made - Assumed wall lines are shown as dashed. - Floor Level set from arbitrary value of 10m at external floor level.	 9 Bartle House Manchester M2 3WQ W: robertsonelliot.co.uk
		Address					
		Full Site Plan					
		Revision	Job No	Date			
		2	095	20/04/26			
Scale	Drawn By	Checked By					
1:250@A3	DE	AH					