



6TH FLOOR PLAN 1:100

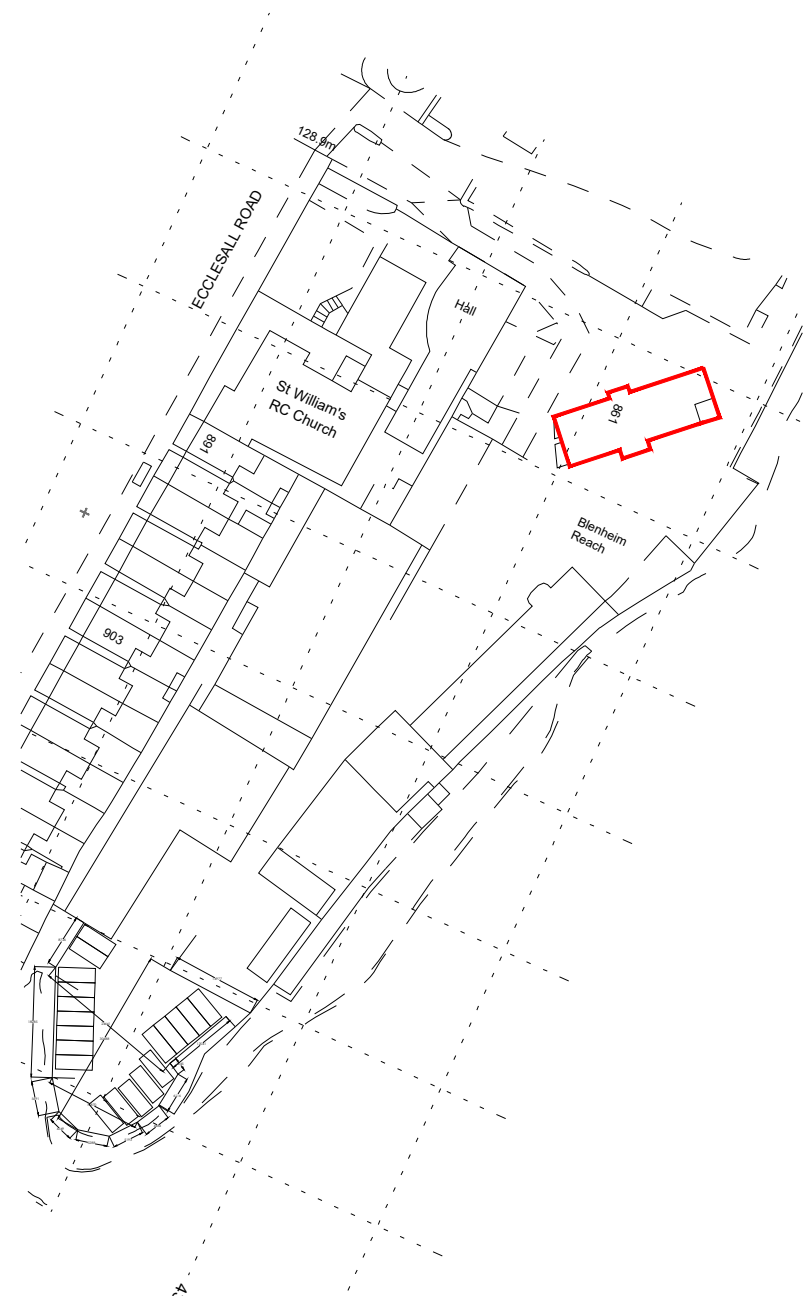

LOCATION PLAN 1:1250

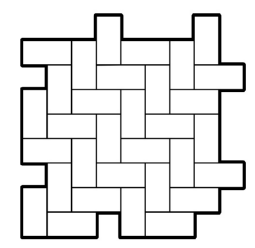

**ROWLEY
SURVEYING
LTD**
Land & Building Measurement

PROJECT NAME:
MEASURED_SURVEY_OF_EXISTING_BUILDING

DRAWING TITLE:
BLENHEIM_REACH_ECCLESALL_ROAD_SHEFFIELD_SOUTH_YORKSHIRE

DRAWN BY:
T Rowley

CHECKED BY:
M Rowley

APPROVED BY:
K Beck

DATE:
10/03/2026

The Old Colliery Offices
Colliery Road
Kiveton Park
Sheffield
S26 6LR
Tel. 07594093398
tim@rowleysurveying.com
www.rowleysurveying.com
www.rowleysurveyingltd.co.uk

LR TITLE PLANS
GNSS SURVEYS
SUAV IMAGERY
BOUNDARY SURVEYS
3D LIDAR SCANNED IMAGERY
LAND & BUILDING MEASUREMENT

SCALE:
1:100 1:1250

DRAWING NO:
04

REVISION:
-

UNIT:
-

PROJECT NO:
SHEET SIZE:
A3

