

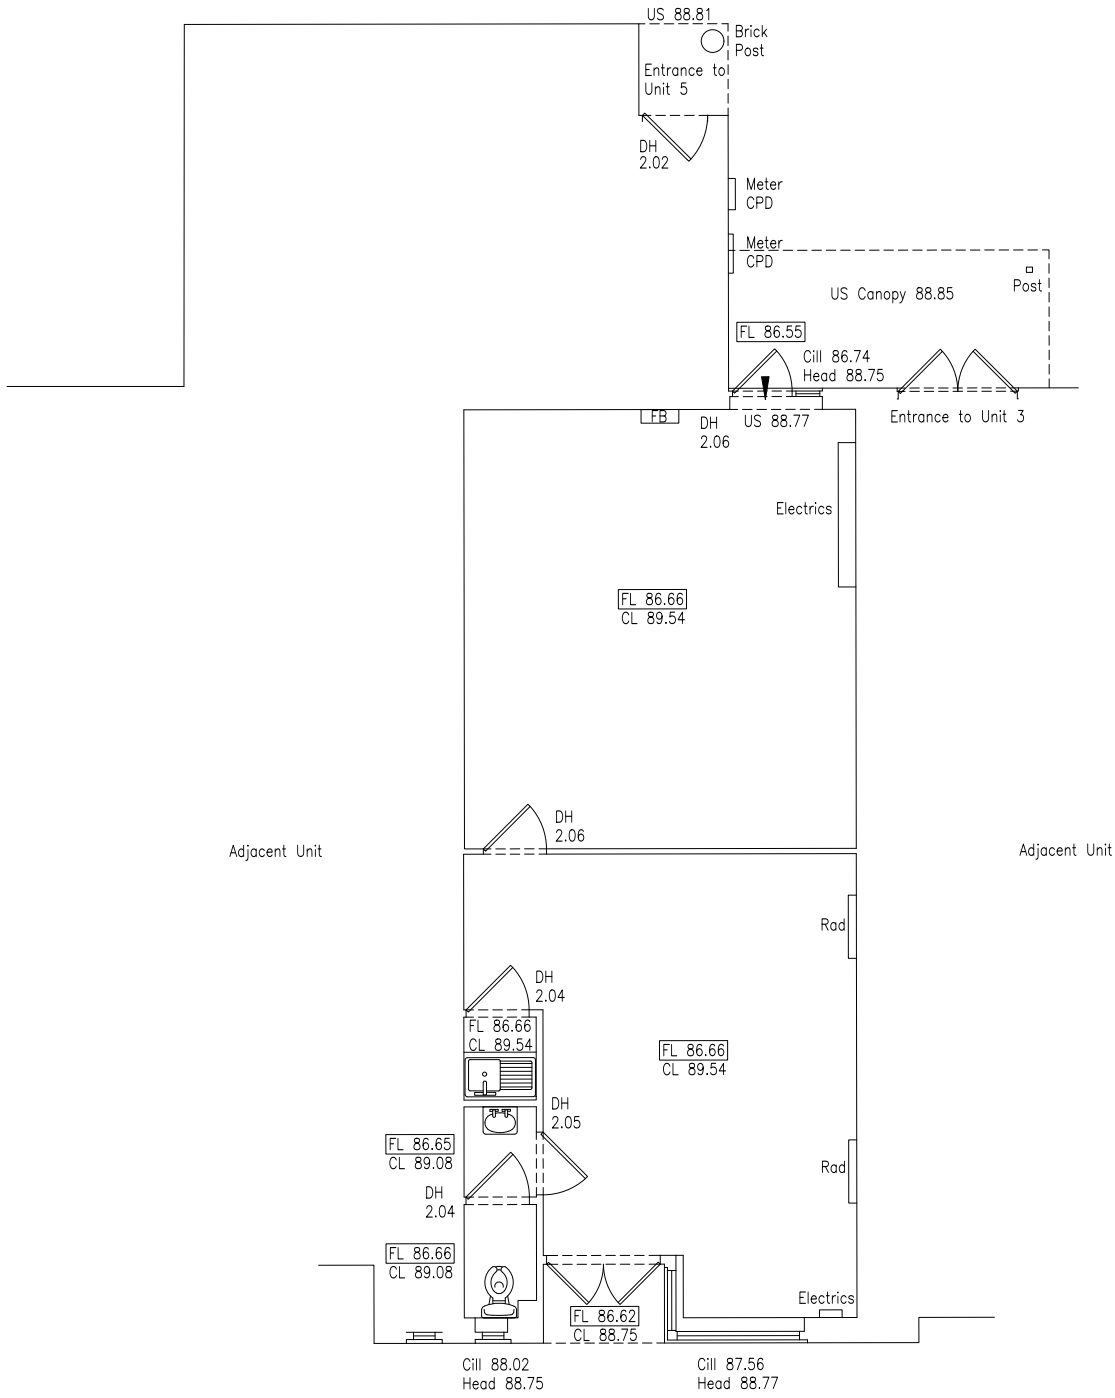
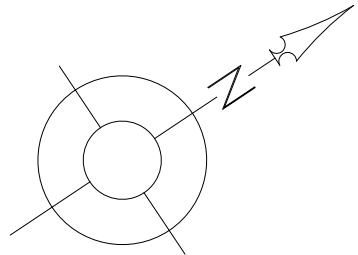


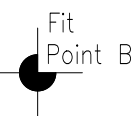

GROUND FLOOR PLAN

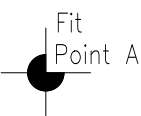

Legend:

Abbreviated Features:

AB

Air Brick

B

Bolard

C/B

Cable Banded

C-H

Cable to Head

C/L

Chain Link

CL

Ceiling Level

CPD

Cupboard

CR

Crown Point Level

DH

Door Height

Dr

Drain

FE

Fire Exit

F-C

Floor to Cill

FL

Floor Level

FW

Foul Water

MH

Manhole

G

Gully

IC

Inspection Chamber

IL

Invert Level

I/R

Iron Railings

LI

Light

D/F

Overflow Pipe

P

Post

P/C

Pitched Ceiling

PE

Pipe

P/R

Pitched Roof

P/W

Post & Wire

RD

Roller Door

R

Rodding Eye

RNP

Rainwater Pipe

SD

Sliding Doors

SSL

Suspended Ceiling Level

SP

Spring Point Level

SW

Soil & Vent Pipe

SW

Surface Water

US

Understand

UTL

Understand to Lift

VP

Vent Pipe

V

Vent

Radiator

Light

Light

Emergency Light

Strip Light

Wall Mounted Light

Mains Point

Blank Plate

Light Switch

Pendant Switch

Isolator Switch

Alarm Bell

Fire Alarm Push

Snow Detector

Alarm Panel

Thermostat

Modern

Fuse Box

Electric Box

Heater

Water Stop Tap

Overhead Features

Plan Coordinate Control:-

N/A

Level Datum:-

All Levels relate to OSGB36 using GPS

Key:

Notes:

REV

NO

REV

NOTE

DATE

SIGNED

3 Brookfield, Duncan Close,
Moulton Park, Northampton, NN3 6WL
Tel: 01604 491543
Email: info@globalsurveys.co.uk

Site:

Unit 4, Drakes Mews
Crownhill
Milton Keynes, MK8 0ER

Client:

The Parks Trust

Survey Title:

Measured Building Survey
Ground Floor Plan

Date

January 2026

Scale

1/100 @ A1

Dwg No.

25524-MBS

Surveyor

JR

Sheet

1 of 1

Checked

SPH