



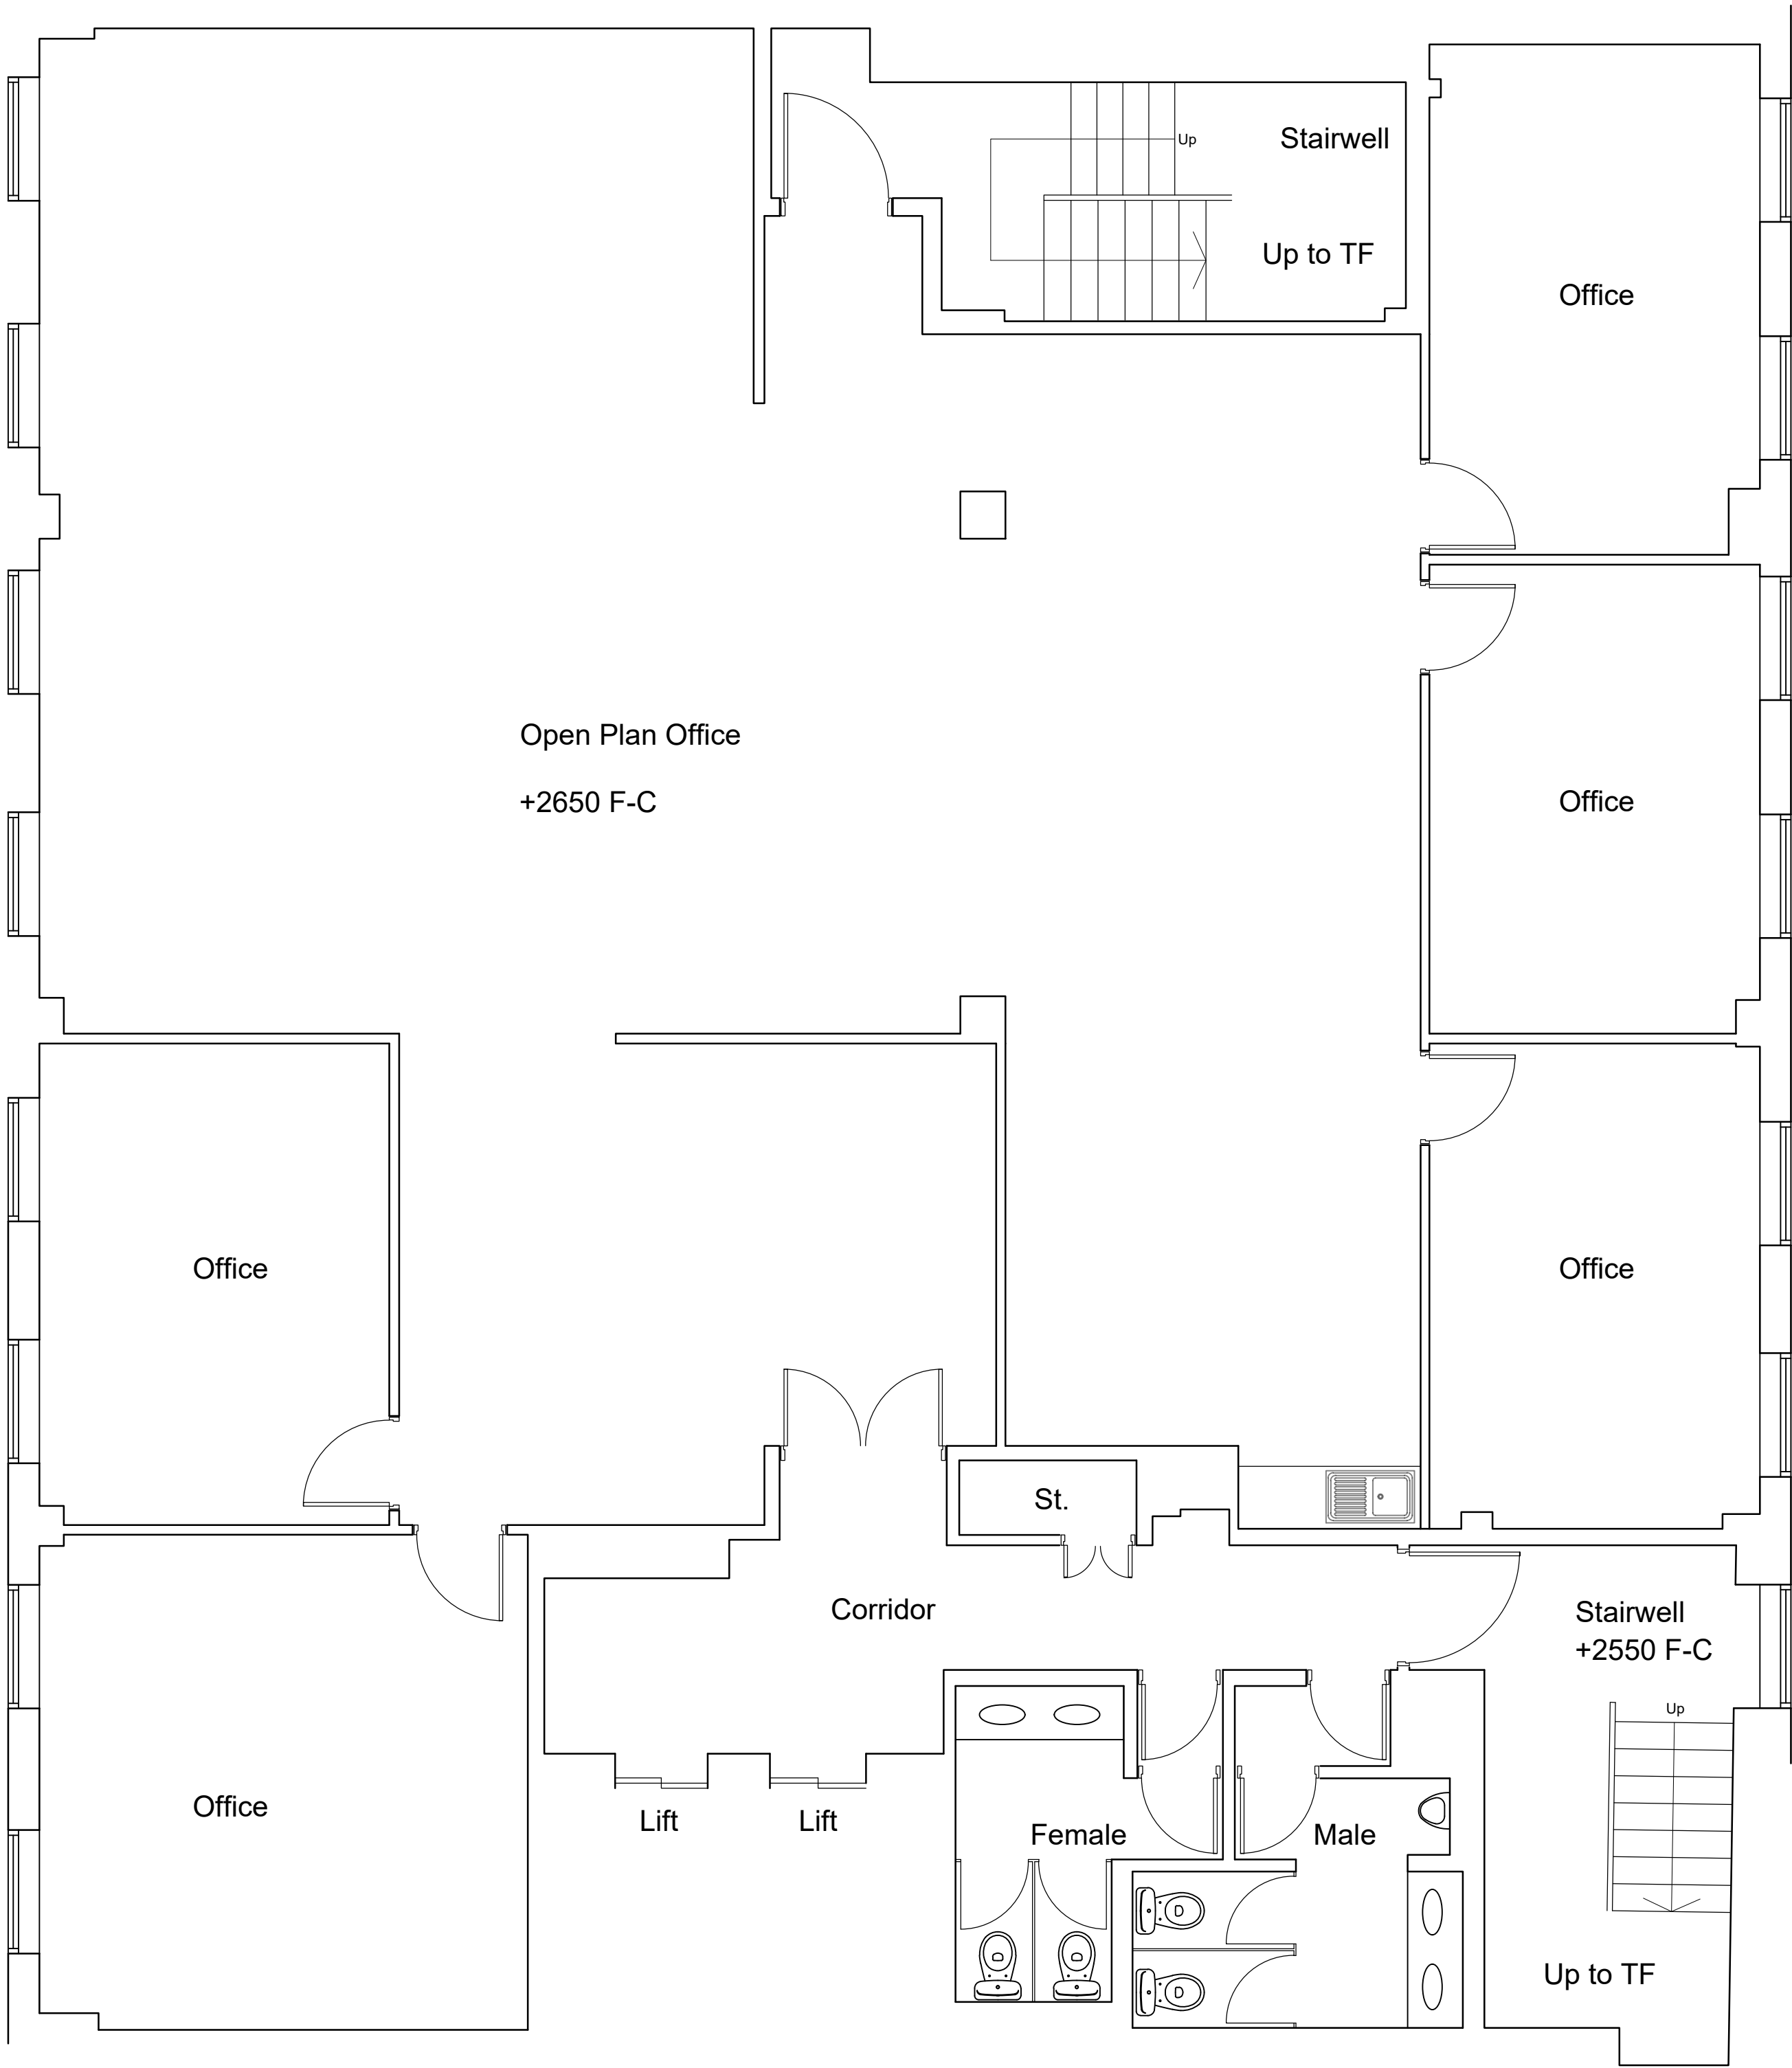

Rev: xx	Date: xx/xx/xxxx	Description: xxxx
PERSPECTIVE WWW.PERSPECTIVEBC.CO.UK INFO@PERSPECTIVEBC.CO.UK		
Client MRP		
Project Title: GENERAL ARRANGEMENT PLANS		
Drawing Title: SECOND FLOOR PLAN AS EXISTING		
Drawing Status FOR INFORMATION		
Project Reference Number PBC 2237	Date Drawn: Drawn By: Checked By:	10.05.2024 APD APD
Project Address 199 ST VINCENT STREET, GLASGOW, G2 5QD		
Drawing Number L 20 005		
Revision ---	Sheet Size / Scale: A1 / 1:50	

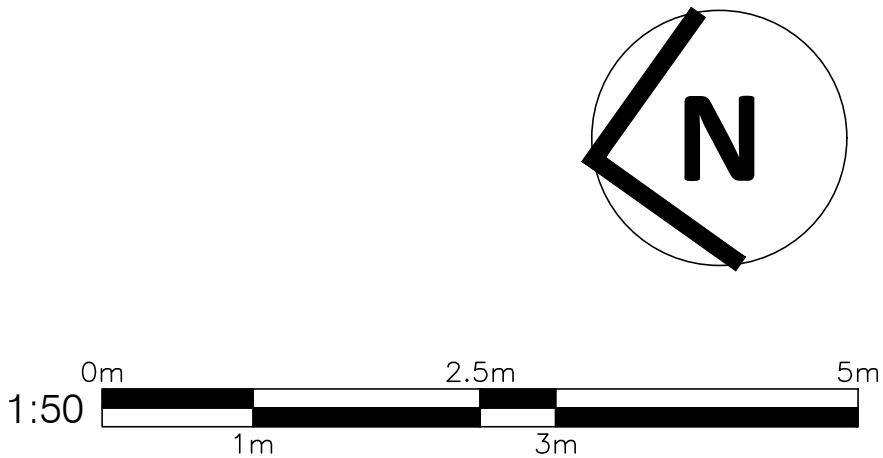

This document is the property of Perspective Building Consultancy Limited. Copyright is reserved by them and the drawing is issued on condition that it is not copied, reproduced or retained by, nor disclosed to any unauthorised person, either wholly or in part without the written consent of Perspective Building Consultancy Limited.

Drawings are for general arrangement only. Dimensions are to be checked on site by the contractor and any discrepancies are to be rectified in writing prior to commencement of work. When a drawing is covered by different scales the larger scale is to be worked to in all cases. Drawings are completed under client instruction and therefore submitted on the condition that the responsibility of compliance to all relevant authority and legal requirements, and of obtaining required approval, remains with the client.

DO NOT SCALE FROM THIS DRAWING