


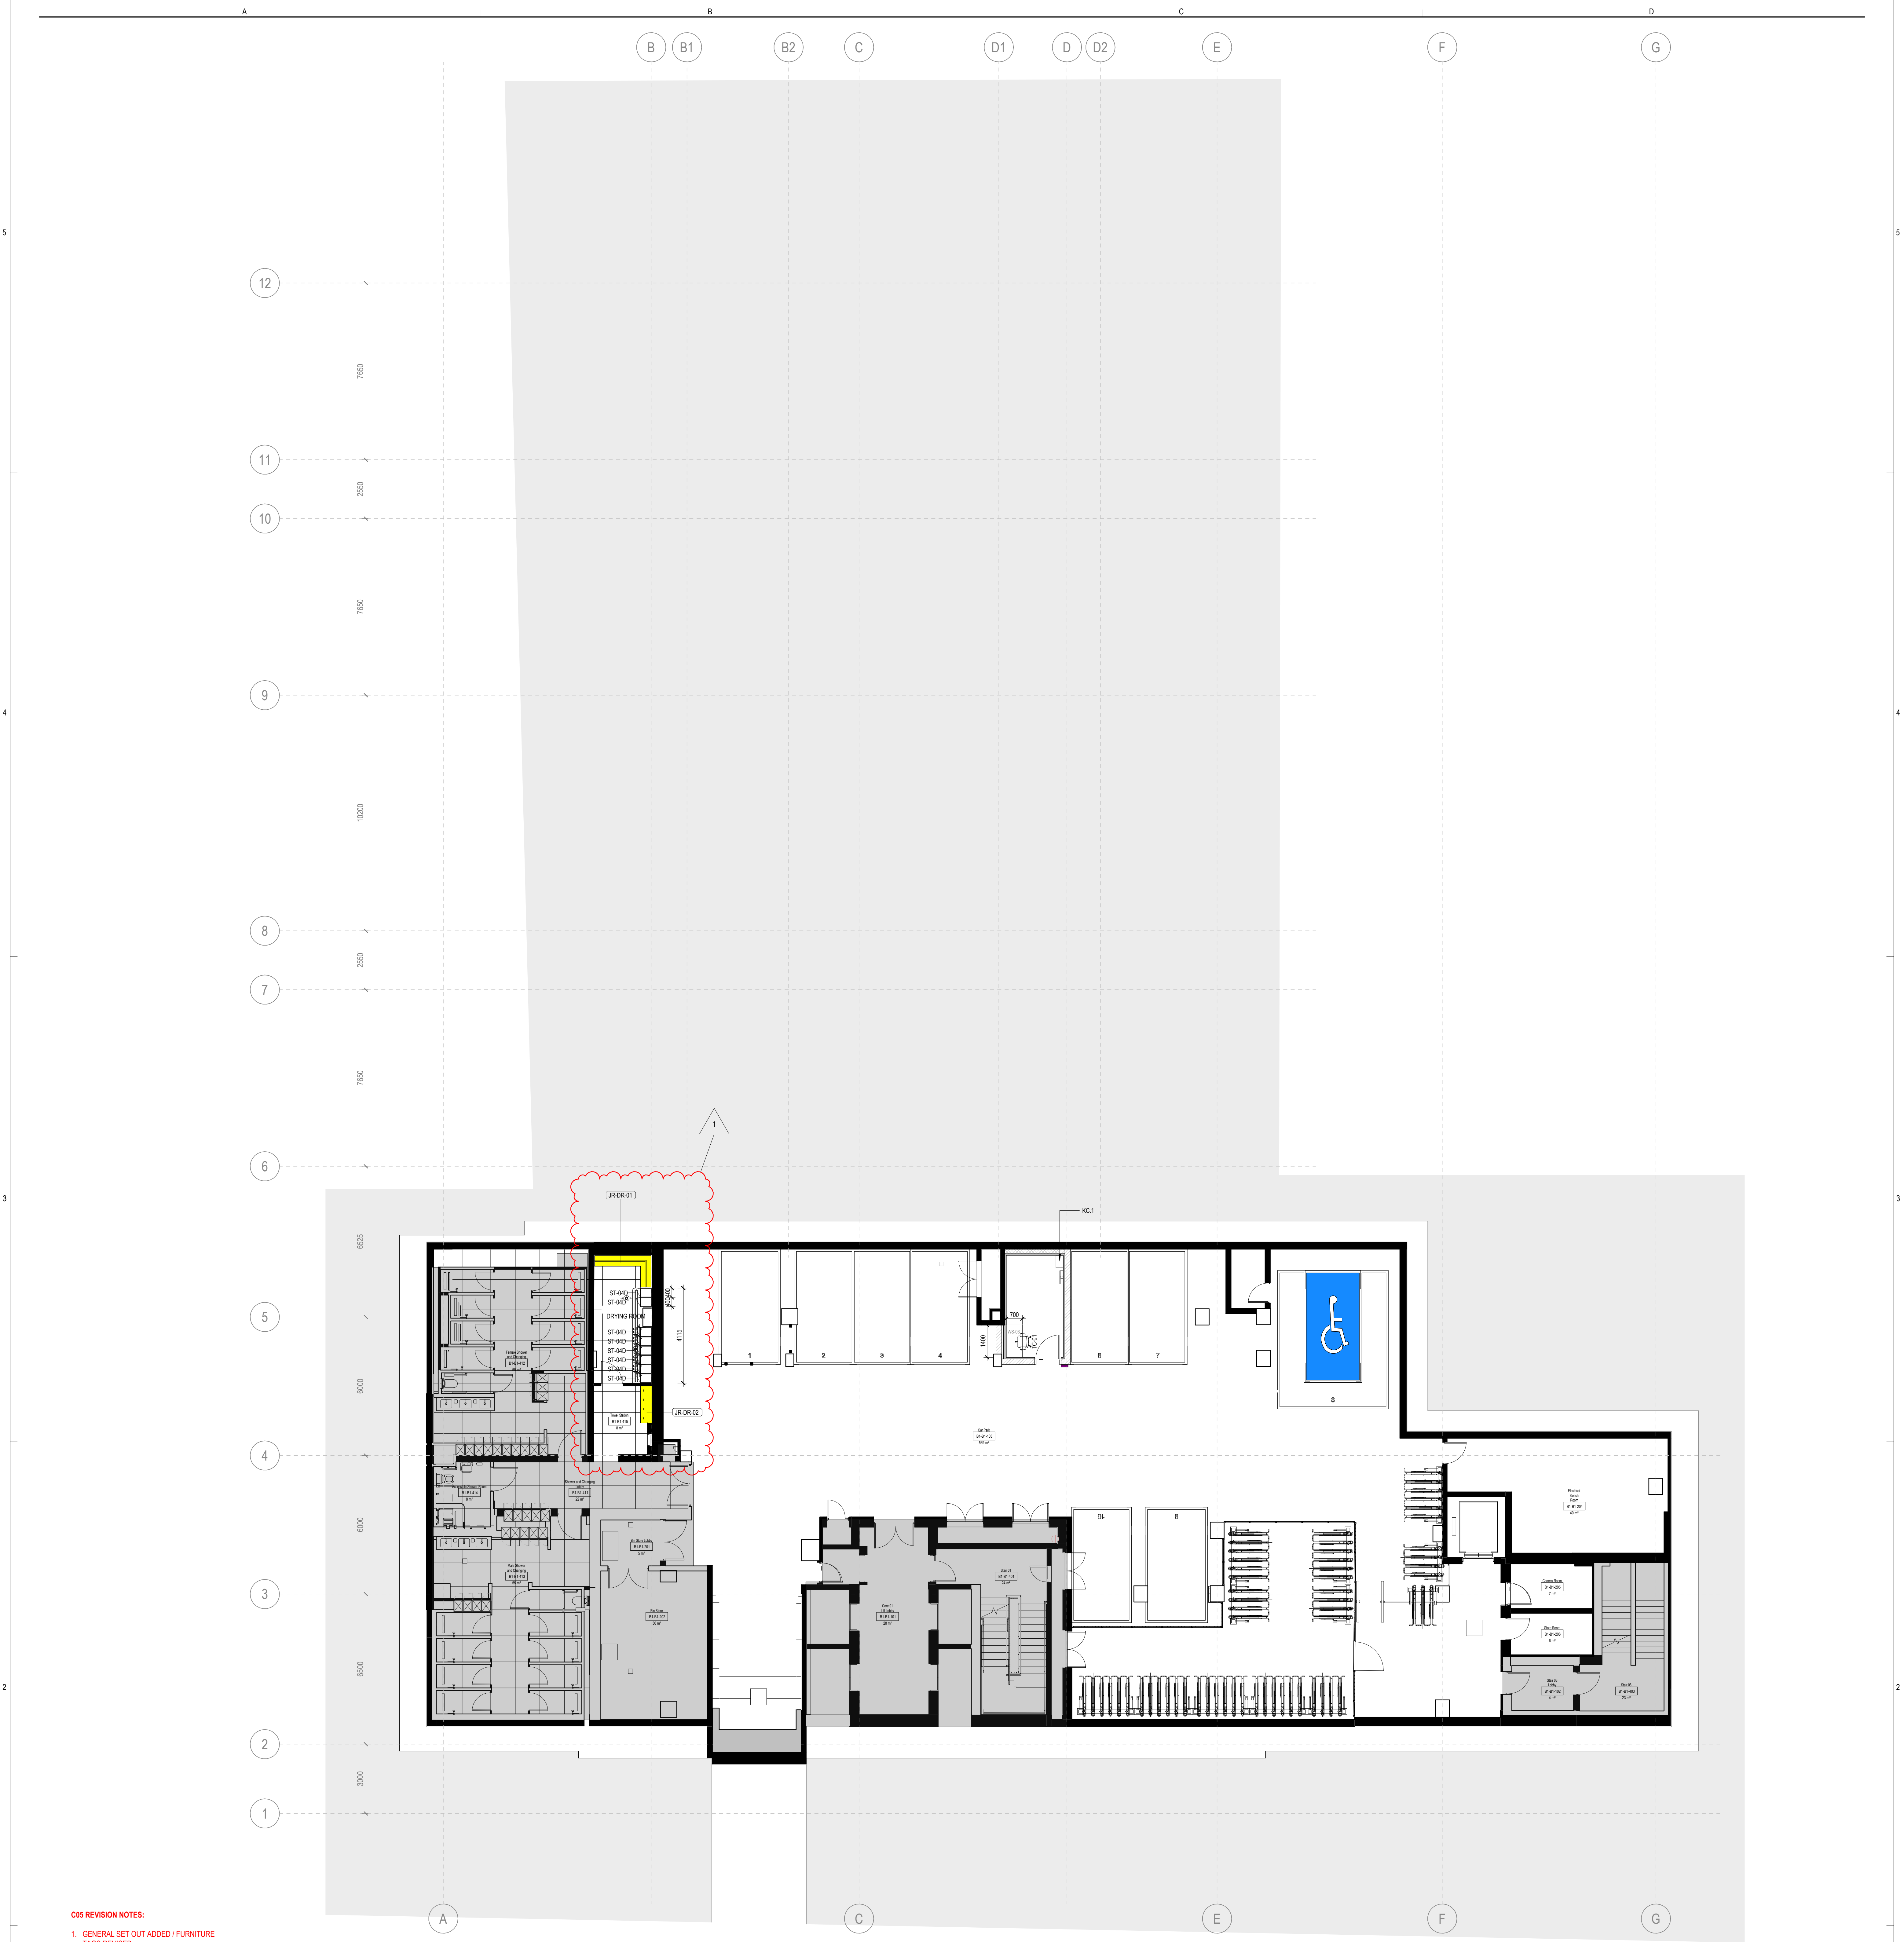

C05 REVISION NOTES:
1. GENERAL SET OUT ADDED / FURNITURE TAGS REVISED

FURNITURE PLAN LEGEND

SYMBOL	DESCRIPTION
ROOM NAME	ROOM / AREA NAME
22.00	ROOM NUMBER
(ZONE) + LEVEL NUMBER	
	DENOTES AREA OUT OF SCOPE. PLEASE NOTE INCLUSIONS WITHIN THIS AREA TO BE INCLUDED IN THE MAIN GC SCOPE OF WORKS INCLUDING BUT NOT LIMITED TO: - DEMOLITION AND MAKING GOOD OF ANY FINISHES FOR NEW ITAVISIGNAGE INSTALLATION - NEW SIGNAGE - REPAINT FURTHER TO COMPLETION OF THE WORKS - MAKING GOOD OF ALL FINISHES FURTHER TO COMPLETION OF THE WORKS

JOINERY ELEMENTS


NOTES:
1. FURNITURE SHOWN FOR REFERENCE AND COORDINATION PURPOSES ONLY.
2. FURNITURE TAGS TO MAINTAIN REQUIRED CLEARANCES AT ALL GORES IN THIS FIELD VERIFICATION REQUIRED FOR FINAL LAYOUTS PRIOR TO INSTALLATION.
3. DRAWING TO BE READ IN CONJUNCTION WITH GENERAL ARRANGEMENT PLANS AND FURNITURE SCHEDULE E AND SPECIFICATION.
4. FURNITURE SUPPLIERS TO PROVIDE AND COORDINATE ALL CABLE CONNECTION WITHIN MEETING ROOM TABLES WITH AV/TELECOMMUNICATIONS ENGINEER.
5. MAIN GC TO MANAGE AND COORDINATE INTERFACES BETWEEN FURNITURE, DATA AND ELECTRICAL SUPPLIES AND CONNECTIONS.
6. FOR RESPONSE / BUILT IN JOINERY DETAILS REFER TO GENERAL ARRANGEMENT PLANS AND JOINERY SCHEDULE. MAIN GC TO MANAGE AND COORDINATE INTERFACES BETWEEN FURNITURE AND JOINERY FINISHES ENSURING FINISHES AND COLOURS MATCH. FURNITURE AND JOINERY CONTRACTOR TO COORDINATE ALL FINISHES WHERE FINISHES SET BY SIDE OR IN CLOSE PROXIMITY.
7. MAXIMUM STAIR CAPACITY FROM 1ST FLOOR TO 5TH FLOOR IS 1046. THIS CANNOT BE INCREASED, HAVING A NUMBER ABOVE WHAT IS SHOWN AS OCCUPANCY IN FSC IS ACCEPTABLE SO LONG AS THE OVERALL NUMBER DOES NOT EXCEED THAT MEETING ROOMS DO NOT NEED TO BE INCLUDED IN TOTAL NUMBERS AS IT IS EXPECTED THAT THE MEETING ROOMS WILL BE USED BY THE REGULAR BUILDING OCCUPANTS.
JOINERY:
- HIGH END FINISHES TO BE SPECIFIED. FOR MORE INFORMATION, REFER TO FURNITURE SCHEDULE AND SPECIFICATION.
- SOFT CLOSING HINGES TO ALL DOORS
- FULLY EXTENDABLE CONCEALED DRAWERS WITH INTEGRATED SOFT CLOSING MECHANISM TO ALL DRAWERS
- CUTLERY TRAY TO BE FITTED IN THE TOP DRAWER
- COLOUR MATCHING RELATIVE TO ALL CABINETS
- SINKS, WASTE TRAYS AND TAPS TO BE PART M COMPLIANT
- ALL FININGS TO BE CONCEALED
- ALLOW FOR GENTS/COUTS & GRILLES FOR ALL UNITS WITH INTEGRATED EQUIPMENT
- REMOVABLE PANEL TO ALLOW THE ACCESS TO THE SERVICES IN ALL KNEE RECESS TO BE PROVIDED
- BUILT IN BENCHES AND UPHOLSTERED SEATINGS - HIGH QUALITY UPHOLSTERY TO BE PROVIDED
- INTEGRATED STRIP LED LIGHTING TO BE INTEGRATED INTO THE BASE OF ALL AC HANGING STORAGE UNITS
EQUIPMENT REQUIRED: REFER TO FURNITURE SCHEDULE AND SPECIFICATION. FOR CATERING EQUIPMENT REFER TO CATERING CONSULTANT DRAWINGS & SPECIFICATION
CORNER BENCH
- QUANTITY LOCATION: REFER TO ME, AV & IT DRAWINGS AND SPECIFICATIONS
- SOCKETS TO BE 150MM FROM THE EDGE OF THE BENCH AS PER ME SPECIFICATION. SOCKET AND SPURS TO BE PART M COMPLIANT
- SPURS REQUIRED FOR ALL SOCKETS NOT READILY ACCESSIBLE, AS PER ME SPECIFICATION
OTHER:
- SITE SURVEY/ CLOSE COORDINATION BETWEEN JOINERY AND PARTITIONS REQUIRED
ALL DIMENSIONS TO BE CONFIRMED ON SITE PRIOR TO PRODUCTION AND INSTALLATION

TYPES OF BINS:

- MIXED RECYCLING
- GENERAL WASTE
- FOOD WASTE
- CONFIDENTIAL WASTE
- LIQUID WASTE
- TRAY RETURN TROLLEY
- INTEGRATED, PULL OUT DOMESTIC STYLE BIN WITH 3 COMPARTMENTS: GENERAL FOOD & RECYCLING.

JOINERY SCHEDULE

CODE	DESCRIPTION	QTY
JB-CA-01	Plantry - Type A	1

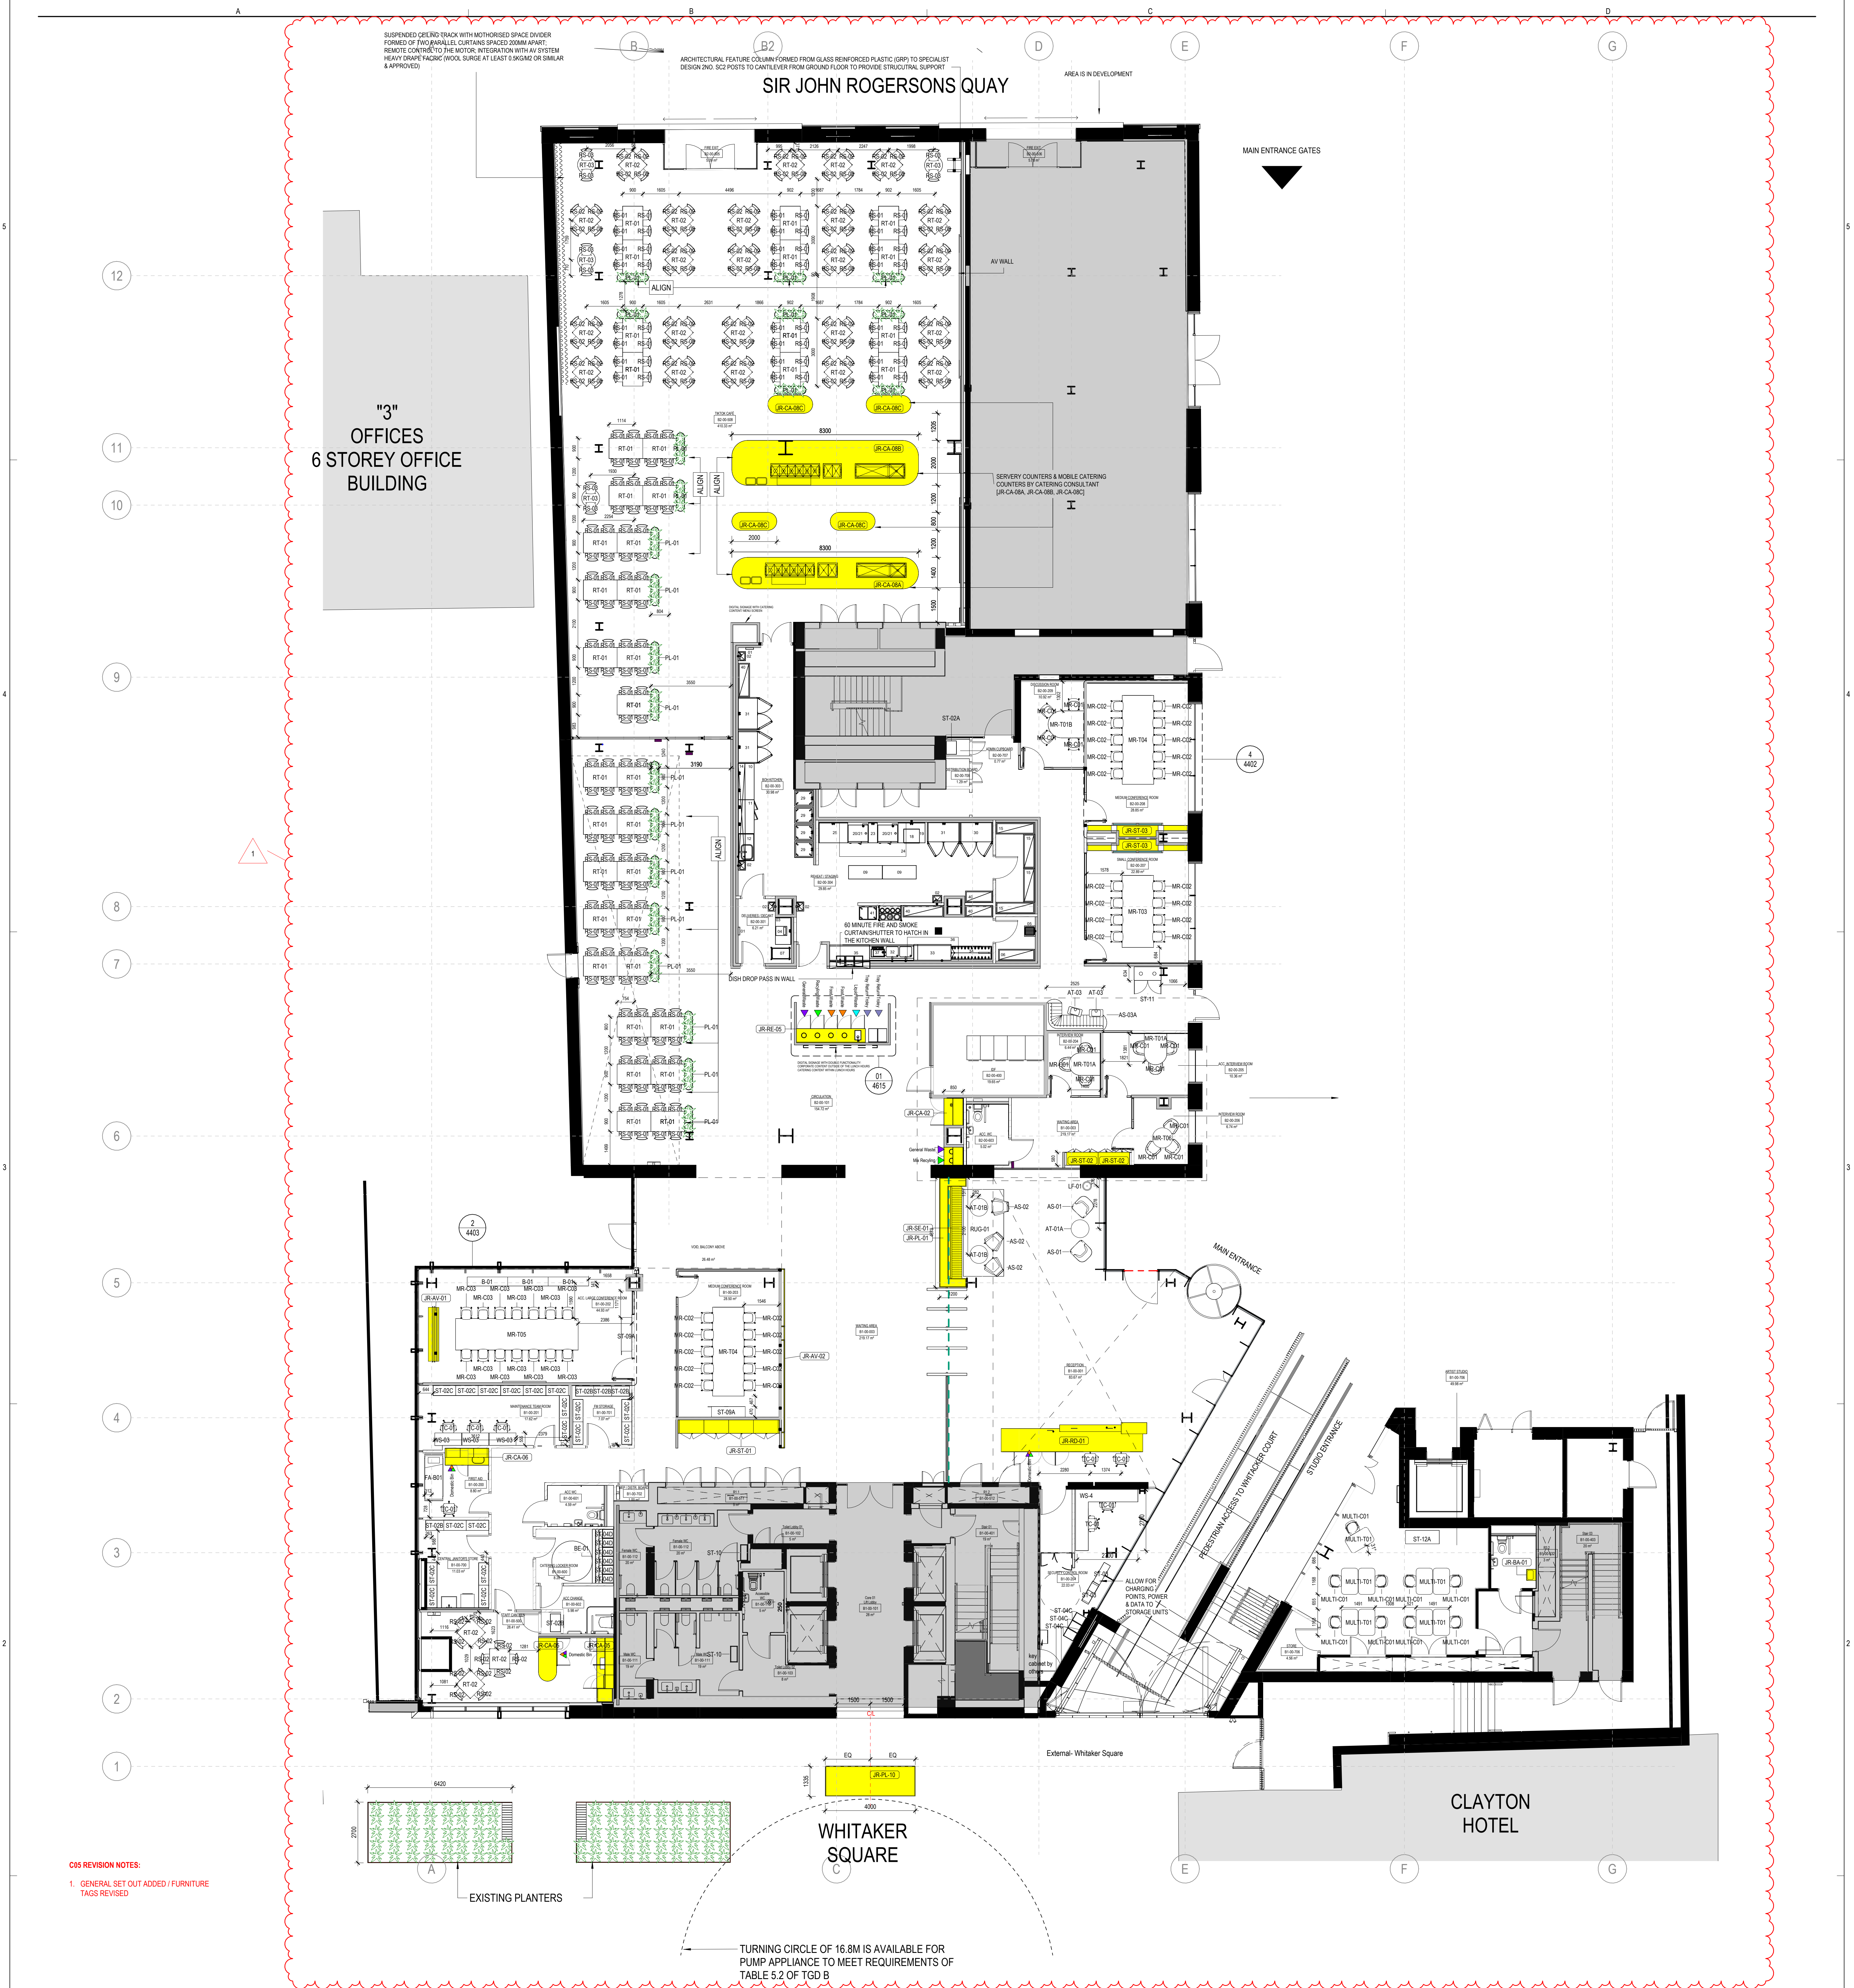

FURNITURE PLAN LEGEND

SYMBOL	DESCRIPTION
ROOM NAME	ROOM / AREA NAME
ROOM NUMBER	ROOM NUMBER
(ZONE) - LEVEL NUMBER	

Denotes area out of scope. Please note inclusions within this area to be included in the main GC scope of works including but not limited to:

- DEMOLITION AND MAKING GOOD OF ANY FINISHES FOR NEW ITA/SIGNAGE INSTALLATION
- NEW SIGNAGE
- REPAINT FURTHER TO COMPLETION OF THE WORKS
- MAKING GOOD OF ALL FINISHES FURTHER TO COMPLETION OF THE WORKS

JOINERY ELEMENTS

NOTES:

- FURNITURE SHOWN FOR REFERENCE AND COORDINATION PURPOSES ONLY.
- FURNITURE DEALER TO MAINTAIN REQUIRED CLEARANCES AT ALL EGRESS PATHS. FIELD VERIFICATION REQUIRED FOR FINAL LAYOUTS PRIOR TO INSTALLATION.
- DRAWING TO BE READ IN CONJUNCTION WITH GENERAL ARRANGEMENT PLANS AND FURNITURE SCHEDULE AND SPECIFICATION.
- FURNITURE SUPPLIERS TO PROVIDE AND COORDINATE ALL CABLE CONNECTION WITHIN MEETING ROOM TABLES WITH AV/TELECOMMUNICATIONS. MAIN GC TO MANAGE AND COORDINATE INTERFACES BETWEEN FURNITURE, DATA AND ELECTRICAL SUPPLIES AND CONNECTIONS.
- FOR REPAIRS: BUILT IN JOINERY DETAILS REFER TO GENERAL ARRANGEMENT PLANS AND JOINERY SCHEDULE. MAIN GC TO MANAGE AND COORDINATE INTERFACES BETWEEN FURNITURE AND JOINERY FINISHES ENSURING FINISHES AND COLOURS MATCH FURNITURE AND JOINERY CONTRACTOR TO COORDINATE ALL FINISHES WHERE FINISHES SIT SIDE BY SIDE OR IN CLOSE PROXIMITY.
- MAXIMUM STAIR CAPACITY FROM 1ST FLOOR TO 2ND FLOOR IS 1046. THIS CANNOT BE INCREASED. HAVING A NUMBER ABOVE WHAT IS SHOWN AS OCCUPANCY IN FSC IS ACCEPTABLE SO LONG AS THE OVERALL NUMBER DOES NOT EXCEED 1046. MEETING ROOMS DO NOT NEED TO BE INCLUDED IN TOTAL NUMBERS AS IT IS EXPECTED THAT THE MEETING ROOMS WILL BE USED BY THE REGULAR BUILDING OCCUPANTS.

JOINERY:

- HIGH-END FINISHES TO BE SPECIFIED. FOR MORE INFORMATION REFER TO FURNITURE SCHEDULE AND SPECIFICATION.
- SOFT CLOSING HINGES TO ALL DOORS.
- FULLY EXTENDABLE CONCEALED RUNNERS WITH INTEGRATED SOFT-CLOSING MECHANISM TO ALL DRAWERS.
- CUTLERY TRAY TO BE FITTED IN THE TOP DRAWER.
- COORDINATING HINGES TO ALL CABINETS.
- SINKS, WASTE TRAPS, AND TAPS TO BE PART M COMPLIANT.
- ALL FINISHES TO BE CONCEALED.
- ALLOW FOR VENTILATION GRILLES FOR ALL UNITS WITH INTEGRATED EQUIPMENT.
- REMOVABLE PANELS TO ALLOW THE ACCESS TO THE SERVICES. ALL REPAIRS TO BE PROVIDED.
- BUILT IN BENCHES AND UNPOLISHED PILES - HIGH QUALITY UNPOLISHED TO BE PROVIDED.
- INTEGRATED STRIP LED LIGHTING TO BE INTEGRATED INTO THE BASE OF ALL ALCOHOL HANDLING STORAGE UNITS.
- EQUIPMENT REQUIRED: REFER TO FURNITURE SCHEDULE AND SPECIFICATION. FOR CATERING EQUIPMENT REFER TO CATERING CONSULTANT DRAWINGS & SPECIFICATION.
- POWER & DATA.
- QUANTITY LOCATION - REFER TO M&E, AV & IT DRAWINGS AND SPECIFICATIONS.
- SOCKETS TO BE 100MM FROM THE EDGE OF THE SINK. AS PER M&E SPECIFICATION, SOCKET AND SPURS TO BE PART M COMPLIANT.
- SPURS REQUIRED FOR ALL SOCKETS NOT READILY ACCESSIBLE AS PER M&E SPECIFICATION.
- OTHERS:
- SITE SURVEY/CLOSE COORDINATION BETWEEN JOINERY AND PARTITIONS REQUIRED.
- ALL DIMENSIONS TO BE CONFIRMED ON-SITE PRIOR TO PRODUCTION AND INSTALLATION.

TYPES OF BINS:

- MIXED RECYCLING
- GENERAL WASTE
- FOOD WASTE
- CONFIDENTIAL WASTE
- LIQUID WASTE
- TRAY RETURN TROLLEY
- INTEGRATED, PULL-OUT DOMESTIC STYLE BIN WITH 3 COMPARTMENTS: GENERAL, FOOD & RECYCLING.

JOINERY SCHEDULE

CODE	DESCRIPTION	QTY
LEVEL 02, CP FL		
JR-CA-01	Plantry Type C (L2 & L3 & L4 & L5)	1
LEVEL 01		
JR-AV-01	Meeting Rm - Air Screen Class A Stand	1
JR-AV-02	Reception - Air Screen Class A Stand	1
JR-BK-01	Vanity Unit	1
JR-CA-02	Plantry - Type A - Reception Coffee Point	1
JR-CA-03	Plantry - Type B - Catering Staff Point	1
JR-CA-04	First Aid Room's Reception	1
JR-PL-01	Plaster - Type 1	1
JR-PL-10	New External Plaster	1
JR-PL-11	Plaster - Type 2	1
JR-RE-05	Receiving Station - Type E - Waste & Tray Return Station	1
JR-RE-06	Reception Bench	1
JR-SI-01	Admin Storage, Lockable Doors, Adjustable Shelves	4
JR-SI-02	General Office Storage, Flat Heavy Unit	2
JR-SI-03	Meeting Room's Catering Joints	1
LEVEL 01, CP FL		
JR-AD-01	Plantry - Type A	1
JR-AD-02	Admin Help Desk	2
JR-AD-03	Admin Help Desk	1
JR-AD-04	Admin Help Desk	2
JR-AD-05	(T) Helpdesk Counter	1
JR-PR-01	Counterpane Room Booth Table (Connected Fairs)	2
JR-PR-02	Counterpane Room Booth Table & Recycling Bins and Confidential Wastes - Type A	4
JR-PR-04	Reception Station - Type D	1
LEVEL 02, CP FL		
JR-CA-04	Plantry Type D - Inland Unit (L2 & L3 & L4 & L5)	1
JR-CA-05	Plantry Station Booth Table (Connected Fairs)	1
JR-PL-03	Plaster - Type 1	1
JR-RE-03	Receiving Station With Storage & Recycling Bins and Confidential Wastes - Type B	1
JR-RE-04	Receiving Station With Storage & Recycling Bins and Confidential Wastes - Type C	1
JR-RE-05	Receiving Station With Storage & Recycling Bins and Confidential Wastes - Type D	1
JR-RE-06	Receiving Station With Storage & Recycling Bins and Confidential Wastes - Type E	1
JR-RE-07	Vanity Unit	2

KEY METRICS
WORKSTATIONS 174
ALTERNATIVE SEATS 20
COLLABORATION SEATS 18
TEA POINT SEATS 12
1P PHONE BOOTH 13
2P PHONE BOOTH 3
DISCUSSION RM 4
SML MTG RM 1
MED MTG RM 0
LARGE MTG RM 0
TRAINING RM 0
LOCKERS 162
ARTIST STUDIO 50 (5 spare)

"3"
OFFICES
6 STOREY OFFICE
BUILDING

SIR JOHN ROGERSONS QUAY

33 - 34
[DILLON EUSTACE BUILDING]
6 STOREY OFFICE
BUILDING

WHITAKER
SQUARE

CLAYTON
HOTEL


C05 REVISION NOTES:
1. GENERAL SET OUT ADDED / FURNITURE
TAGS REVISED

FURNITURE PLAN LEGEND

SYMBOL DESCRIPTION
ROOM NAME ROOM / AREA NAME
ROOM NUMBER
(ZONE) = LEVEL NUMBER

DENOTES AREA OUT OF SCOPE. PLEASE NOTE
INCLUSIONS WITHIN THIS AREA ARE TO BE INCLUDED IN THE
MAIN GC SCOPE OF WORKS INCLUDING BUT NOT LIMITED TO:
• DEMOLITION AND MAKING GOOD OF ANY FINISHES
• NEW SIGNAGE
• REPAIRS FURTHER TO COMPLETION OF THE WORKS
• MAKING GOOD OF ALL FINISHES FURTHER TO
COMPLETION OF THE WORKS

J01 J02 J03 J2546 J

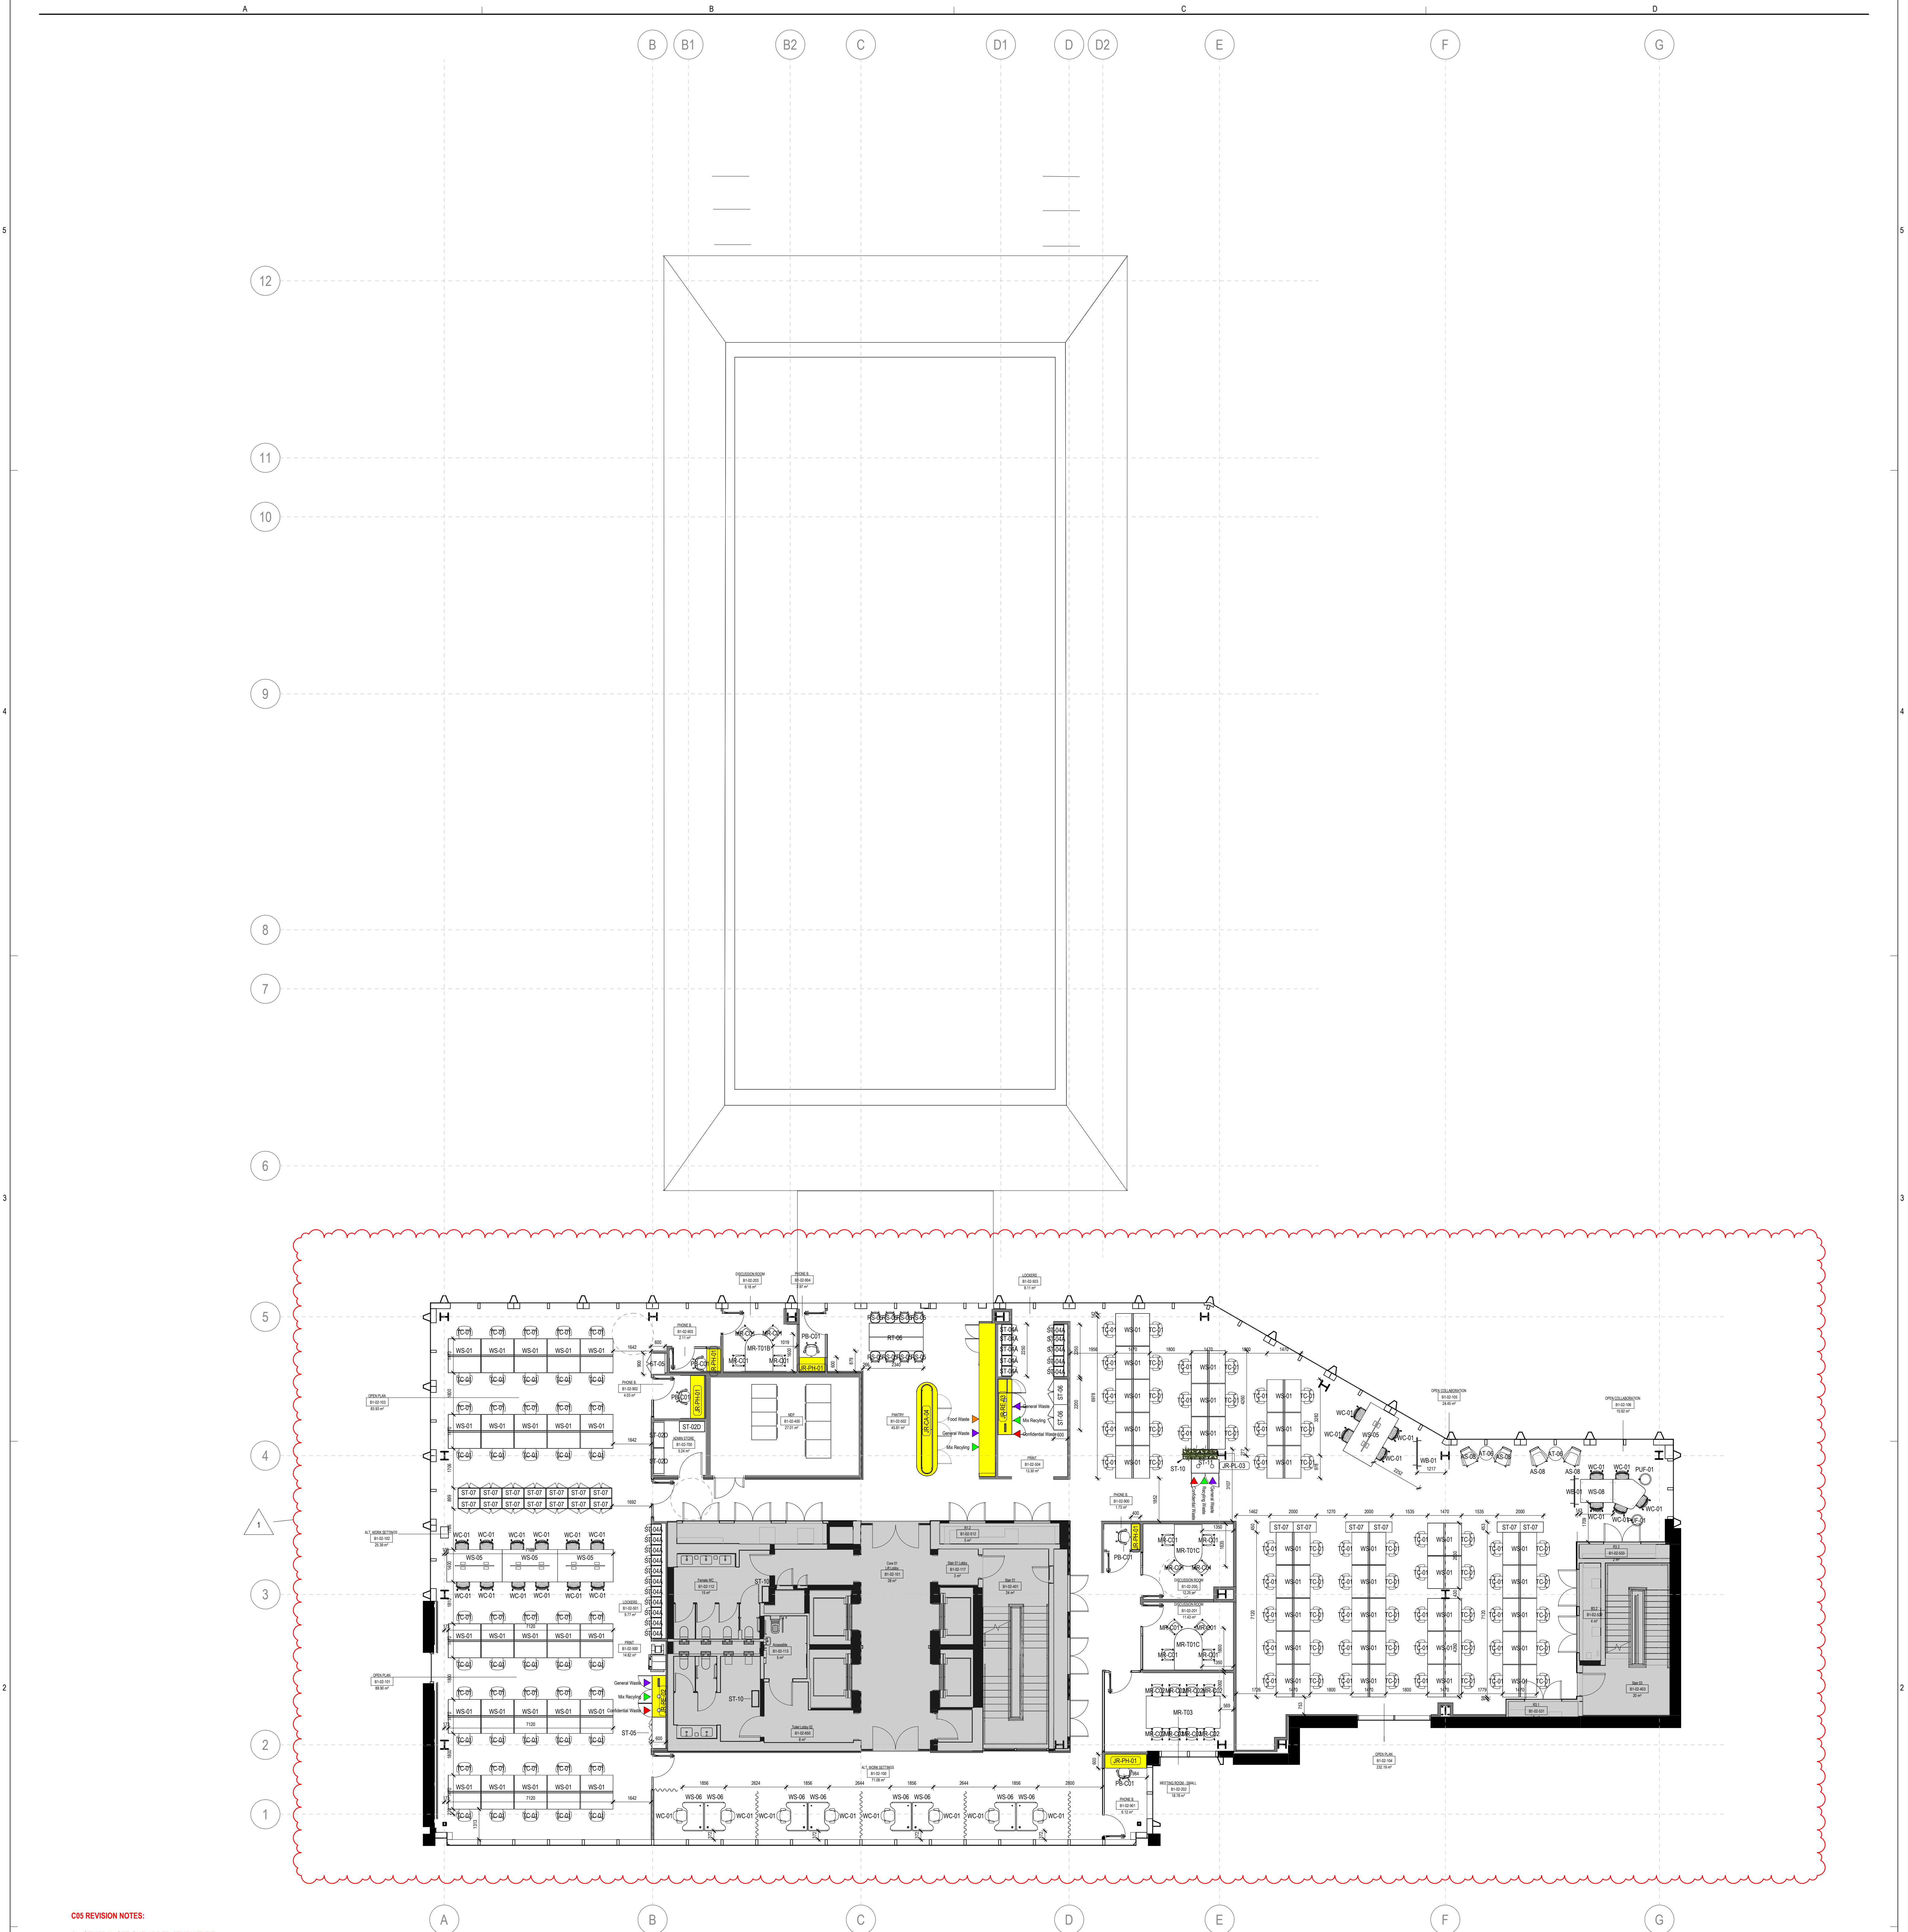

C05 REVISION NOTES:

- 1. GENERAL SET OUT ADDED / FURNITURE TAGS REVISED

FURNITURE PLAN
LEGEND

SYMBOL	DESCRIPTION
ROOM NAME	ROOM / AREA NAME
22.00	ROOM NUMBER
(ZONE) + LEVEL NUMBER	

DENOTES AREA OUT OF SCOPE. PLEASE NOTE INCLUSIONS WITHIN THIS AREA TO BE INCLUDED IN THE MAIN GC SCOPE OF WORKS INCLUDING BUT NOT LIMITED TO:

- DEMOLITION AND MAKING GOOD OF ANY FINISHES FOR NEW ITAVISIGNAGE INSTALLATION
- NEW SIGNAGE
- REPAINT FURTHER TO COMPLETION OF THE WORKS
- MAKING GOOD OF ALL FINISHES FURTHER TO COMPLETION OF THE WORKS

JONERY ELEMENTS

NOTES:

- FURNITURE SHOWN FOR REFERENCE AND COORDINATION PURPOSES ONLY.
- FURNITURE TAGS TO MAINTAIN REQUIRED CLEARANCES AT ALL CROSS-PATHS. FIELD VERIFICATION REQUIRED FOR FINAL LAYOUTS PRIOR TO INSTALLATION.
- DRAWING TO BE READ IN CONJUNCTION WITH GENERAL ARRANGEMENT PLANS AND FURNITURE SCHEDULE A AND SPECIFICATION.
- FURNITURE SUPPLIERS TO PROVIDE AND COORDINATE ALL CABLE CONNECTION WITHIN MEETING ROOM TABLES WITH AV/ELECTRICAL ENGINEER.
- MAIN GC TO DAMAGE AND COORDINATE INTERFACES BETWEEN FURNITURE, DATA AND ELECTRICAL SUPPLIES AND CONNECTIONS.
- FOR RESPONSE / BUILT IN JOINERY DETAILS REFER TO GENERAL ARRANGEMENT PLANS AND JOINERY SCHEDULE. MAIN GC TO MANAGE AND COORDINATE INTERFACES BETWEEN LOGGE FURNITURE AND JOINERY FINISHES (COLORS, FINISHES AND COLOURS MATCH). FURNITURE AND JOINERY CONTRACTOR TO COORDINATE ALL FINISHES WHERE FINISHES SET BY SIZE OR IN CLOSE PROXIMITY.
- MAXIMUM STAR CAPACITY FROM 1ST FLOOR TO 5TH FLOOR IS 1046. THIS CANNOT BE INCREASED, HAVING A NUMBER ABOVE WHAT IS SHOWN AS OCCUPANCY IN FSC IS ACCEPTABLE SO LONG AS THE OVERALL NUMBER DOES NOT EXCEED THAT MEETING ROOMS DO NOT NEED TO BE INCLUDED IN TOTAL NUMBERS AS IT IS EXPECTED THAT THE MEETING ROOMS WILL BE USED BY THE REGULAR BUILDING OCCUPANTS.

JOINERY:

- HARDWARE FINISHES TO BE SPECIFIED. FOR MORE INFORMATION, REFER TO FURNITURE SCHEDULE AND SPECIFICATION.
- SOFT CLOSING HINGES TO ALL DOORS.
- FULLY EXTENDABLE CONCEALED DRAWERS WITH INTEGRATED SOFT-CLOSING MECHANISM TO ALL DRAWERS.
- CUTLERY TRAY TO BE FITTED IN THE TOP DRAWER.
- SPRINK, WASTE TRAYS AND TRAYS TO BE PART M COMPLIANT.
- COLOR MATCHING INCLUDING TO ALL CARCASSES.
- ALLOW FOR VENTILATION & GRILLES FOR ALL UNITS WITH INTEGRATED EQUIPMENT.
- REMOVABLE PANEL, TO ALLOW THE ACCESS TO THE SERVICES IN ALL KNEE RECESS TO BE PROVIDED.
- BUILT IN BENCHES AND UNPOLISHED FINISHES: HIGH-QUALITY (HPL) SURFACES TO BE PROVIDED.
- INTEGRATED STRIP LED LIGHTING TO BE INTEGRATED INTO THE BASE OF ALL AC HANGING STORAGE UNITS.
- EQUIPMENT REQUIRED: REFER TO FURNITURE SCHEDULE AND SPECIFICATION. FOR CATERING EQUIPMENT, REFER TO CATERING CONSULTANT DRAWINGS & SPECIFICATION.
- CONCRETE SLAB.
- QUANTITY LOCATION: REFER TO M&E AV & IT DRAWINGS AND SPECIFICATIONS.
- SOCKETS TO BE 150MM FROM THE EDGE OF THE SKIN, AS PER M&E SPECIFICATION, SOCKET AND SPURS TO BE PART M COMPLIANT.
- SPURS REQUIRED FOR ALL SOCKETS NOT READILY ACCESSIBLE, AS PER M&E SPECIFICATION.
- OTHER:
- SITE SURVEY/CLOSE COORDINATION BETWEEN JOINERY AND PARTITIONS REQUIRED.
- ALL DIMENSIONS TO BE CONFIRMED ON-SITE PRIOR TO PRODUCTION AND INSTALLATION.

TYPES OF BINS:

- MIXED RECYCLING
- GENERAL WASTE
- FOOD WASTE
- CONFIDENTIAL WASTE
- LIQUID WASTE
- TRAY RETURN TROLLEY
- INTEGRATED, PULL OUT DOMESTIC STYLE BIN WITH 3 COMPARTMENTS: GENERAL FOOD & RECYCLING.

JOINERY SCHEDULE

CODE	DESCRIPTION	QTY
BR-LEVEL 05 FFL		
JR-CA-03	Plantry Type C (L02 & L03 & L04 & L05)	1
JR-CA-03	Plantry Type D - Island Unit (L02 & L03 & L04 & L05)	1
JR-CA-03	Plantry Type E - Island Unit (L02 & L03 & L04 & L05)	1
JR-BA-01	Meeting Room - AV Screen Case & Stand	1
JR-BA-01	Meeting Room - AV Screen Frame	1
JR-BA-01	Vanity Unit	1
JR-BA-01	Plantry - Type B - Reception Counter Front	1
JR-CA-06	Plantry - Type E - Catering Staff Counter	1
JR-CA-06	First Aid Room - Reception	1
JR-PL-01	Plantry - Type A	1
JR-PL-10	New External Planter	1
JR-RE-01	Reception Desk	1
JR-RE-05	Recycling Station - Type E - Waste & Tray Return Station	1
JR-SE-01	Barquette Bench	1
JR-ST-01	Admin Storage, Lockable Doors, Adjustable Shelves	4
JR-ST-03	General Office Storage - Full Height Unit	2
JR-ST-03	Meeting Rooms Catering Joinery Unit	2
LEVEL 05 FF		
JR-CA-01	Plantry - Type A	1
JR-CA-01	Admin Help Desk	1
JR-CA-03	Admin Help Desk	1
JR-CA-03	IT Customer Help Desk	2
JR-CA-04	IT Helpdesk Counter	1
JR-PL-01	Centrifuge Phone Booth Table (Concealed Flats)	7
JR-RE-01	Print Station With Storage & Recycling Bins and Confidential Waste - Type A	1
JR-RE-04	Recycling Station - Type D	1
LEVEL 05 FF		
JR-CA-04	Plantry Type D - Island Unit (L02 & L03 & L04 & L05)	1
JR-PL-01	Centrifuge Phone Booth Table (Concealed Flats)	5
JR-PL-03	Plantry - Type C	4
JR-RE-01	Print Station With Storage & Recycling Bins and Confidential Waste - Type B	1
JR-RE-03	Print Station With Storage & Recycling Bins and Confidential Waste - Type C	1
LEVEL 05 FFL		
JR-BA-01	Vanity Unit	2

JOINERY SCHEDULE

CODE	DESCRIPTION	QTY
JR-CA-03	Plantry Type C (L02 & L03 & L04 & L05)	1
JR-CA-04	Plantry Type D - Island Unit (L02 & L03 & L04 & L05)	1
JR-CA-11	Room Divider - Acoustic Acoustic Screen Type B	2
JR-PL-01	Centrifuge Phone Booth Table (Concealed Flats)	9
JR-PL-05	Plantry - Type E	3
JR-SE-03	Built-in Booth - Type D	3
JR-SE-04	Barquette Bench - Type C	1
LEVEL 04 FFL		
JR-BA-01	Vanity Unit	2
JR-CA-03	Plantry Type C (L02 & L03 & L04 & L05)	1
JR-CA-04	Plantry Type D - Island Unit (L02 & L03 & L04 & L05)	1
JR-PL-01	Centrifuge Phone Booth Table (Concealed Flats)	2
JR-SE-05	Plantry - Type E	6
JR-SE-03	Built-in Booth - Type D	3
JR-SE-04	Barquette Bench - Type C	1
LEVEL 05 FFL		
JR-AB-01	Stone Water Fountain for Ablution Room - Seating	3
JR-AB-02	Stone Water Fountain for Ablution Room - Seating	2
JR-CA-03	Plantry Type C (L02 & L03 & L04 & L05)	1
JR-CA-06	Plantry Type D - Island Unit (L02 & L03 & L04 & L05)	1
JR-CA-07	Mothers Room Joinery	1
JR-CA-08	Training Room Wall Paneling	2
JR-CA-09	Training Room Storage & Counter - Type A	1
JR-CA-10	Training Room Storage & Counter - Type B	1
JR-PL-01	Centrifuge Phone Booth Table (Concealed Flats)	1
JR-SE-02	Plantry - Type E	1
JR-SE-02	Print Station With Storage & Recycling Bins and Confidential Waste - Type B	1
JR-SE-02	Ramp 02	1
LEVEL 06 FFL		
JR-DR-01	Basement Drying Room - Coat Hanging Unit with Shoe Storage	1
JR-DR-02	Basement Drying Room - Tower Bin	1

Perkins&Will

Notes

Drawing for contract purposes only. Do not scale from the drawing.

All information, areas, dimensions and datum levels are subject to detailed survey, detailed design and investigative work.


This drawing is the property of Perkins+Will UK Ltd. No disclosure or copy of it may be made without the written permission of Perkins+Will UK Ltd.

A site survey has not been carried out. Contractor to check all site dimensions on site prior to fabrication and construction.

Architect to be notified to confirm any discrepancies found between architectural and engineer drawings/documents.

Contractor to ensure all products and materials specified are competitively tendered. Fire, acoustic and sustainability standards and aesthetics to be achieved to meet minimum performance requirements outlined in specification documents.

KEYPLAN

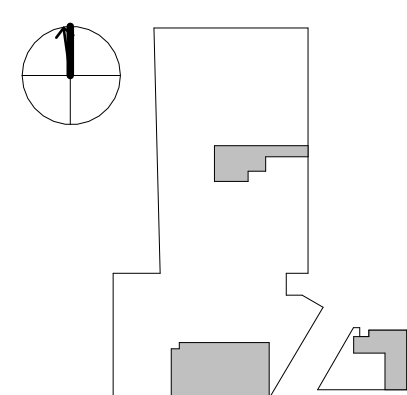

ISSUE CHART

PROJECT

TIKTOK - TFW
TROPICAL FRUIT WAREHOUSE
30-32 SIR JOHN ROGERSON'S QUAY
DUBLIN D02 V9X9, IRELAND



STAGE 5

C05	FOR CONTRACT	17/11/2023
C04	FOR TENDER	03/10/2023
C03	FOR TENDER	02/10/2023
C02	TENDER ADDENDUM	27/09/2023
C01	FOR TENDER	03/09/2023

Date	17/11/2023
Job Number	322681
Scale	A0 @ 1 : 100
Drawn	OK
Checked	RZ
Approved	ES

CDE STATUS	FOR CONTRACT
------------	--------------

TITLE

FURNITURE PLAN - LEVEL 02

SHEET NUMBER

TFW-PWA-ZZ-02-DR-I-1502

PROJECT - ORIGINATOR - VOLUME - LEVEL - FORM - DISCIPLINE - NUMBER

CDE STATUS CODE	REVISION
A5	C05

C05 REVISION NOTES:

- GENERAL SET OUT ADDED / FURNITURE TAGS REVISED

FURNITURE PLAN LEGEND

SYMBOL **DESCRIPTION**

ROOM NAME — ROOM / AREA NAME

ROOM NUMBER — ROOM NUMBER

(ZONE) = LEVEL NUMBER

DENOTES AREA OUT OF SCOPE. PLEASE NOTE INCLUSIONS WITHIN THIS AREA TO BE INCLUDED IN THE MAIN GC SCOPE OF WORKS INCLUDING BUT NOT LIMITED TO:

- DEMOLITION AND MAKING GOOD OF ANY FINISHES FOR NEW ITA/SIGNAGE INSTALLATION
- NEW SIGNAGE
- REPAINT FURTHER TO COMPLETION OF THE WORKS
- MAKING GOOD OF ALL FINISHES FURTHER TO COMPLETION OF THE WORKS

JONERY ELEMENTS

NOTES:

1. FURNITURE SHOWN FOR REFERENCE AND COORDINATION PURPOSES ONLY.

2. FURNITURE TAGS TO MAINTAIN REQUIRED CLEARANCES AT ALL JOINTS/PATHS. FIELD VERIFICATION REQUIRED FOR FINAL LAYOUTS PRIOR TO INSTALLATION.

3. DRAWING TO BE READ IN CONJUNCTION WITH GENERAL ARRANGEMENT PLANS AND FURNITURE SCHEDULE AND SPECIFICATION.

4. FURNITURE SUPPLIERS TO PROVIDE AND COORDINATE ALL CABLE CONNECTION WITHIN MEETING ROOM TABLES WITH AV/ELECTRICAL ENGINEER.

5. MAIN GC TO MANAGE AND COORDINATE INTERFACES BETWEEN FURNITURE, DATA AND ELECTRICAL SUPPLIES AND CONNECTIONS.

6. FOR BEST PRACTICE, BUILT IN JOINERY DETAILS REFER TO GENERAL ARRANGEMENT PLANS AND JOINERY SCHEDULE. MAIN GC TO MANAGE AND COORDINATE INTERFACES BETWEEN LOCAL FURNITURE AND JOINERY FINISHES ENSURING FINISHES AND COLOURS MATCH. FURNITURE AND JOINERY CONTRACTOR TO COORDINATE ALL FINISHES WHERE FINISHES SET BY SET BY SET OR IN CLOSE PROXIMITY.

7. MAXIMUM STAIR CAPACITY FROM 1ST FLOOR TO 1ST FLOOR IS 1048. THIS CANNOT BE INCREASED, HAVING A NUMBER ABOVE WHAT IS SHOWN AS OCCUPANCY IN FSC IS ACCEPTABLE SO LONG AS THE OVERALL NUMBER DOES NOT EXCEED THAT MEETING ROOMS DO NOT NEED TO BE INCLUDED IN TOTAL NUMBERS AS IT IS EXPECTED THAT THE MEETING ROOMS WILL BE USED BY THE REGULAR BUILDING OCCUPANTS.

8. COLOUR MATCHING: COLOUR MATCHING TO BE SPECIFIED. FOR MORE INFORMATION, REFER TO FURNITURE SCHEDULE AND SPECIFICATION.

9. ALLOW FOR VENTILATION & GRILLES FOR ALL UNITS WITH INTEGRATED EQUIPMENT.

10. REMOVABLE PANEL TO ALLOW THE ACCESS TO THE SERVICES IN ALL KNEE RECESS TO BE PROVIDED.

11. BUILT IN BENCHES AND UNPOLISHED FINISHES: HIGH QUALITY UNPOLISHED FINISHES TO BE PROVIDED.

12. INTEGRATED STRIP LED LIGHTING TO BE INTEGRATED INTO THE BASE OF ALL HANGING STORAGE UNITS.

13. EQUIPMENT REQUIRED: REFER TO FURNITURE SCHEDULE AND SPECIFICATION FOR CATERING EQUIPMENT. REFER TO CATERING CONSULTANT DRAWINGS & SPECIFICATION.

14. QUANTITY LOCATION: REFER TO M&E AV & IT DRAWINGS AND SPECIFICATIONS.

15. SOCKETS TO BE 150MM FROM THE EDGE OF THE BENCH AS PER M&E SPECIFICATION. SOCKET AND SPURS TO BE PART M COMPONENT.

16. SPURS REQUIRED FOR ALL SOCKETS NOT READY ACCESSIBLE, AS PER M&E SPECIFICATION.

17. OTHER:

18. SITE SURVEY/COORDINATION BETWEEN JOINERY AND PARTITIONS REQUIRED.

19. ALL DIMENSIONS TO BE CONFIRMED ON SITE PRIOR TO PRODUCTION AND INSTALLATION.

TYPES OF BINS:

MIXED RECYCLING

GENERAL WASTE

FOOD WASTE

CONFIDENTIAL WASTE

LIQUID WASTE

TRAY RETURN TROLLEY

INTEGRATED, PULL OUT DOMESTIC STYLE BIN WITH 3 COMPARTMENTS: GENERAL FOOD & RECYCLING.

Perkins&Will

Notes

Drawing for contract purposes only. Do not scale from the drawing.

All information, areas, dimensions and datum levels are subject to detailed survey, detailed design and investigation work.

This drawing is the property of Perkins+Will UK Ltd. No disclosure or copy of it may be made without the written permission of Perkins+Will UK Ltd.

A site survey has not been carried out. Contractor to check all site dimensions on site prior to fabrication and construction.

Architect to be notified to confirm any discrepancies found between architectural and engineer drawings/documents.

Contractor to ensure all products and materials specified are competitively tendered. Fire, acoustic and sustainability standards and aesthetics to be achieved to meet minimum performance requirements outlined in specification documents.



ISSUE CHART

14 Fitzwilliam Square E
Dublin 2
D02 W206, Ireland
www.perkinswill.com

PROJECT

TIKTOK - TFW
TROPICAL FRUIT WAREHOUSE
30-32 ST JOHN ROGERSON'S QUAY
DUBLIN D02 X990, IRELAND



STAGE 5

FOR CONTRACT

C05 FOR CONTRACT 17/11/2023
C04 FOR TENDER 03/10/2023
C03 FOR TENDER 02/10/2023
C02 TENDER ADDENDUM 15/09/2023
C01 FOR TENDER 03/09/2023

Date 17/11/2023
Job Number 322881
Scale A0 @ 1:100
Drawn OK
Checked RZ
Approved ES

CDE STATUS FOR CONTRACT

TITLE


FURNITURE PLAN - LEVEL 04

SHEET NUMBER
TFW-PWA-ZZ-04-DR-1-1504

PROJECT: OPERATOR: VOLUME: LEVEL: FORM: DISCIPLINE: NUMBER

CDE STATUS CODE A5 REVISION C05

Copyright © 2022 Perkins+Will

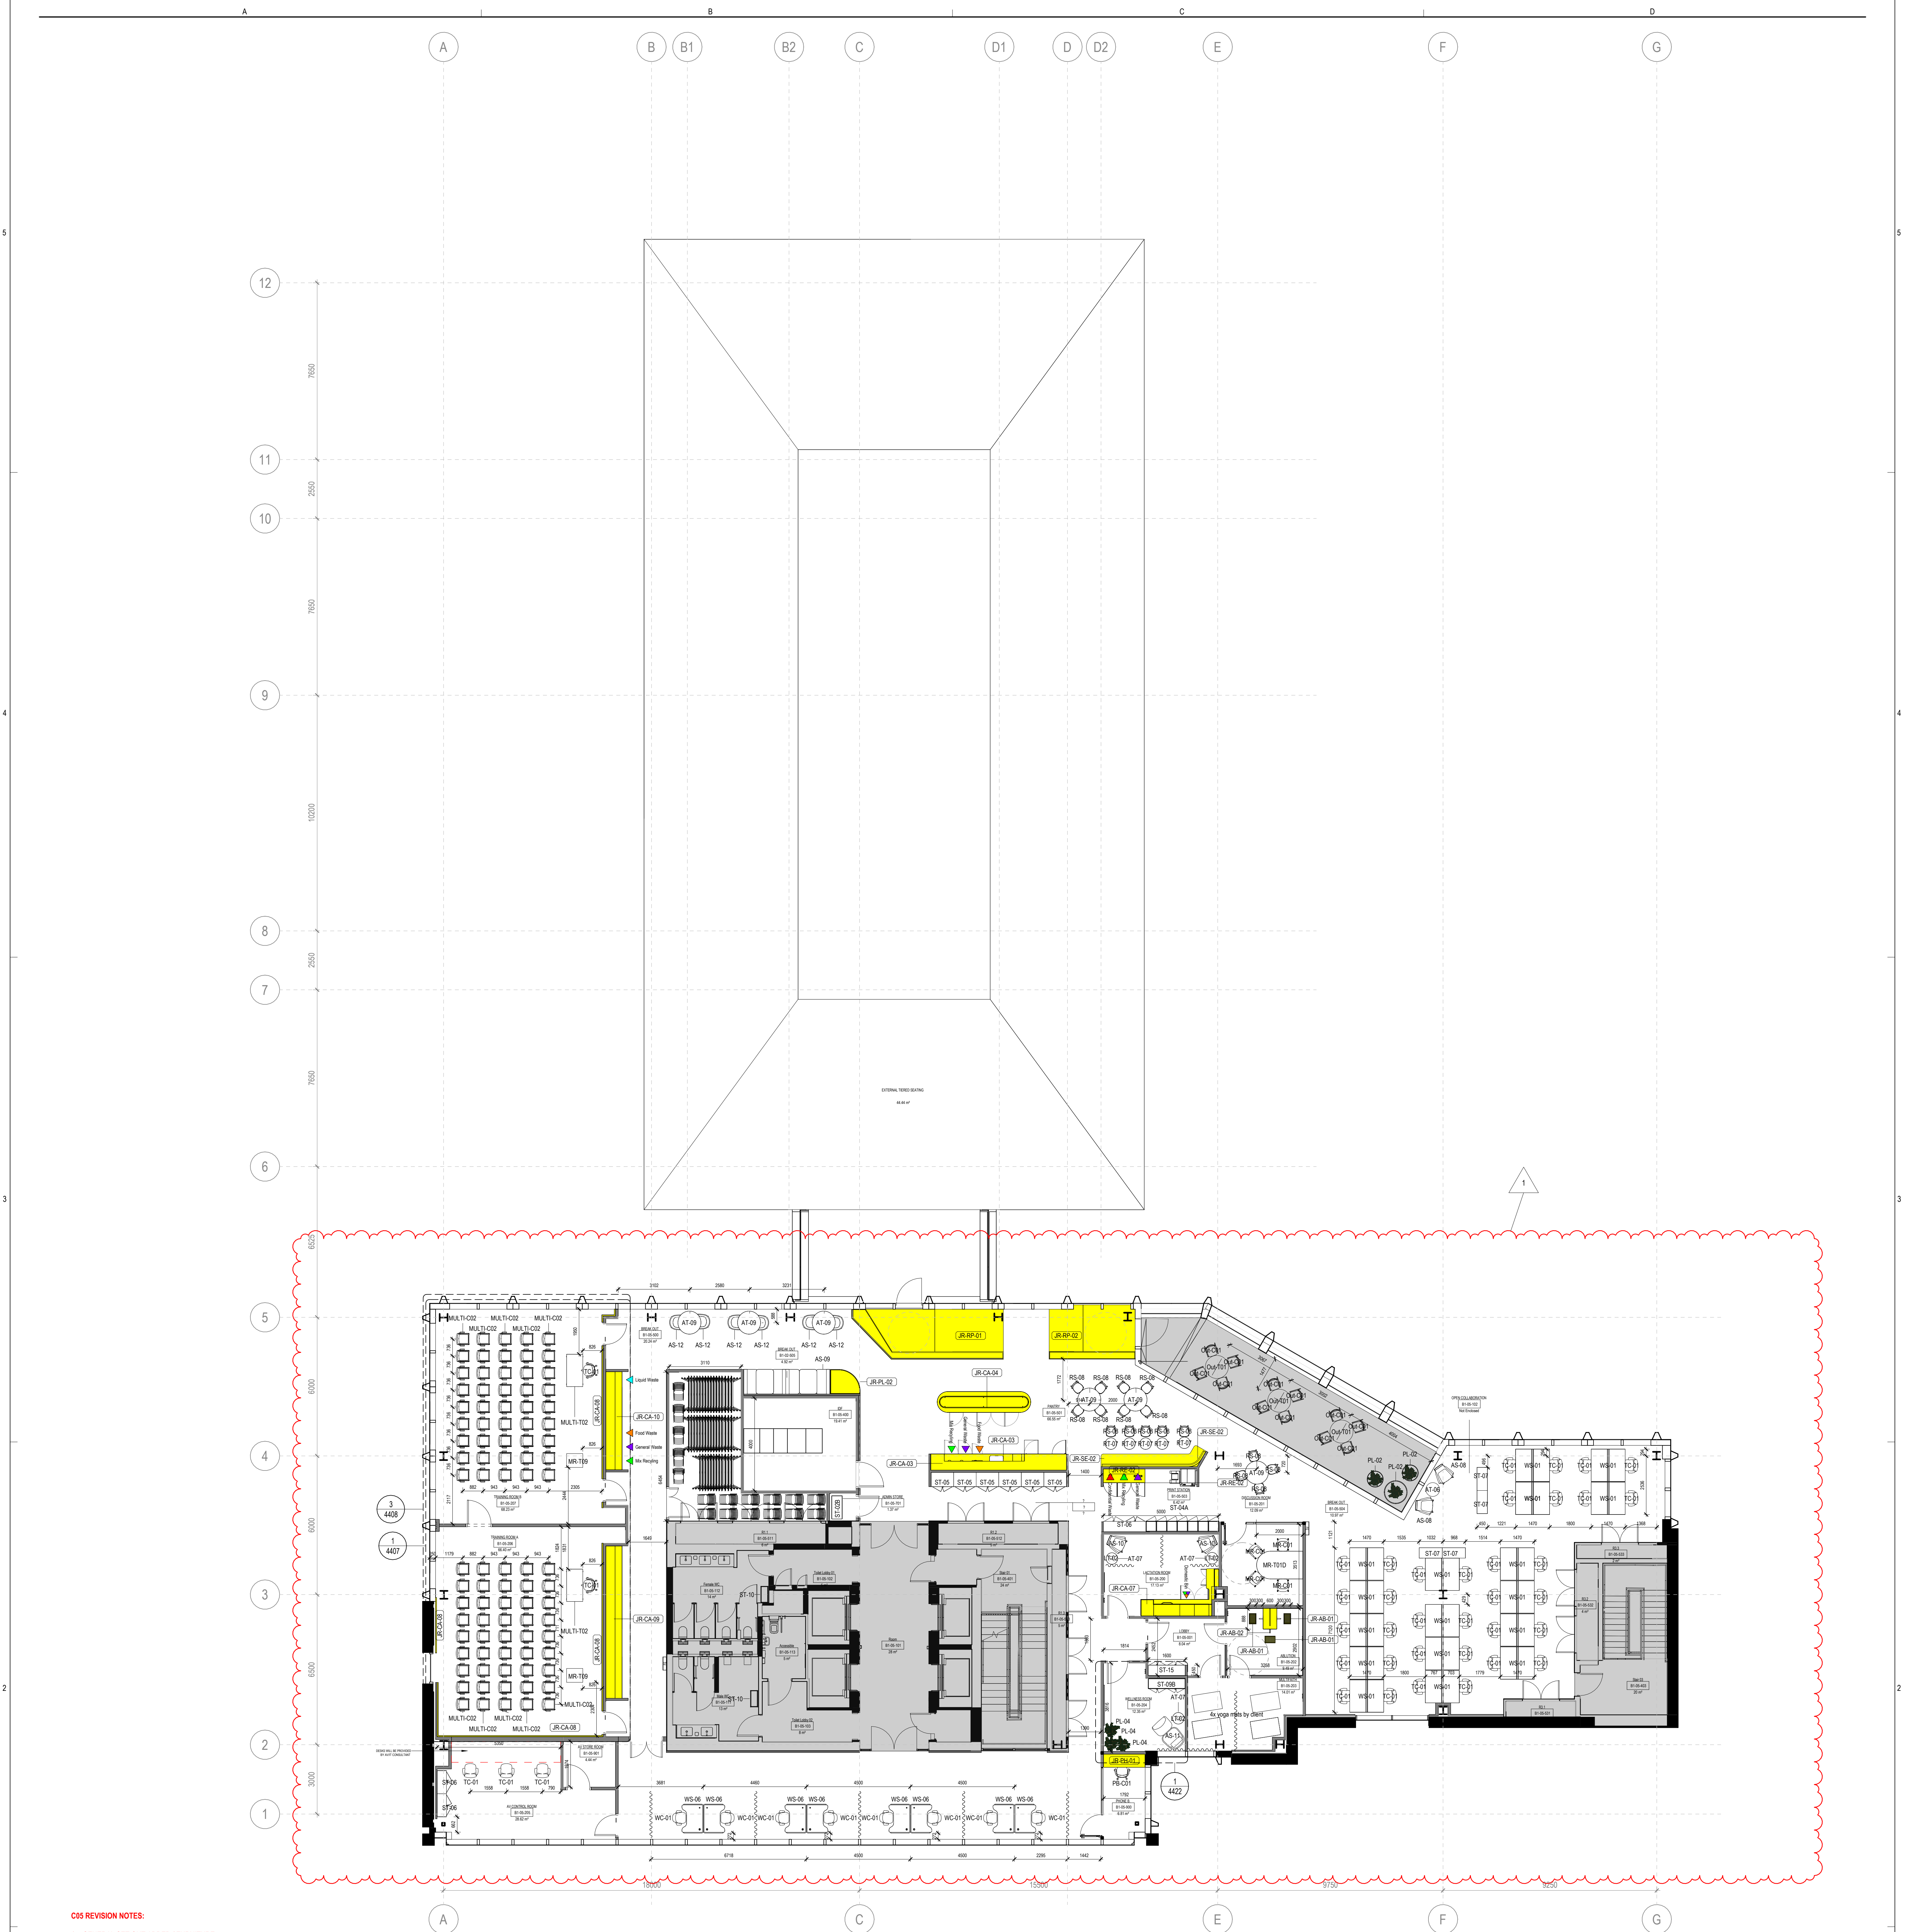

C05 REVISION NOTES:
1. GENERAL SET OUT ADDED / FURNITURE TAGS REVISED

FURNITURE PLAN LEGEND

SYMBOL	DESCRIPTION
ROOM NAME	ROOM / AREA NAME
ROOM NUMBER	ROOM NUMBER
(ZONE) + LEVEL NUMBER	

DENOTES AREA OUT OF SCOPE. PLEASE NOTE INCLUSIONS WITHIN THIS AREA TO BE INCLUDED IN THE MAIN GC SCOPE OF WORKS INCLUDING BUT NOT LIMITED TO:

- DEMOLITION AND MAKING GOOD OF ANY FINISHES FOR NEW ITAVISIGNAGE INSTALLATION
- NEW SIGNAGE
- REPAINT FURTHER TO COMPLETION OF THE WORKS
- MAKING GOOD OF ALL FINISHES FURTHER TO COMPLETION OF THE WORKS

JONERY ELEMENTS

NOTES:

- FURNITURE SHOWN FOR REFERENCE AND COORDINATION PURPOSES ONLY.
- FURNITURE TAGS TO MAINTAIN REQUIRED CLEARANCES AT ALL CORNERS PLUS THIS FIELD VERIFICATION REQUIRED FOR FINAL LAYOUTS PRIOR TO INSTALLATION.
- DRAWING TO BE READ IN CONJUNCTION WITH GENERAL ARRANGEMENT PLANS AND FURNITURE SCHEDULE E AND SPECIFICATION.
- FURNITURE SUPPLIERS TO PROVIDE AND COORDINATE ALL CABLE CONNECTION WITHIN MEETING ROOM TABLES WITH AV/ELECTRICAL ENGINEER.
- MAIN GC TO DAMAGE AND COORDINATE INTERFACES BETWEEN FURNITURE, DATA AND ELECTRICAL SUPPLIES AND CONNECTIONS.
- FOR RESPONSE / BUILT IN JOINERY DETAILS REFER TO GENERAL ARRANGEMENT PLANS AND JOINERY SCHEDULE. MAIN GC TO MANAGE AND COORDINATE INTERFACES BETWEEN FURNITURE AND JOINERY FINISHES (FINISHES TO BE BY SIDE OR IN CLOSE PROXIMITY).
- MAXIMUM STAIR CAPACITY FROM 1ST FLOOR TO 5TH FLOOR IS 1046. THIS CANNOT BE INCREASED, HAVING A NUMBER ABOVE WHAT IS SHOWN AS OCCUPANCY IN FSC IS ACCEPTABLE SO LONG AS THE OVERALL NUMBER DOES NOT EXCEED THE MEETING ROOMS DO NOT NEED TO BE INCLUDED IN TOTAL NUMBERS AS IT IS EXPECTED THAT THE MEETING ROOMS WILL BE USED BY THE REGULAR BUILDING OCCUPANTS.

JOINERY:

- HARDWARE FINISHES TO BE SPECIFIED. FOR MORE INFORMATION, REFER TO FURNITURE SCHEDULE AND SPECIFICATION.
- SOFT CLOSING HINGES TO ALL DOORS.
- FULLY EXTENDABLE CONCEALED PANNERS WITH INTEGRATED SOFT-CLOSING MECHANISM TO ALL DRAWERS.
- CUTLERY TRAY TO BE FITTED IN THE TOP DRAWER.
- COLOR MATCHING BELONGING TO ALL CARCASSES.
- SPRINK, WASTE TRAYS AND TAPS TO BE PART M COMPLIANT.
- ALLOW FOR VENTILATION & GRILLES FOR ALL UNITS WITH INTEGRATED EQUIPMENT.
- REMOVABLE PANEL TO ALLOW THE ACCESS TO THE SERVICES IN ALL KNEE RECESS TO BE PROVIDED.
- BUILT IN BENCHES AND UPHOLSTERED SEATERS - HIGH QUALITY UPHOLSTERY TO BE PROPOSED.
- INTEGRATED STRIP LED LIGHTING TO BE INTEGRATED INTO THE BASE OF ALL AC HANGING STORAGE UNITS.
- EQUIPMENT REQUIRED REFER TO FURNITURE SCHEDULE AND SPECIFICATION. FOR CATERING EQUIPMENT REFER TO CATERING CONSULTANT DRAWINGS & SPECIFICATION.
- CONCRETE SLAB.
- QUANTITY LOCATION: REFER TO ME, AV & IT DRAWINGS AND SPECIFICATIONS.
- SOCKETS TO BE 150MM FROM THE EDGE OF THE SINK. AS PER ME SPECIFICATION, SOCKET AND SPURS TO BE PART M COMPLIANT.
- SPURS REQUIRED FOR ALL SOCKETS NOT READILY ACCESSIBLE, AS PER ME SPECIFICATION.

OTHER:

- SITE SURVEY/CLASH COORDINATION BETWEEN JOINERY AND PARTITIONS REQUIRED.
- ALL DIMENSIONS TO BE CONFIRMED ON SITE PRIOR TO PRODUCTION AND INSTALLATION.

TYPES OF BINS:

- MIXED RECYCLING
- GENERAL WASTE
- FOOD WASTE
- CONFIDENTIAL WASTE
- LIQUID WASTE
- TRAY RETURN TROLLEY
- INTEGRATED, PULL OUT DOMESTIC STYLE BIN WITH 3 COMPARTMENTS: GENERAL, FOOD & RECYCLING.

Perkins&Will

Notes

Drawing for contract purposes only. Do not scale from the drawing.


All information, areas, dimensions and datum levels are subject to detailed survey, detailed design and investigative work.

This drawing is the property of Perkins&Will UK Ltd. No disclosure or copy of it may be made without the written permission of Perkins&Will UK Ltd.

A site survey has not been carried out. Contractor to check all site dimensions on site prior to fabrication and construction.

Architect to be notified to confirm any discrepancies found between architectural and engineer drawings/documents.

Contractor to ensure all products and materials specified are competitively tendered. Fire, acoustic and sustainability standards and aesthetics to be achieved to meet minimum performance requirements outlined in specification documents.

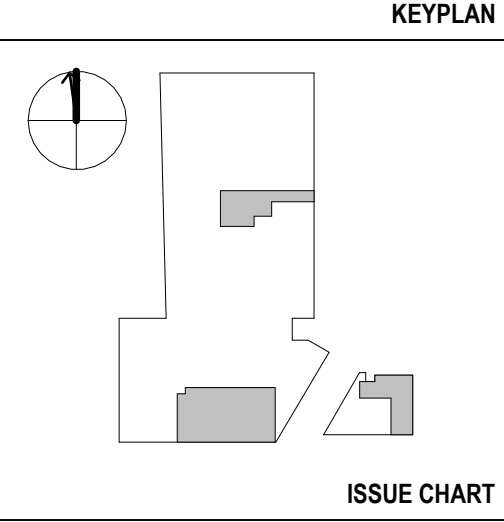

ISSUE CHART

JOINERY SCHEDULE			JOINERY SCHEDULE		
CODE	DESCRIPTION	QTY	CODE	DESCRIPTION	QTY
BR-LEVEL 01 FFL			BR-CA-03	Privacy Type C (J02 & L03 & L04 & L05)	1
