



20-22 BENSON ROAD GROUND FLOOR

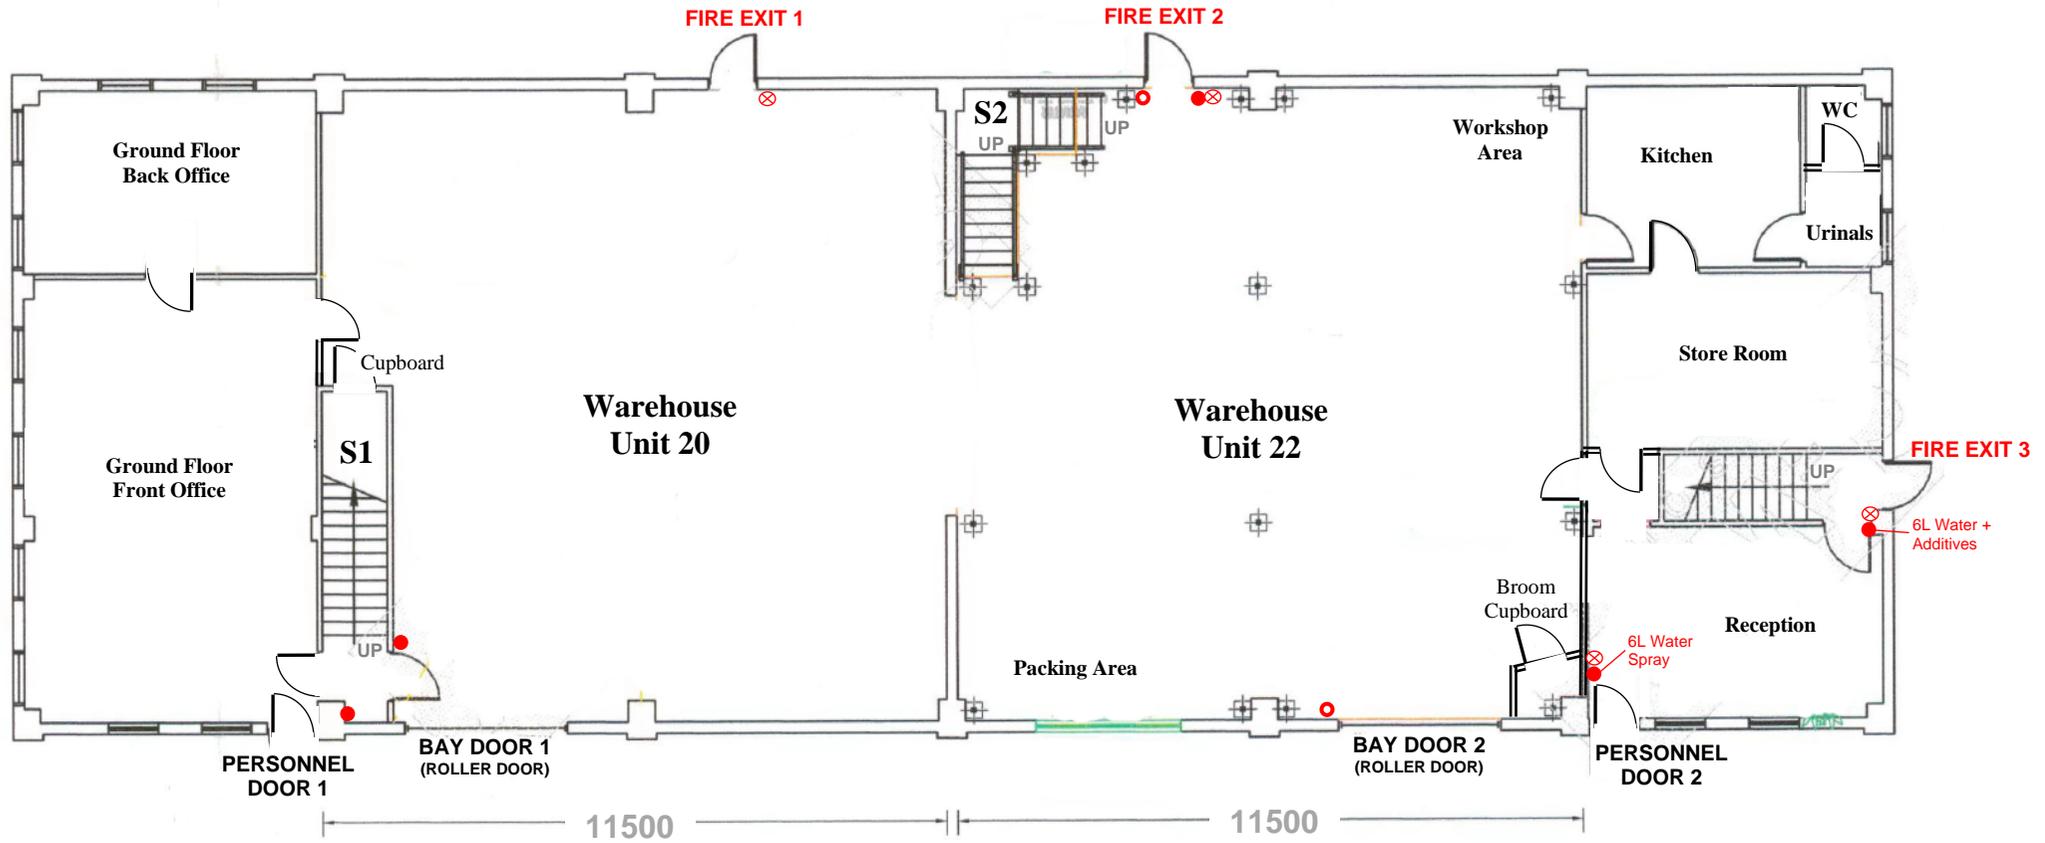

- KEY**
- FIRE EXTINGUISHER: 9L WATER (unless otherwise stated)
 - FIRE EXTINGUISHER: 2Kg CO₂
 - ⊗ ALARM CALL POINT (BREAK GLASS)

FIRST FLOOR

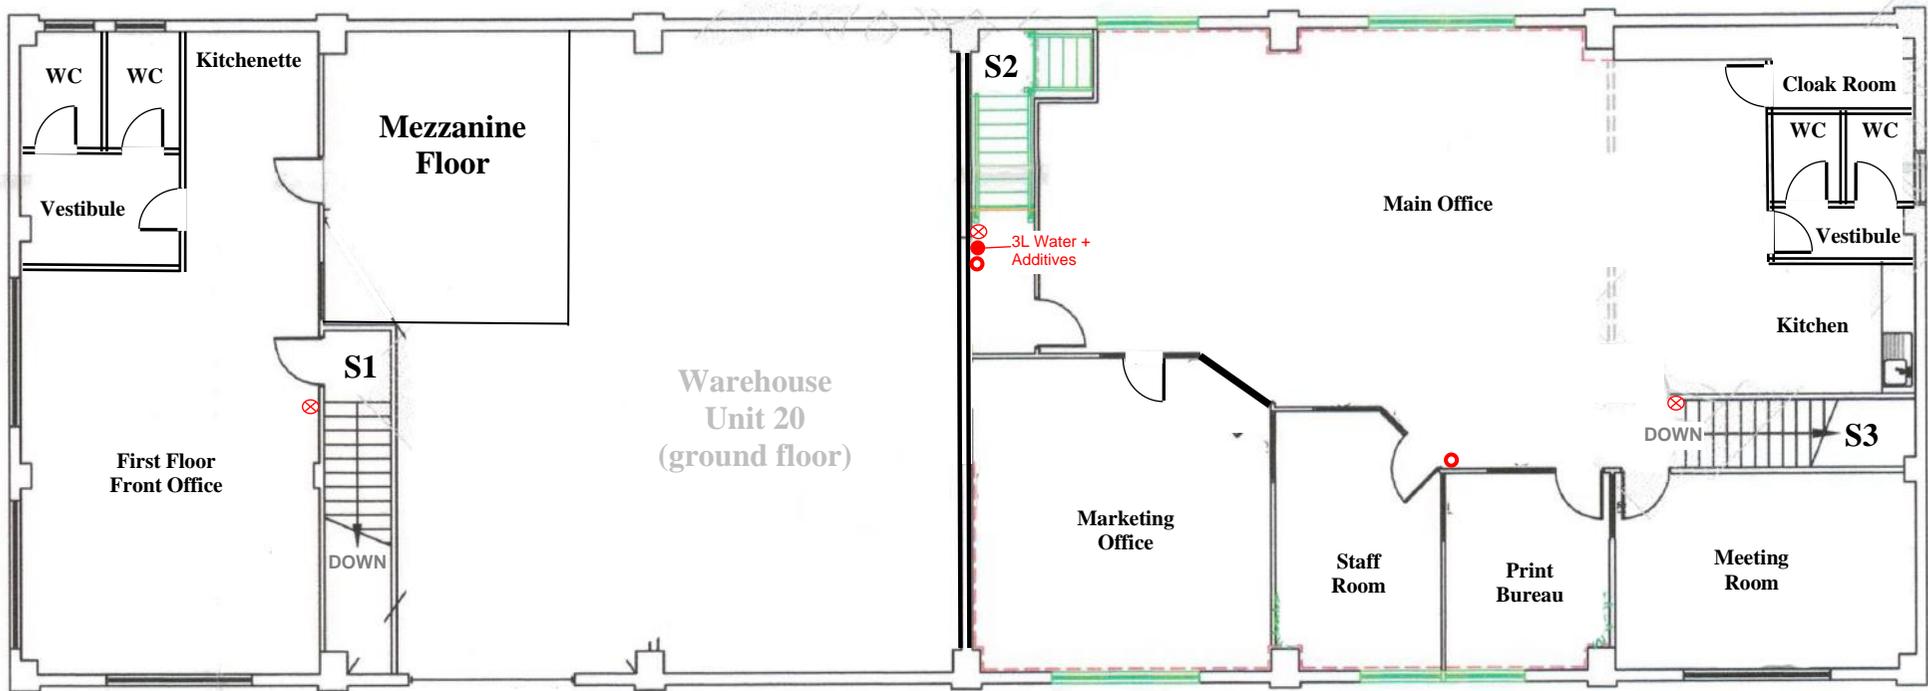

KEY

- FIRE EXTINGUISHER: 9L WATER (unless otherwise stated)
- FIRE EXTINGUISHER: 2Kg CO₂
- ⊗ ALARM CALL POINT (BREAK GLASS)