



**EXISTING**

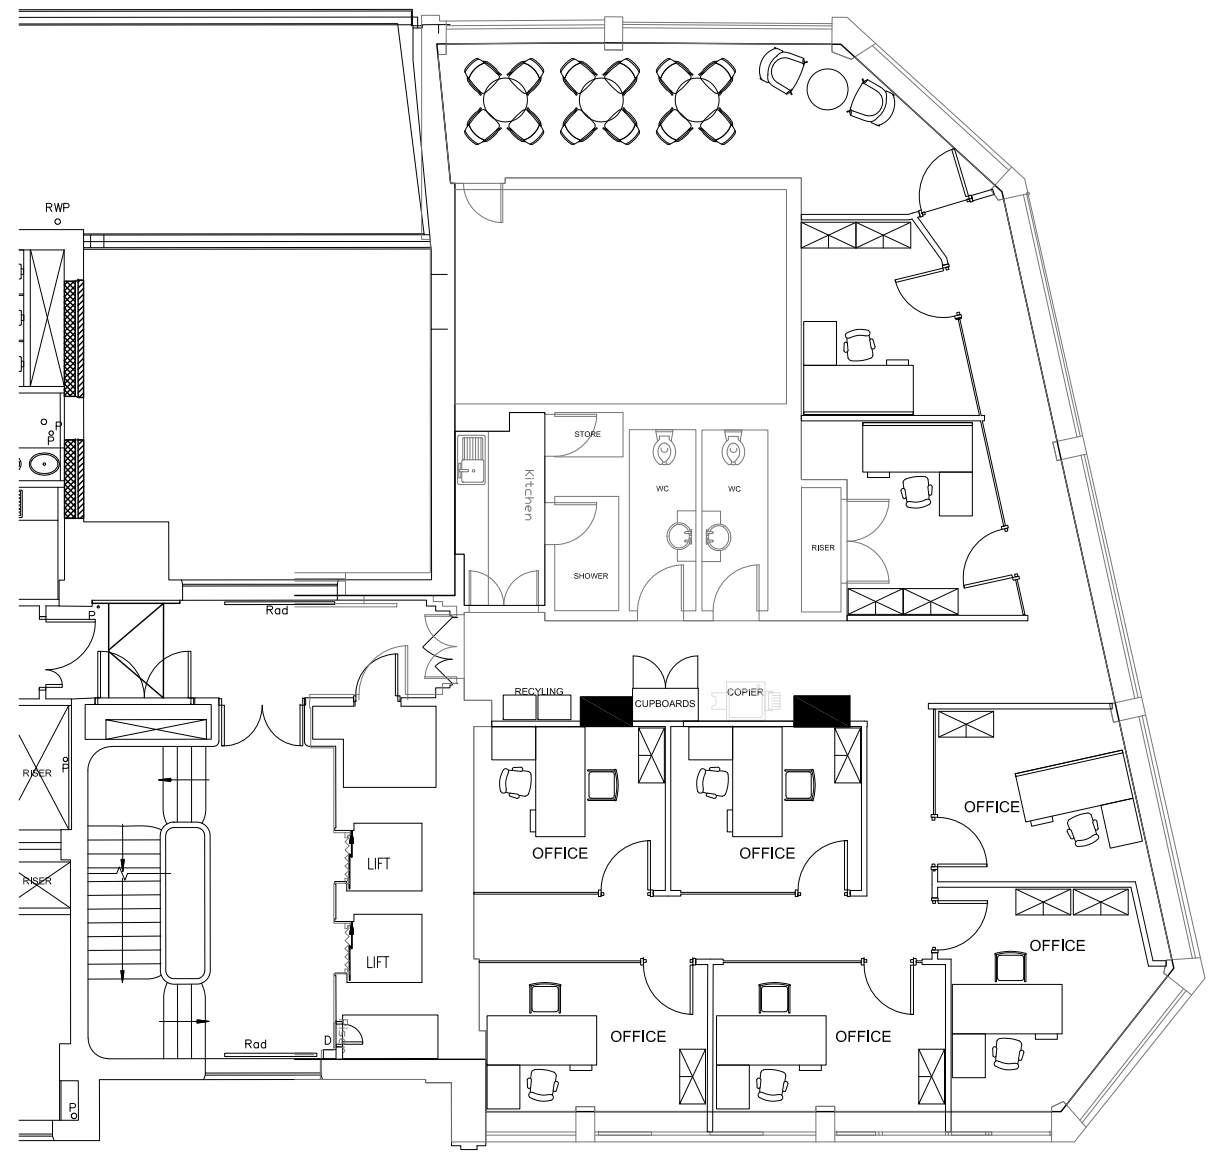


**OPTION E 11 DEC 2019**

**NET AREA 162 sqm 1744 sqft  
 NOT INCL. CORRIDOR**

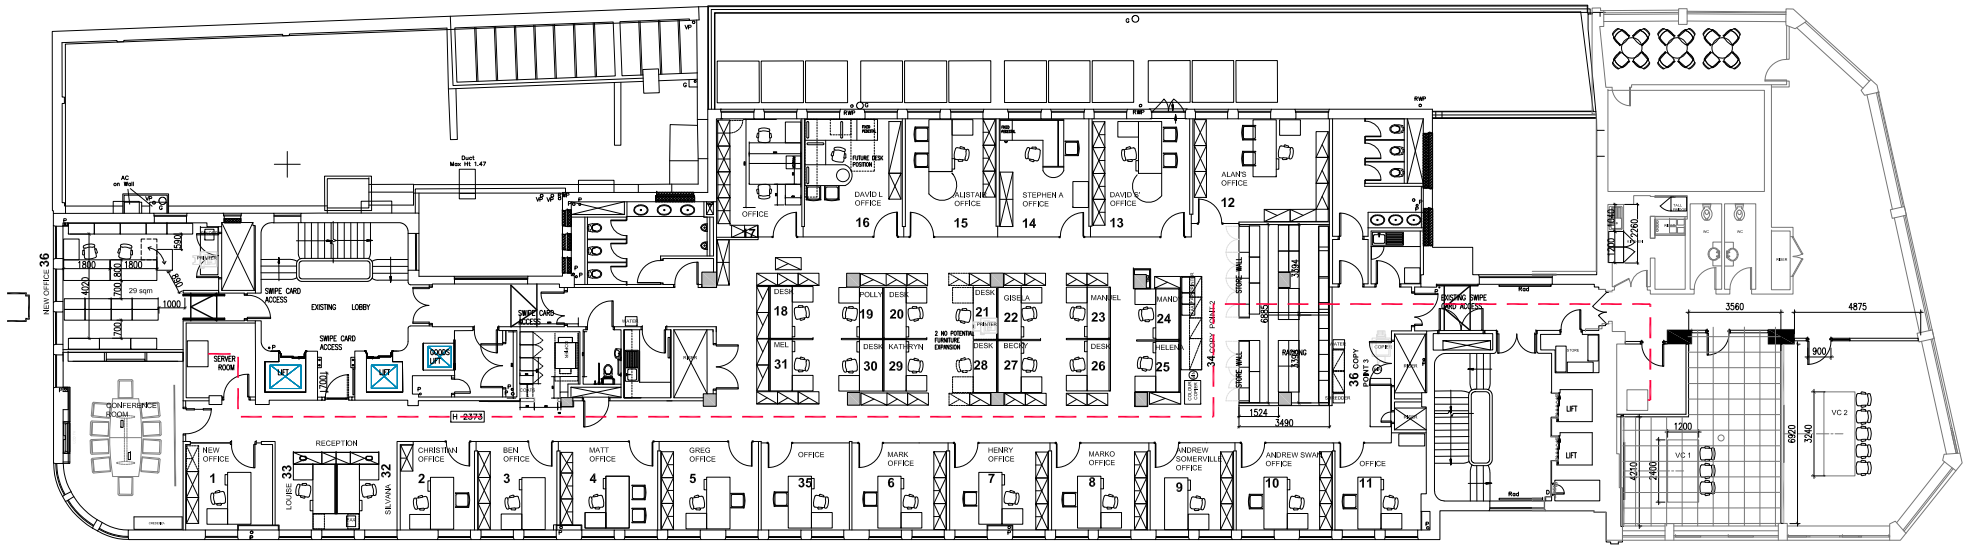

**FIBRE LINK FROM SOUTH TO NORTH LINK  
 66-70m RUN**

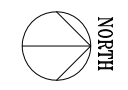

**FOR APPROVAL**

Series:	GENERAL ARRANGEMENT	NTS
Dwg. Title:	TEST FIT HARMSWORTH HOUSE 3RD FL NORTH	
Dwg. No:	05-03	Rev: C