


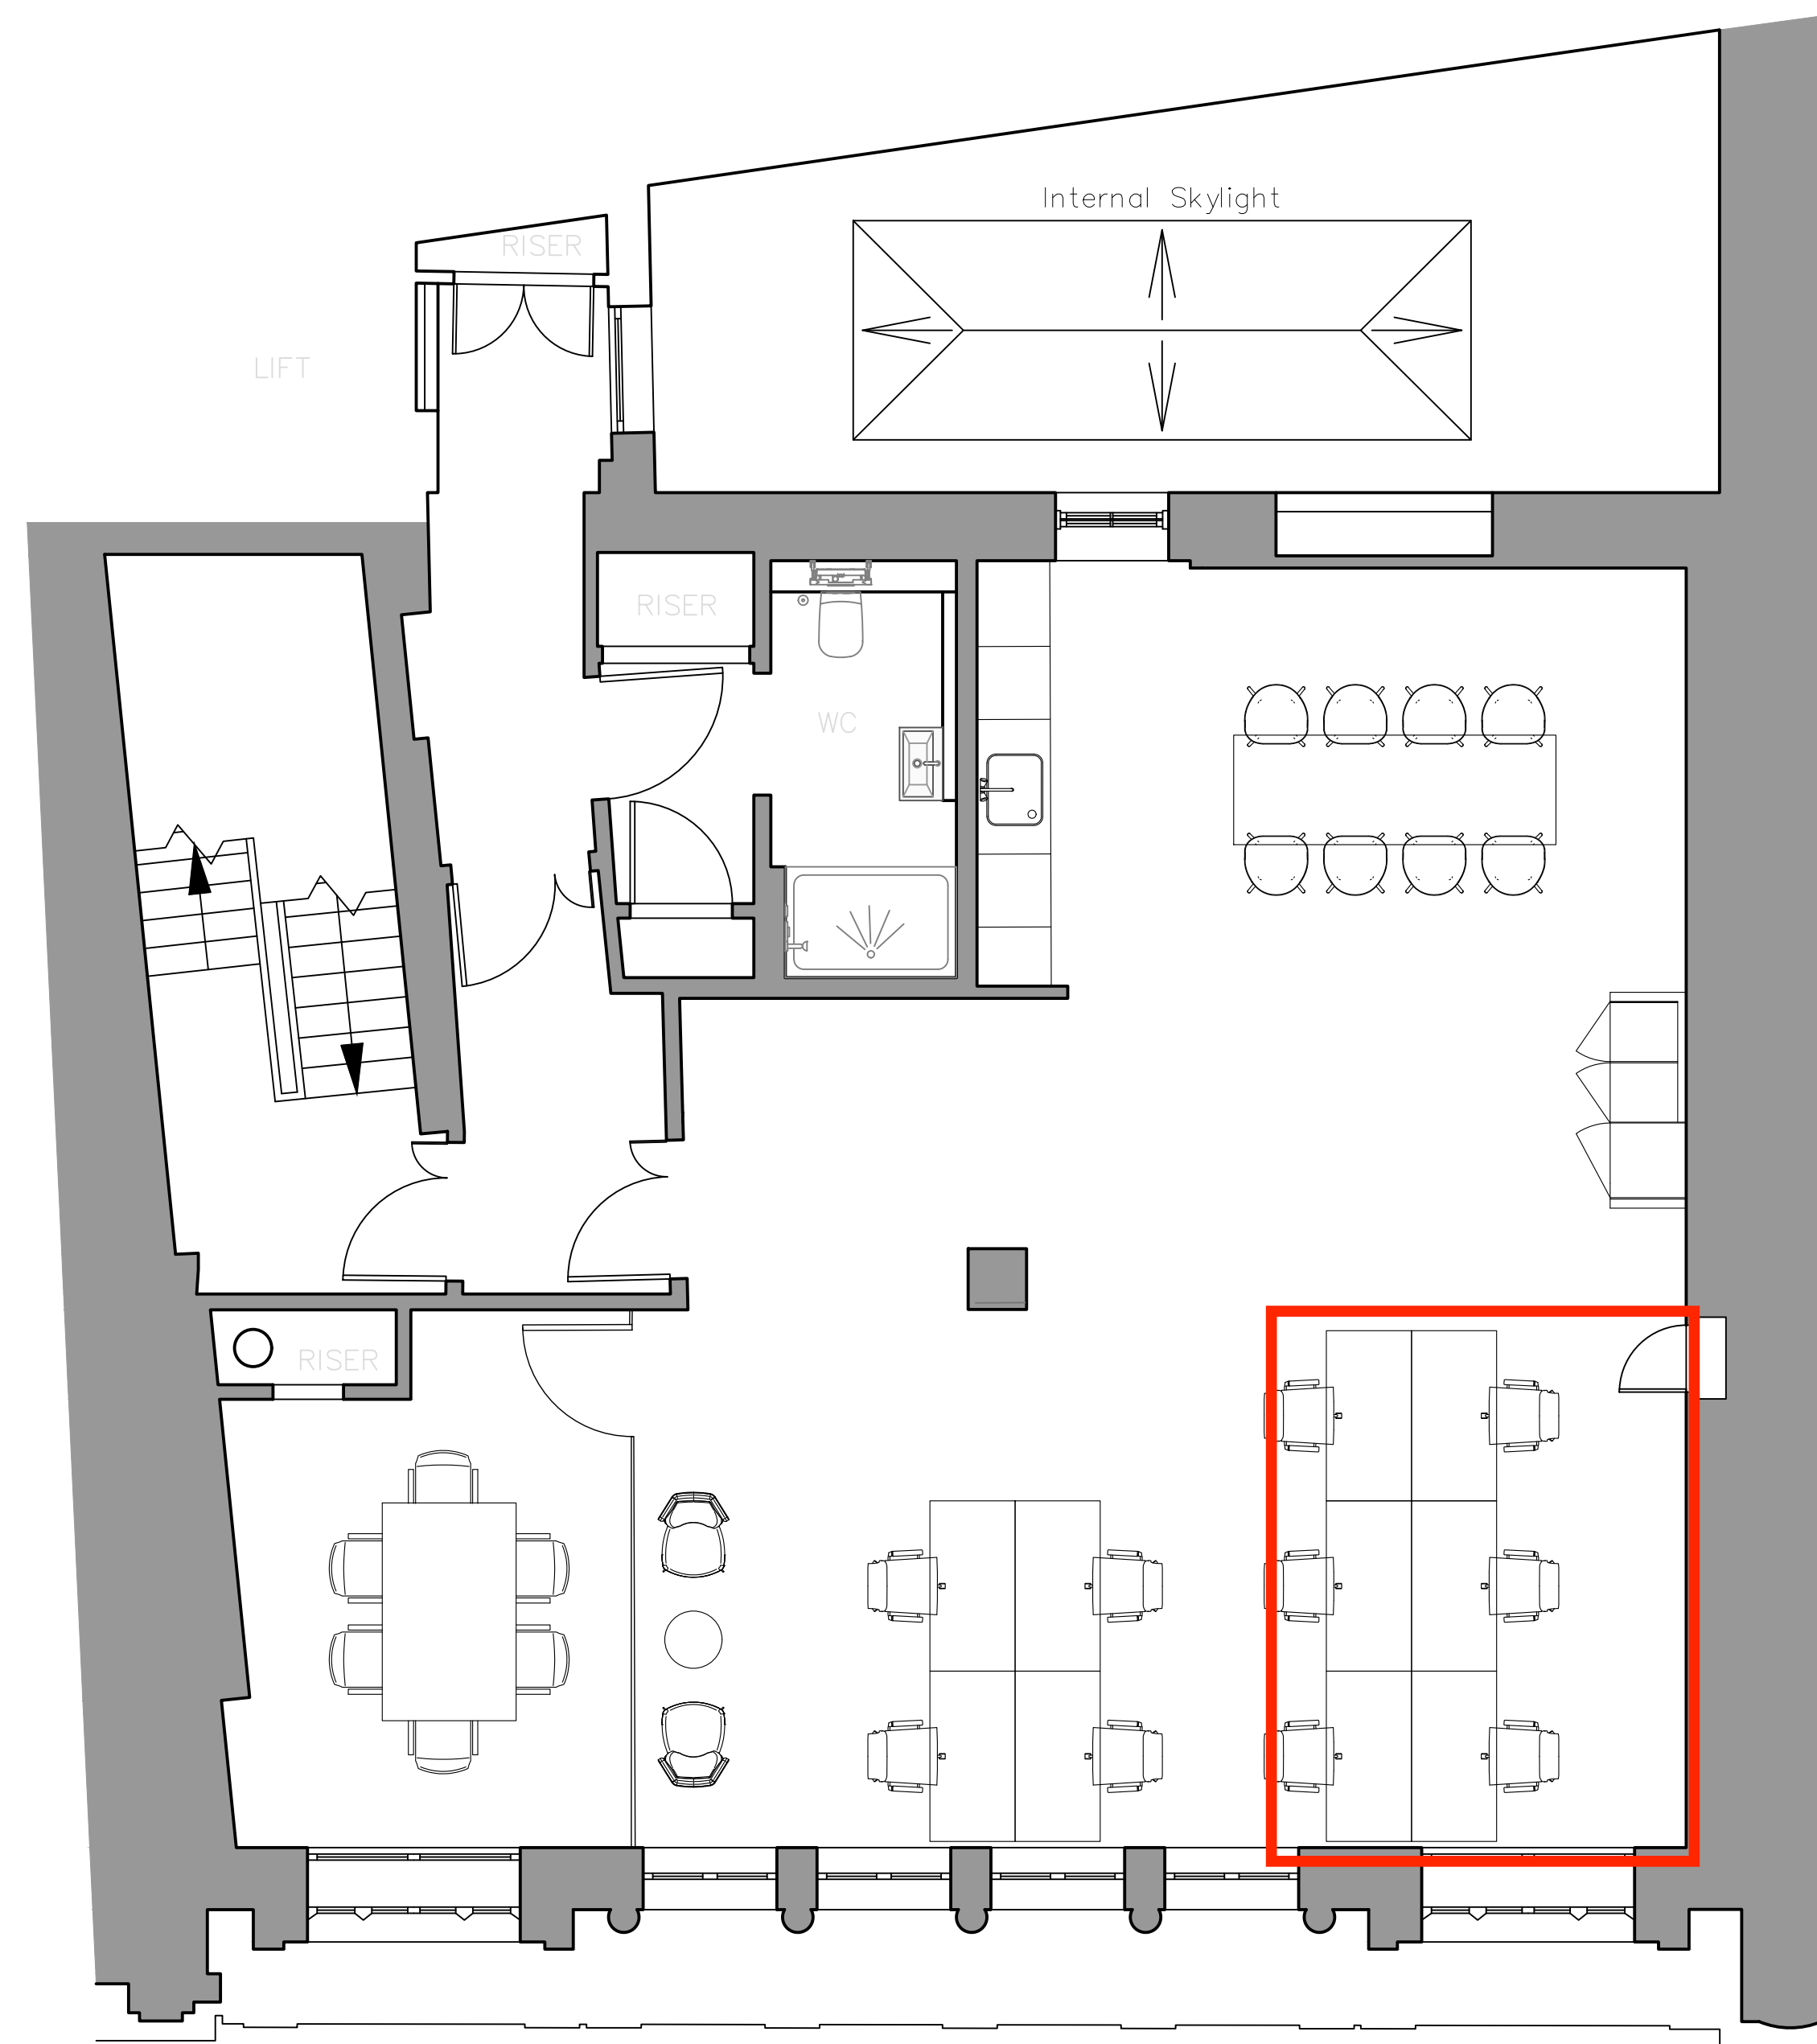

R E G E N T S T R E E T

TECHNICAL FEATURES

94 SQM/1012 SQFT
10 DESKS – 1400 x 700
BREAKOUT AREA
TEA POINT
6P MEETING ROOM
INFORMAL AREA
SUPERLOO / SHOWER ROOM

C				
B	28/01/21	LAYOUT AFTER COMMENT	EN	
A	27/01/21	LAYOUT AFTER SURVEY	FS	EN
REV	DATE	ISSUE	BY	CH

FOR CONCEPT

STATUS	DESCRIPTION
ISSUED FOR COMMENT	



PROJECT : Regent Street

CLIENT : The Crown Estate

PROJECT NO : J0020

DESCRIPTION GENERAL ARRANGEMENT
LEVEL 1

SCALE : 1:50 @ A1

DRAWING No : J0020_GA_01_B	REVISION : B
-------------------------------	-----------------