NOTE: CARPET AND LATEX TO ALL LOCATIONS WILL BE INSTALLED UNDER CAT A FIT OUT

Levels

SSL - Structural Slab Level

FFL - Finished Floor Level

FLOOR FINISH TYPES		
Section Preview	Building Material	
	F001 - Power Floated Slab	
	F003 - 5mm Finish (TBC) Laid Over 40mm Leveling Screed	
	F004 - 45mm Leveling Screed	
	F005 - Tile On Waterproff Substrate	
	F007 - 25mm Barrier Matting Laid Over 20mm of Leveling Screed	

FLOOR FINISH TYPES		
Section Preview	Building Material	
	F010 - Galvanised Metal Checker Plate Flooring	

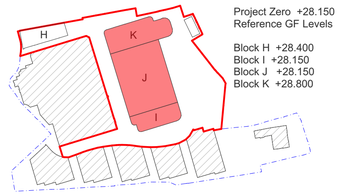

Project Zero +28.150
Reference GF Levels

Block H +28.400
Block I +28.150
Block J +28.150
Block K +28.800

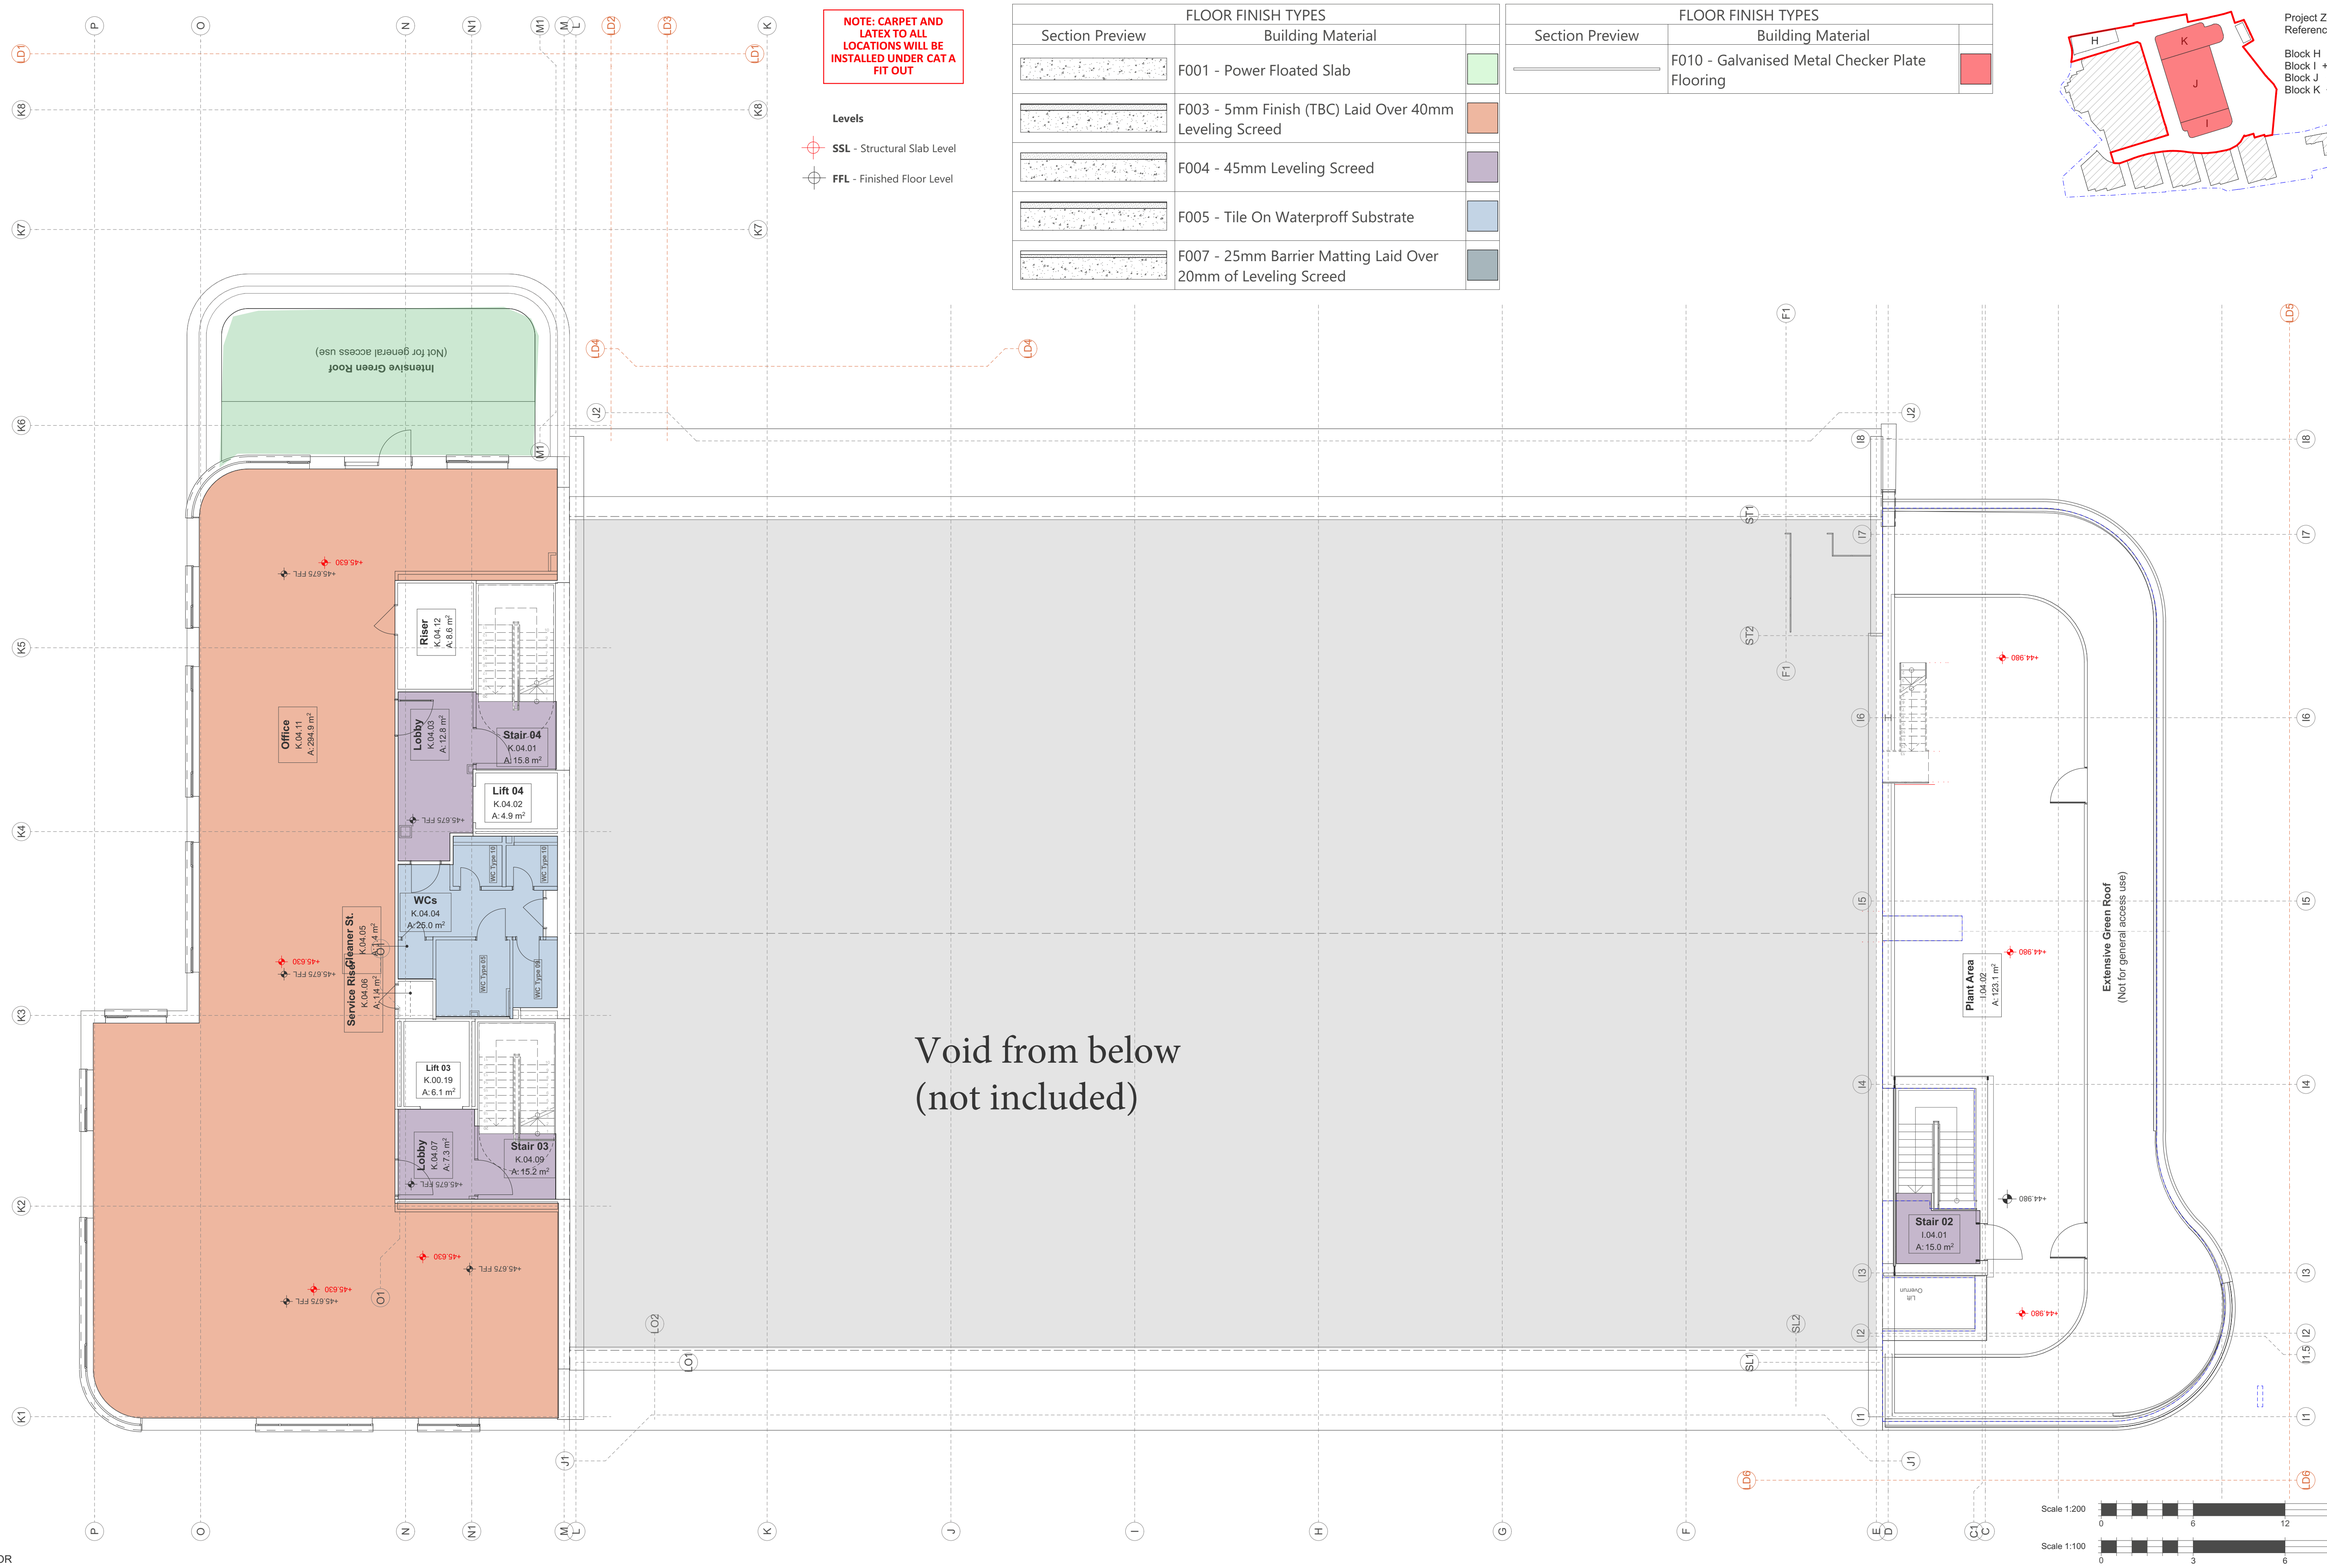

FOURTH FLOOR
1:100

Scale 1:200 — 0, 6, 12, 18m

Scale 1:100 — 0, 3, 6, 9m

Rev.	Revision Description	Drawn	Checked	Date
CR01	Constructed Record	DV	NC	19/03/2025

CH	AMENDMENTS

EALING STUDIOS
EALING GREEN, LONDON, W5 5EP

Client
EALING STUDIO OPERATIONS

STAGE 5
BUILDING I, J & K
BUILDING I, J & K - FOURTH FLOOR PLAN

CDA Ref
686

Scale(s)
(1:100 A1)
1:200 @ A3

Drawing Number

Project	Originator	Volume	Level	Type	Role	Class	Number
G1151	CDA	IJK	04	DR	A	43	0105

Revision	Suitability	Revision Description
CR01	CR	Constructed Record