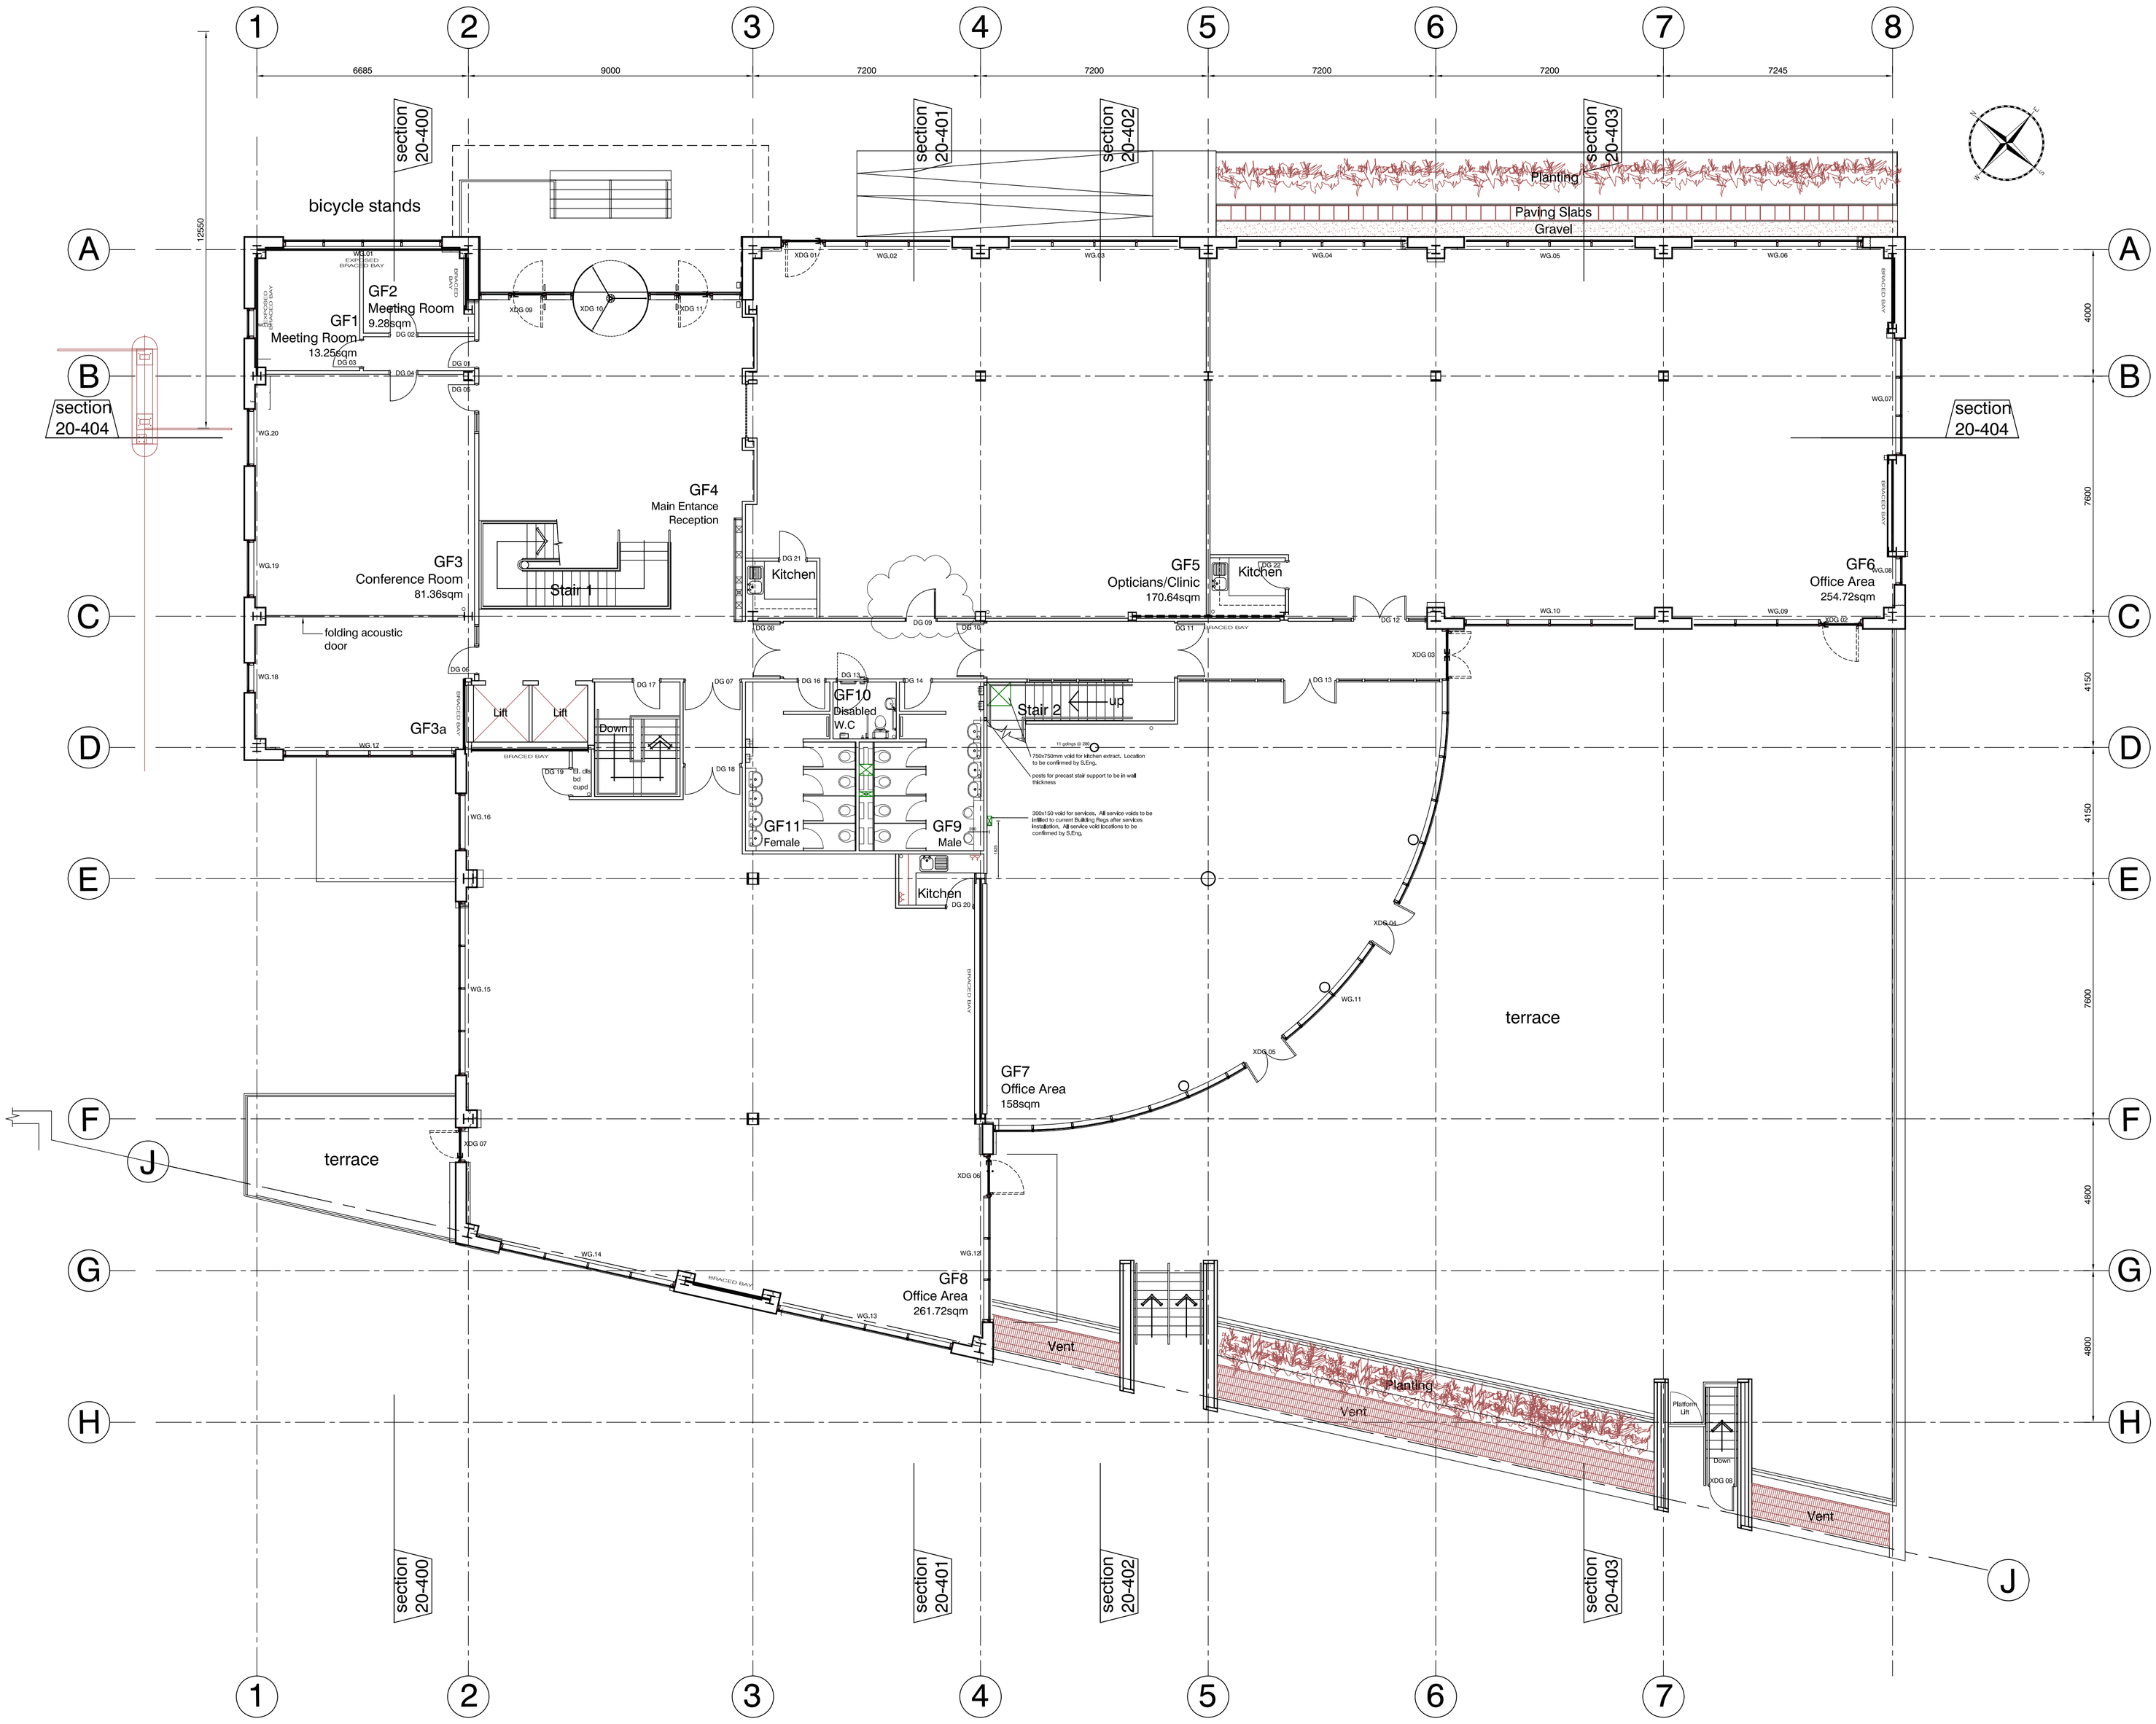

Notes

Do not scale this drawing.
Any discrepancy or query concerning this drawing should be referred to the Architect.

Q	31.08.07	clg	DG09 altered location.
P	30.08.07	clg	DG09 altered from double screen door to singl door. Adjacent kitchen altered to suit new door location.
N	20.08.07	olt	general Ammendments
M	12.07.07	olt	Internal Stairs between GL 4 & 5 ammended. Revised location & size of void in wc service duct. Stair 1 landing width increased chs added Main entance doors altered, 2No SHS rwp added in lieu of 100mm dia rwp. Opticians GF5 entrance altered. Ramp altered.
L	05.07.07	clg	Front entrance revised -XD09-11 references added, altered wall junction on grid line D2, revised lift shaft openings. Service voids added in wc & kitchen , soil pipe added GL 4C. service riser off GL 3 main entrance shown.
K	15.05.07	clg	Revised entrance stair
J	09.05.07	olt	Generall ammendments
H	19.04.07	olt	Generall ammendments - paving slabs added
G	16.03.07	olt	Ammended to suit new S.E drgs
F	02.03.07	olt	Landscape altered
E	20.02.07	olt	Revolver doors added, exeternal steps ammended, ramp ammended
D	07.02.07	olt	Issued for construction
C	22.01.07	olt	Core and entrance ramp updated
B	18.12.06	j	Opticians relocated near Atrium

PRELIMINARY DRAWING Ethos Implementation Agreement/Development Agreement	ETHOS PROJECT 2006\HOA\Ethos\Ethos-Homes\ADMIN\ccirft-logo2.jpg

Rv	Date	Init	Ch

Revisions

Issue
For Construction

Project
ETHOS PROJECT
Proposed Offices
Plot A1
Port Tawe, Swansea

Drawing Title
Ground Floor Plan

drawn by	date	scale
wje	March '06	1:100@a1
checked by	date	
***	***	

hlnarchitects
21/22, Neptune Court, Vanguard Way
Cardiff, CF24 5PJ
telephone 029 2039 8611
facsimile 029 2037 4690
email admin@hlnarchitects.com

Job No	Drawing No	Revision
5305	20 - 202	Q