



JCW - 31.03.2025

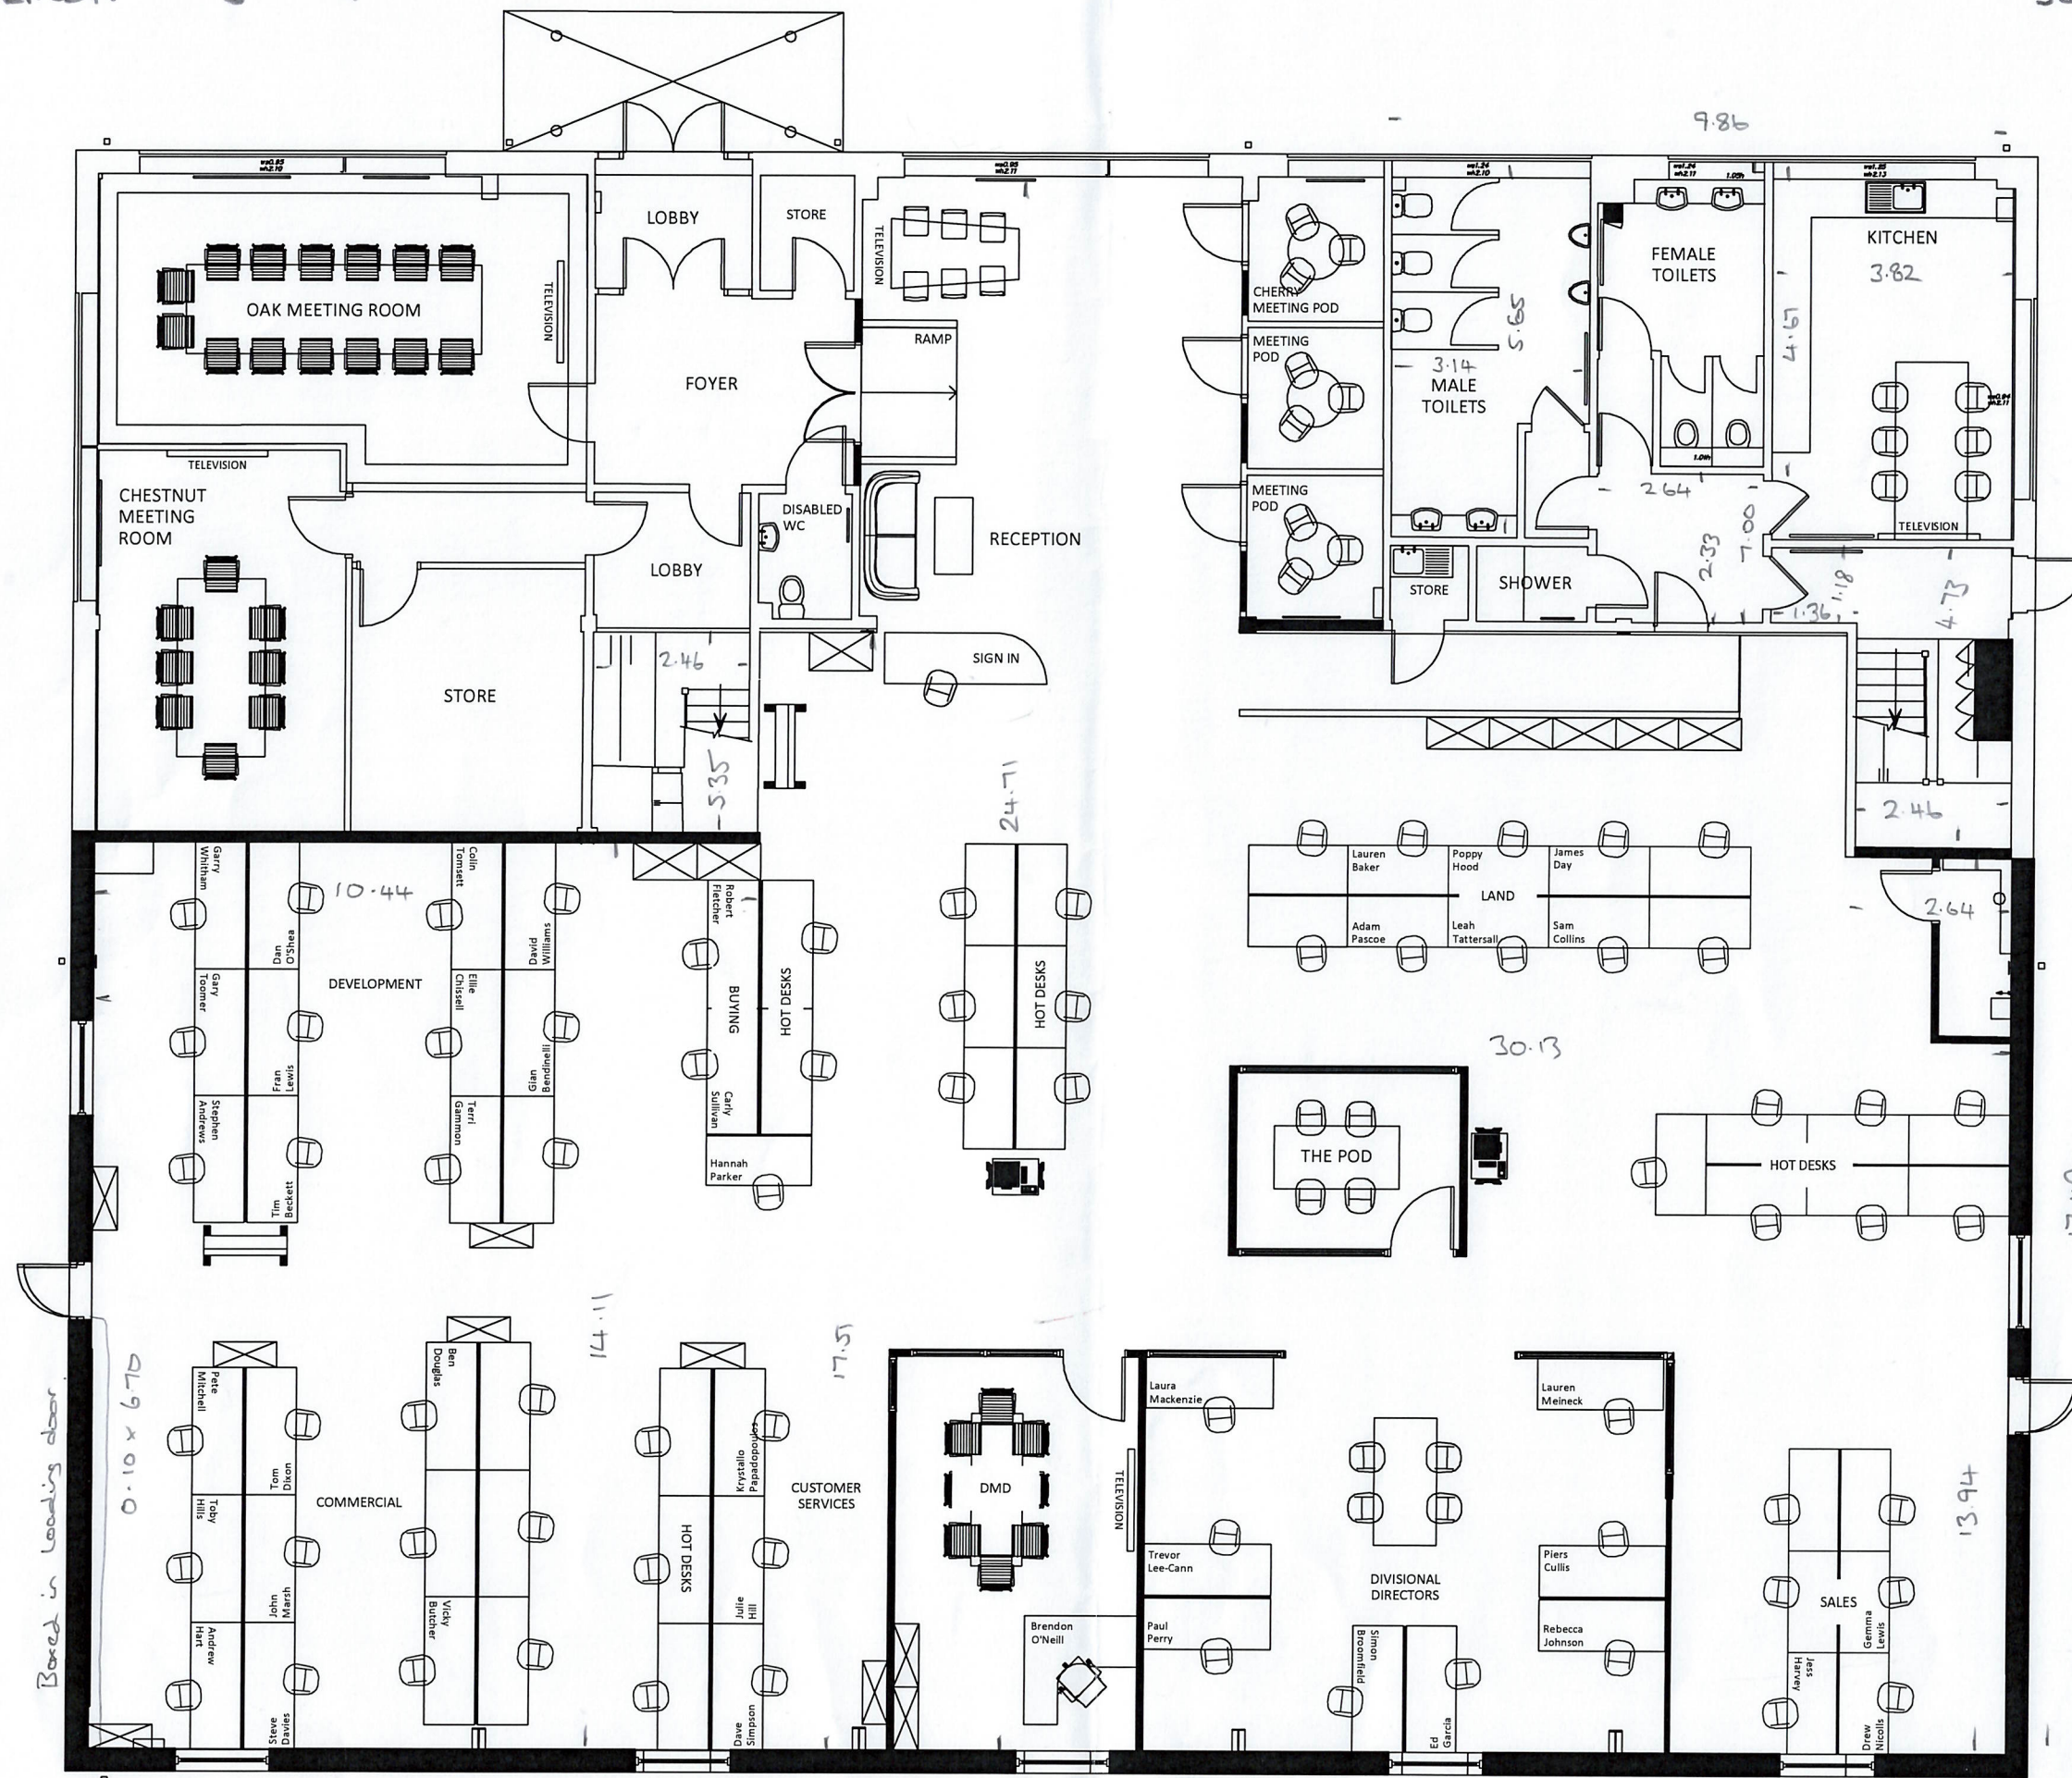

Ground Floor Plan -26/05/23

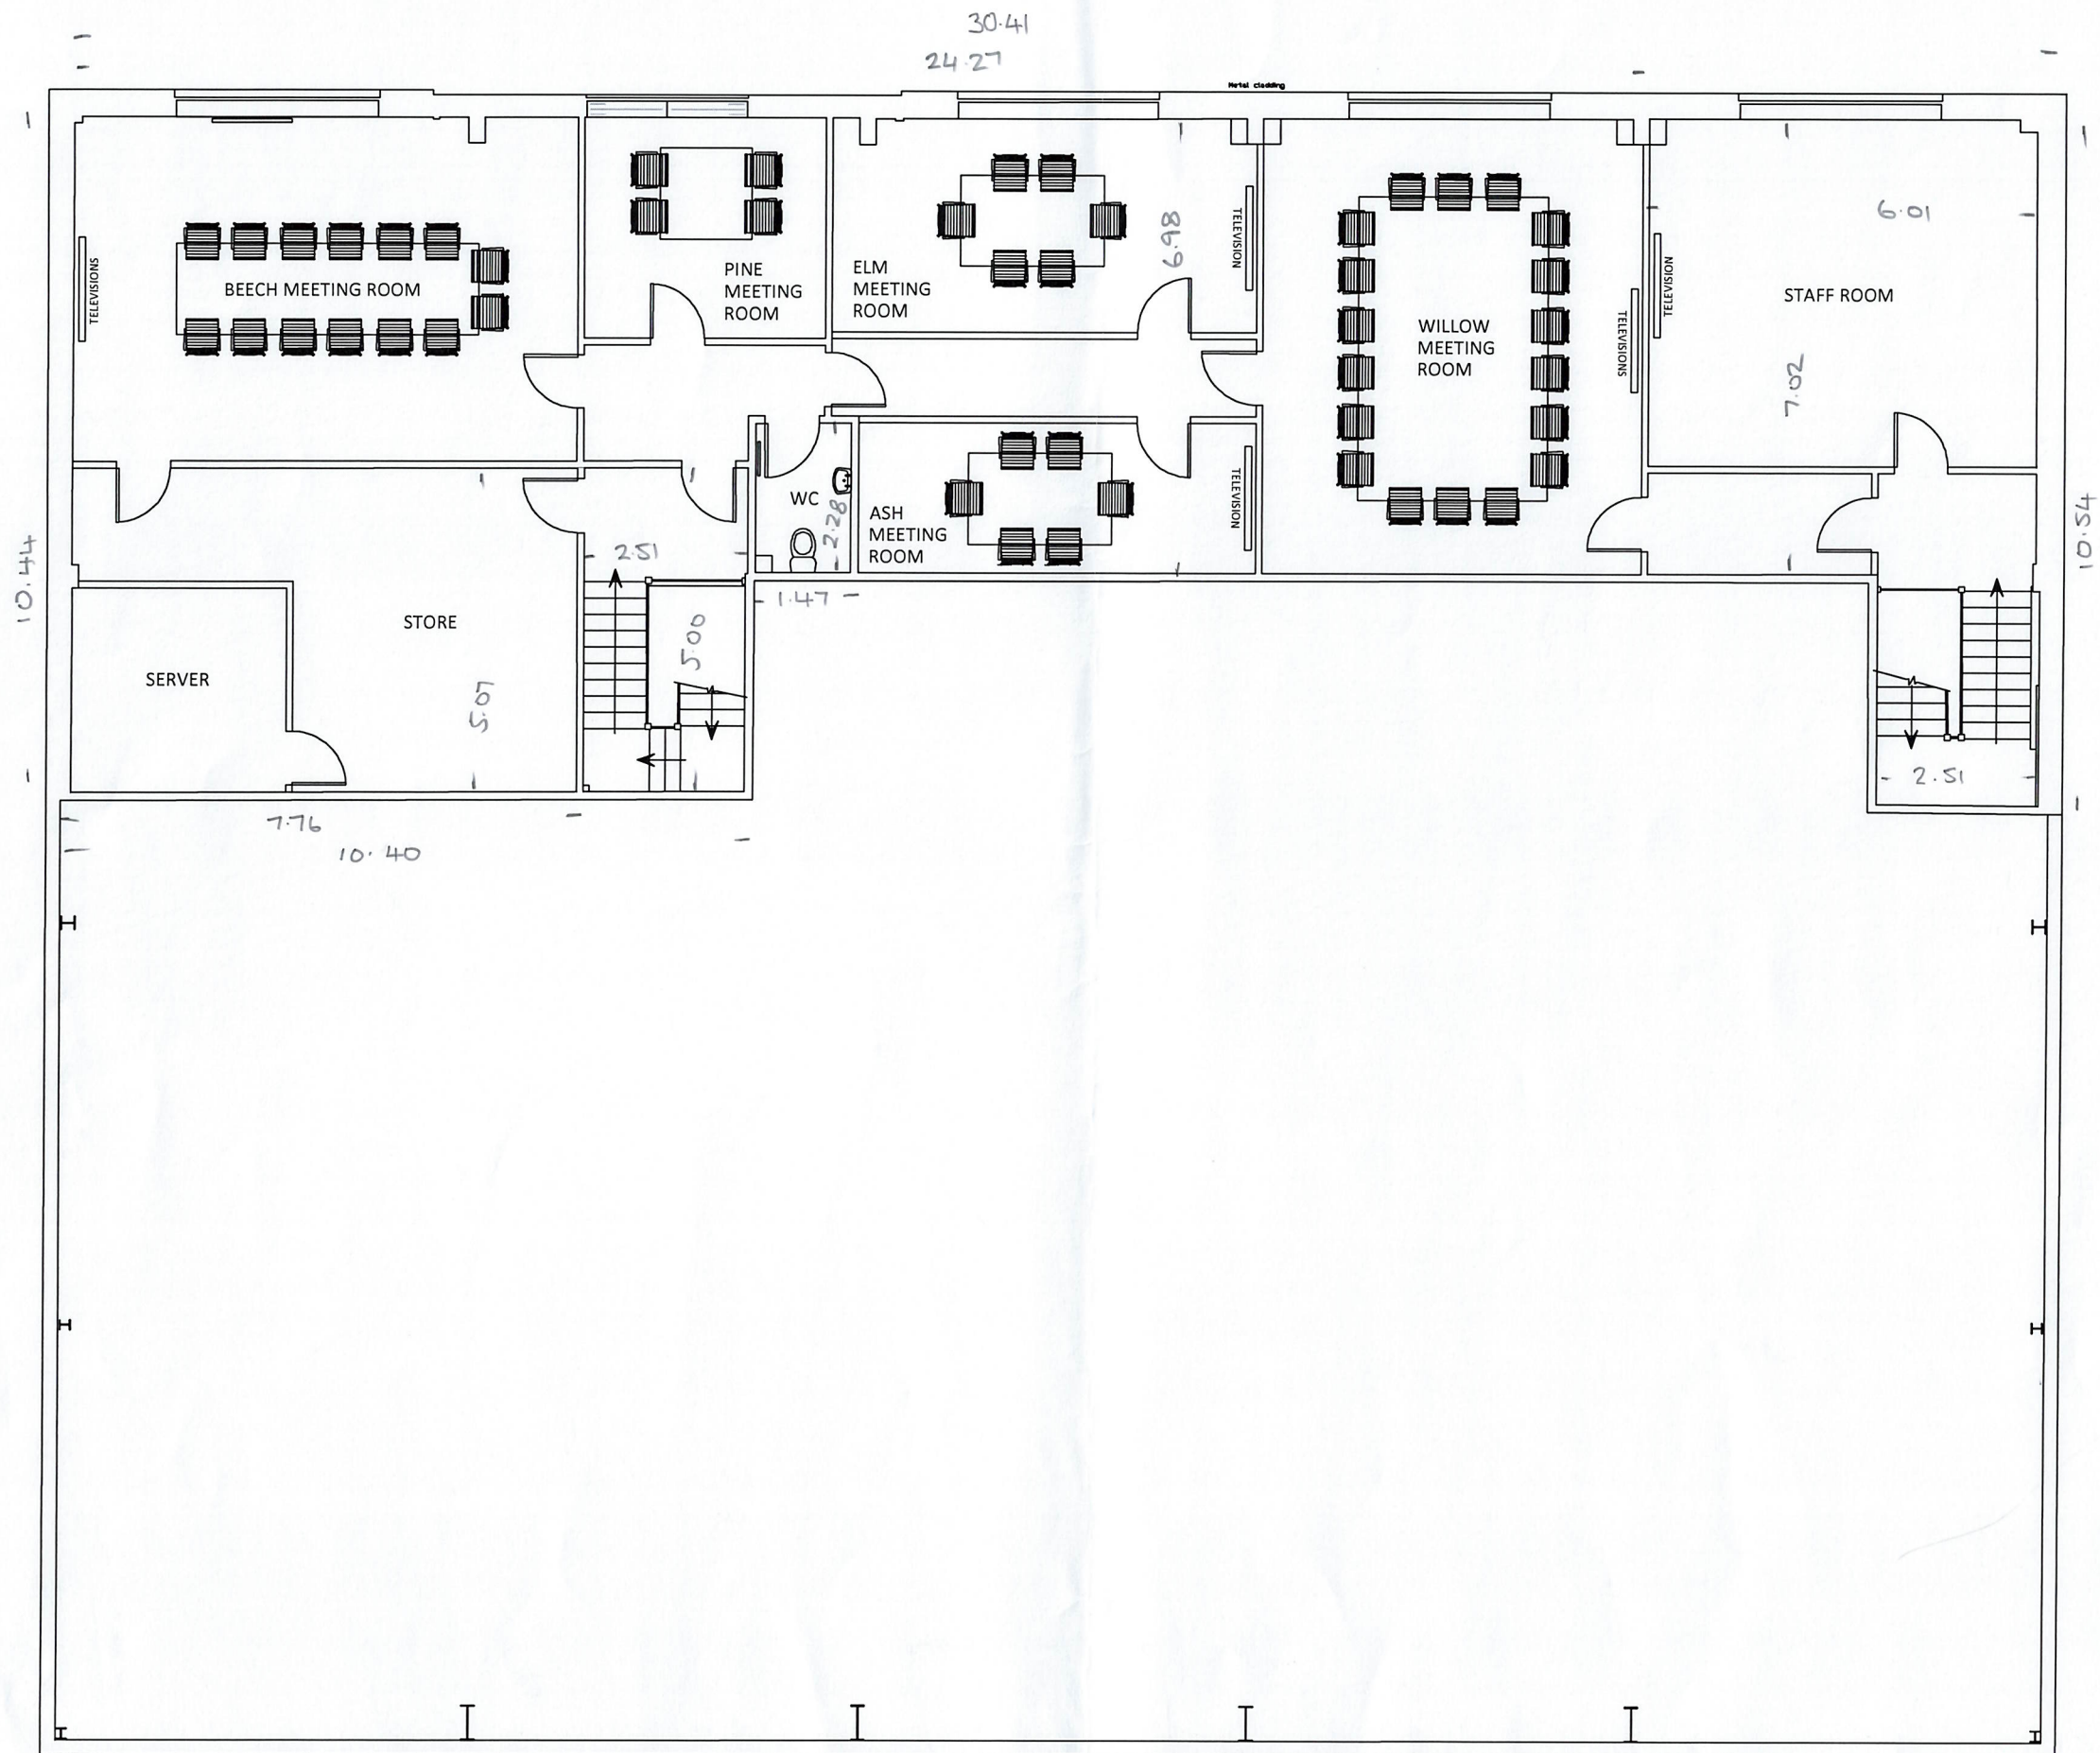

First Floor Plan -26/05/23