


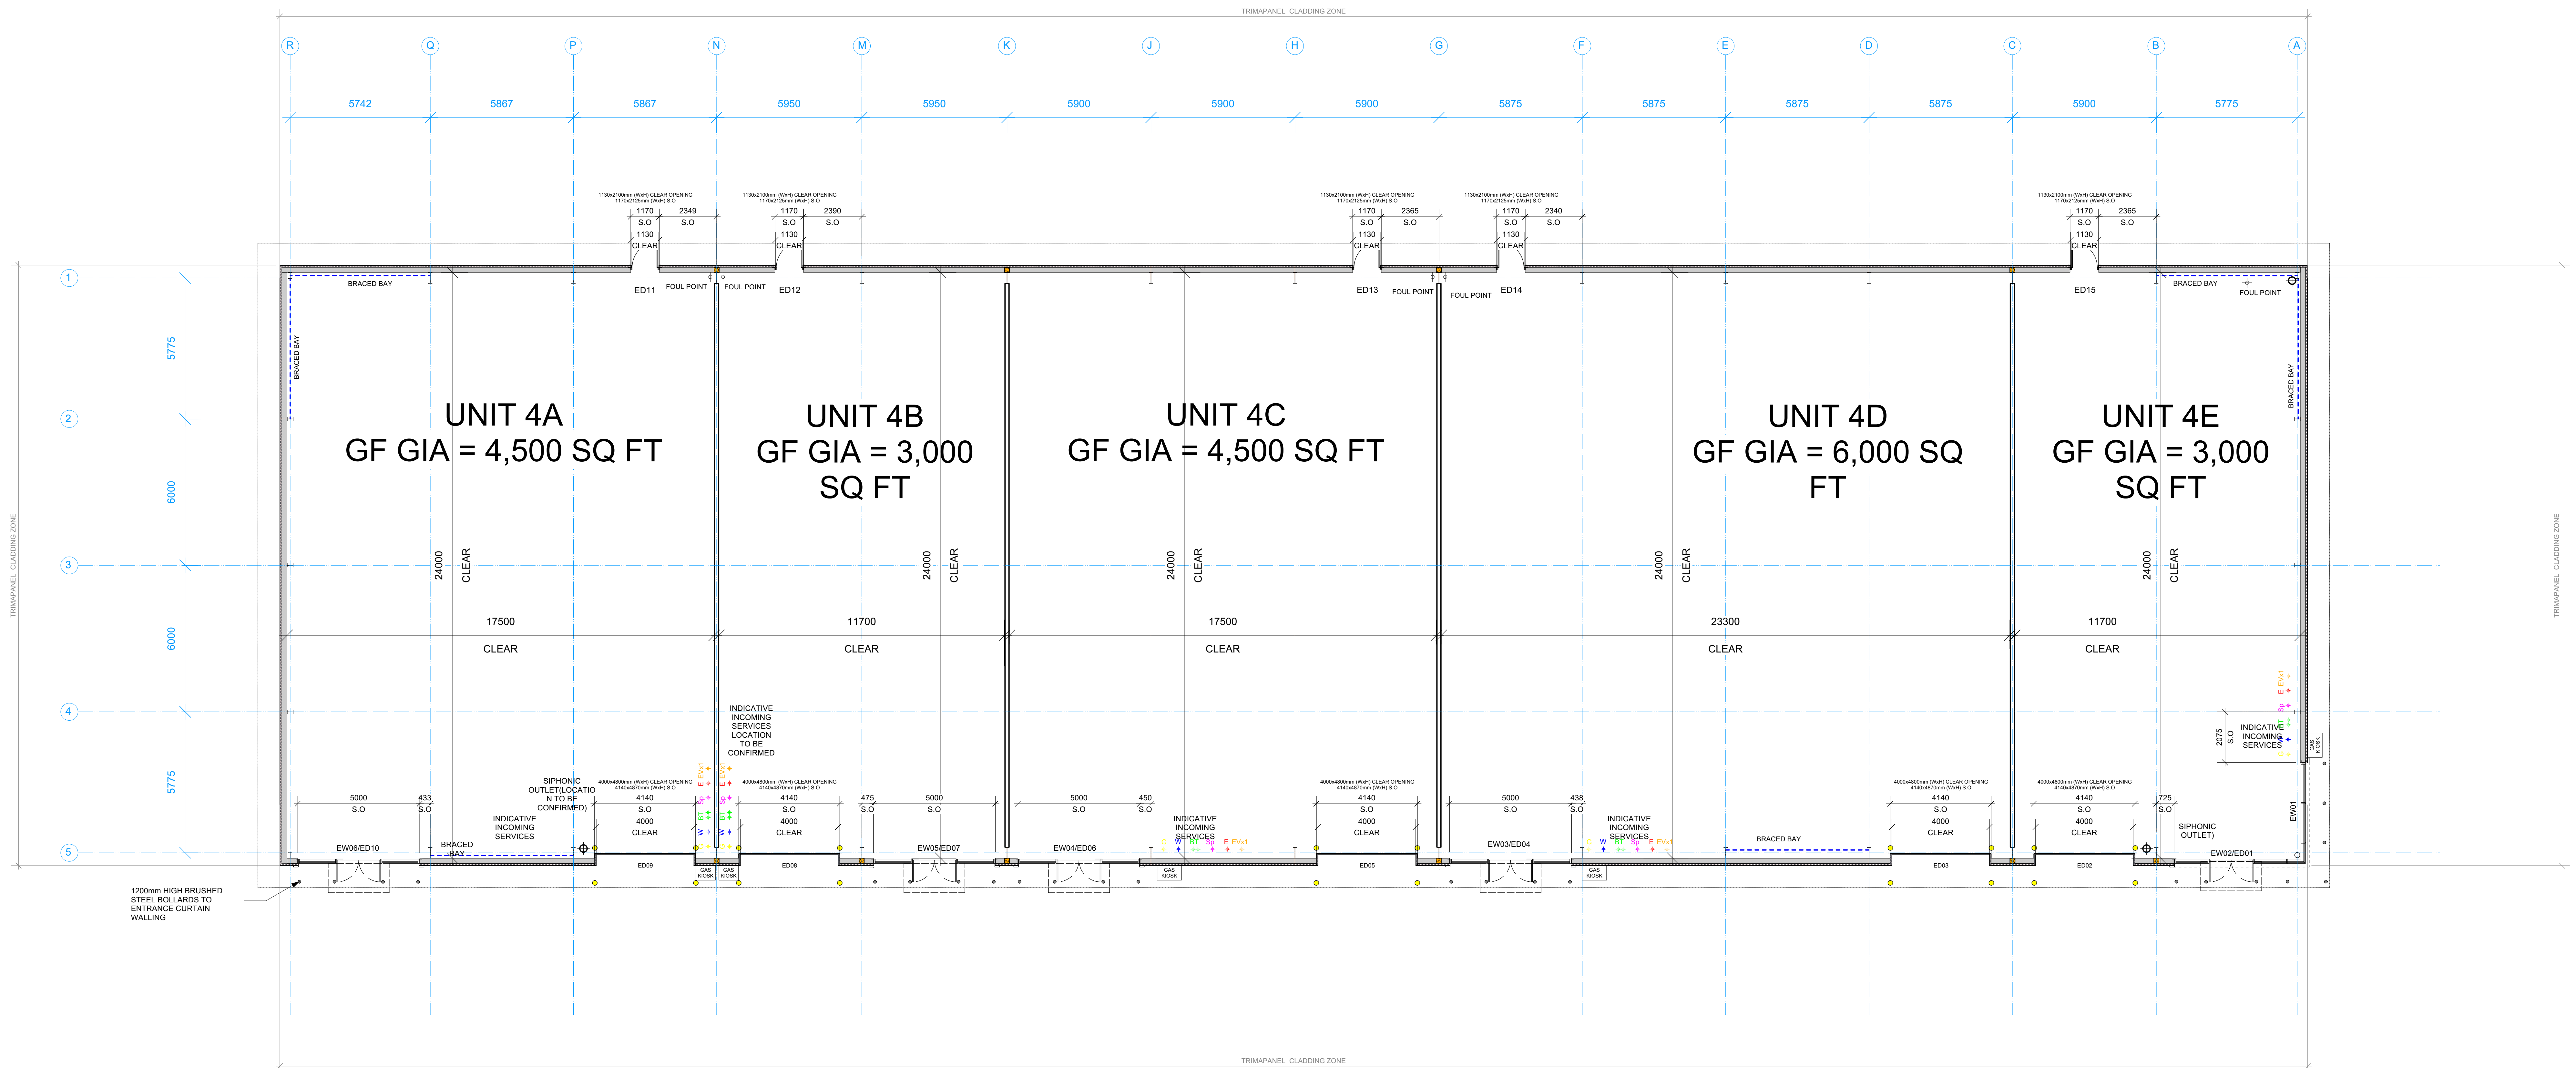

ALL U VALUES TO BE IN ACCORDANCE WITH THE SBEM REPORT, PROVIDED BY THE MAIN CONTRACTOR.

ALL INCOMING SERVICES SUBJECT TO DETAILED DESIGN BY HVSS

DRAWING TO BE READ IN CONJUNCTION WITH GOODRICH CONSULTING WRITTEN SPECIFICATION.

REFER TO FIRE BOUNDARIES DRAWINGS FOR INFORMATION ON FIRE BOUNDARY REQUIREMENTS

ALL STRUCTURE SHOWN INLINE PRP CONSULTING ENGINEERS INFORMATION. SUBJECT TO DETAILED DESIGN BY STEELWORK SUB CONSULTANT.

Rev	Date	Description	Drawn

client
hpconstruction
TUNGSTEN
PROPERTIES

project
Greenland Road, Sheffield
drawing title
Unit 4 GA Floor Plan

date August 2022
status As Built
scale 1:100 @ A1
drawn BW checked DW
job no. 2438 dwg no. C4-100 rev.

htcarchitects
8 Briarlea Street
Leeds LS1 2DZ
T: 0113 244 3457
W: www.htcarchitects.co.uk
E: admin@htcarchitects.co.uk