



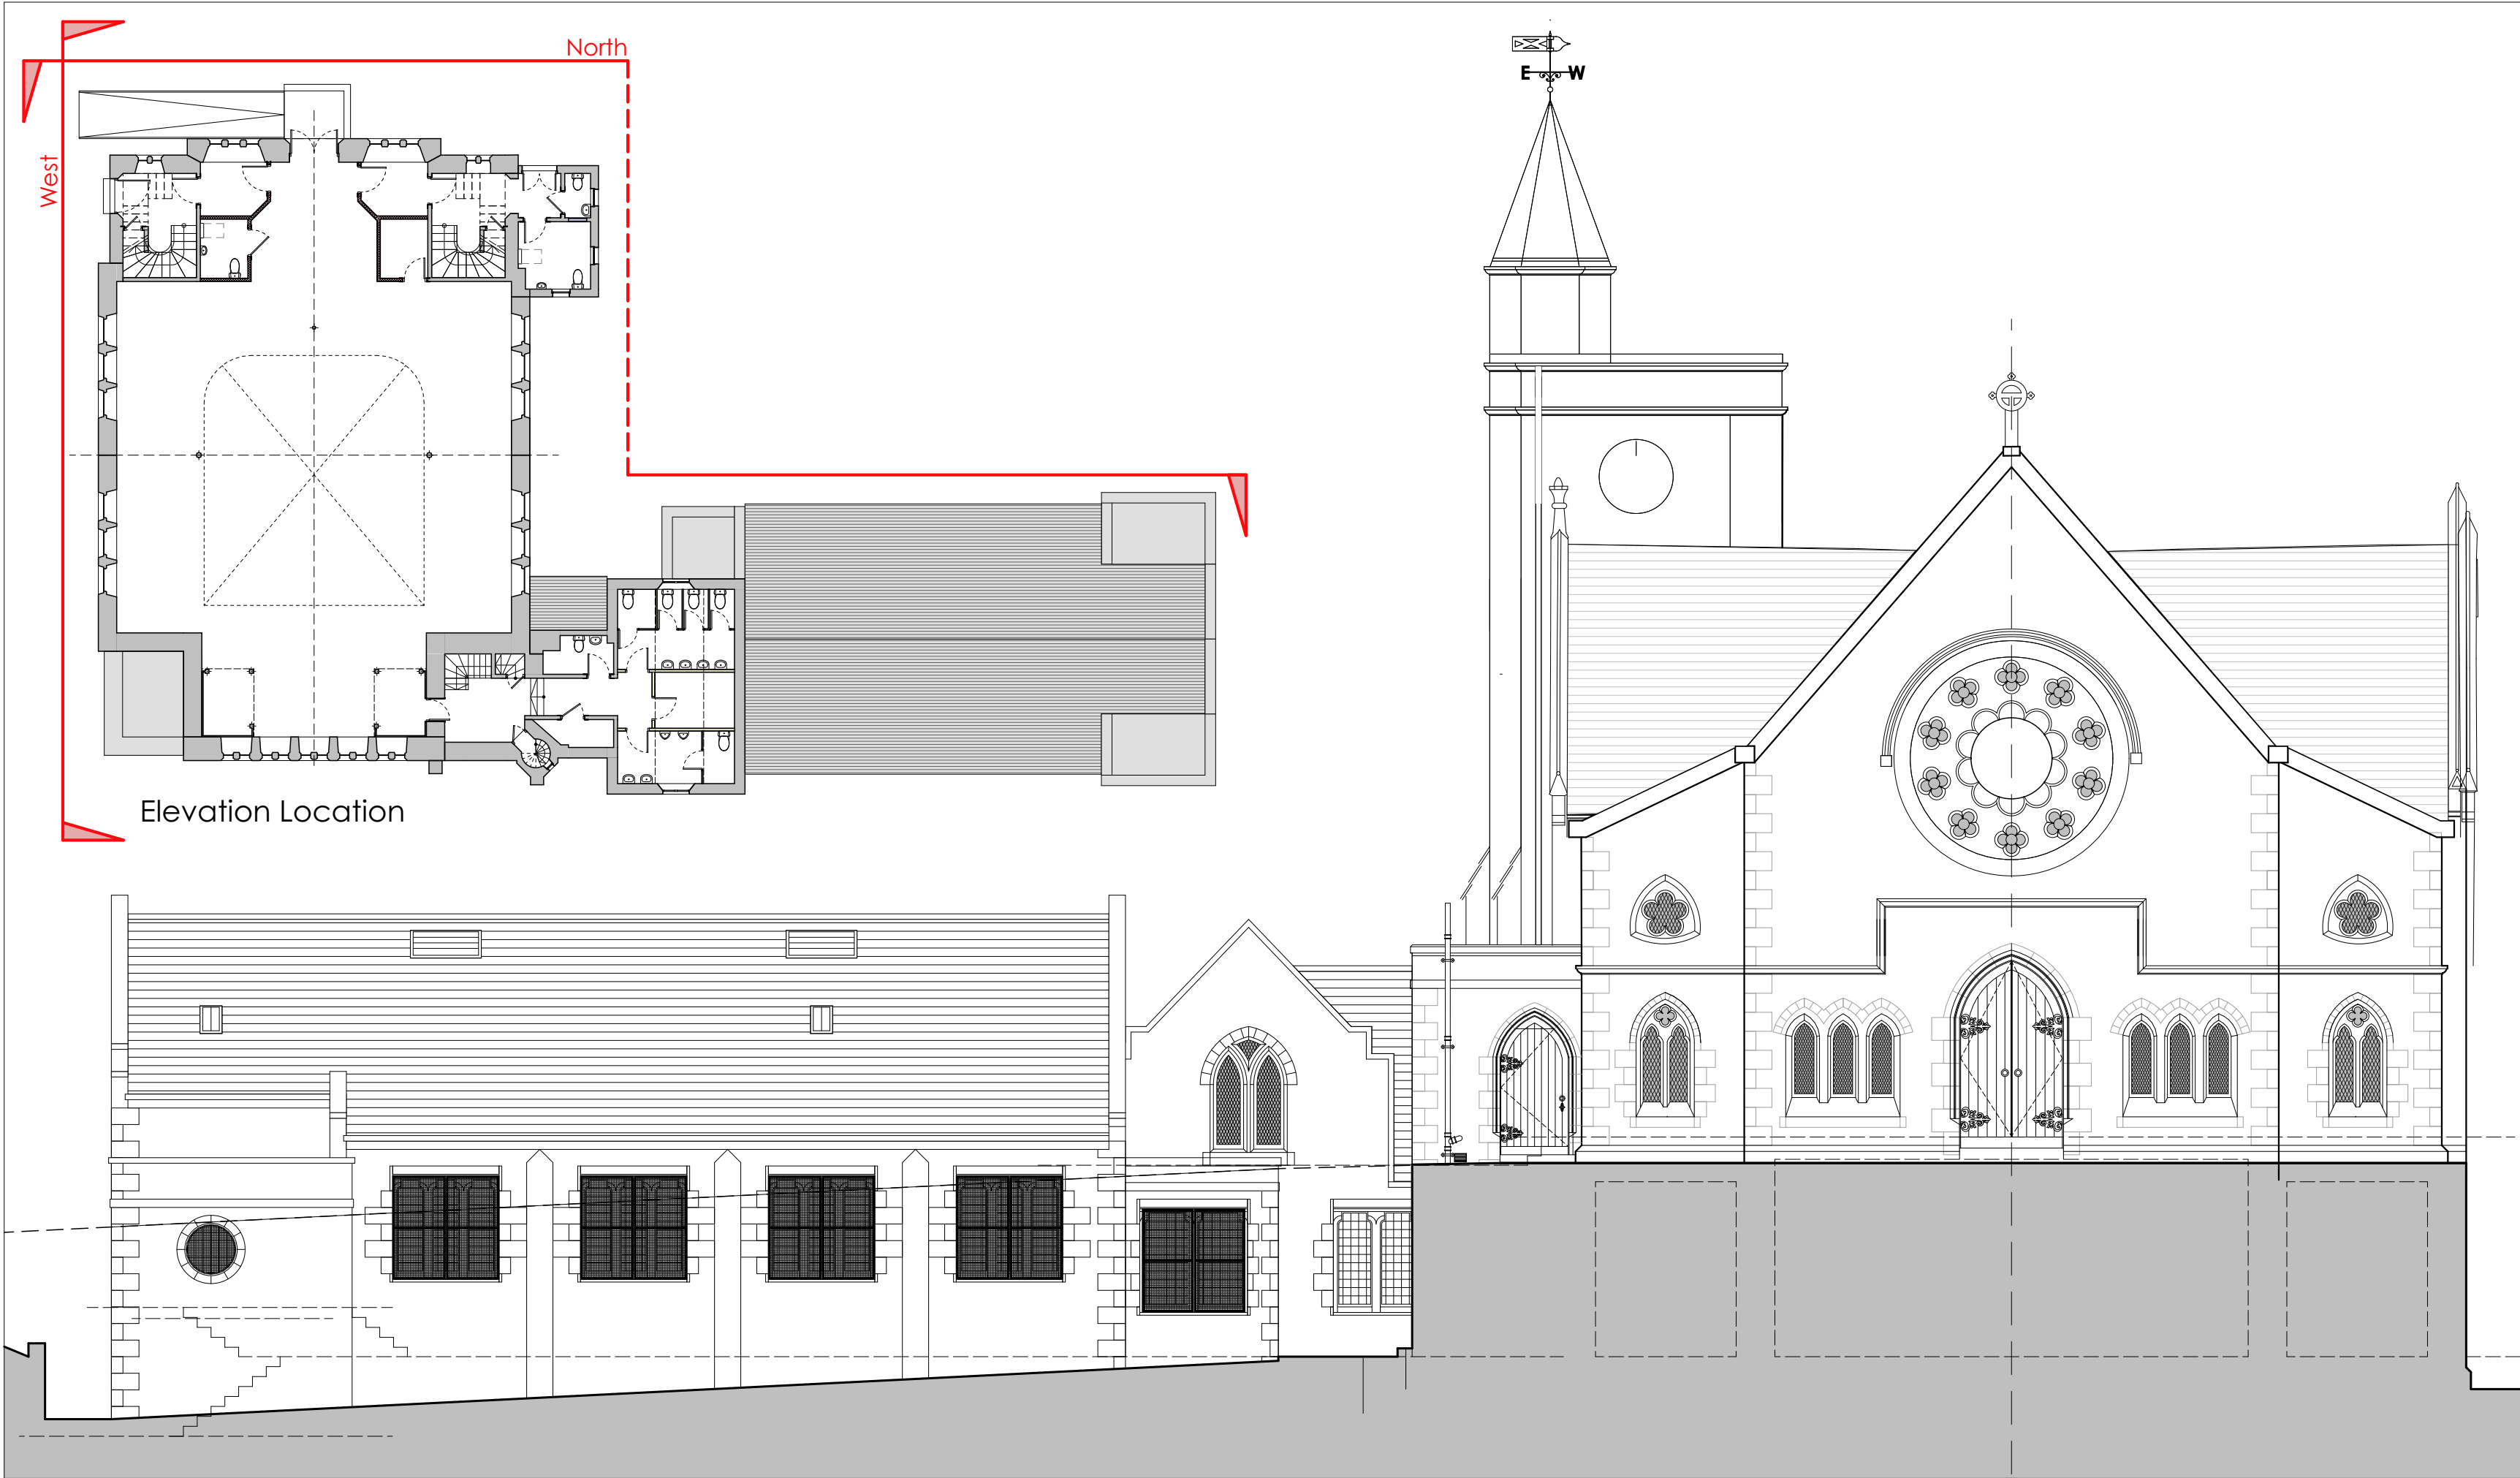


NORTH ELEVATION AS EXISTING




WEST ELEVATION AS EXISTING

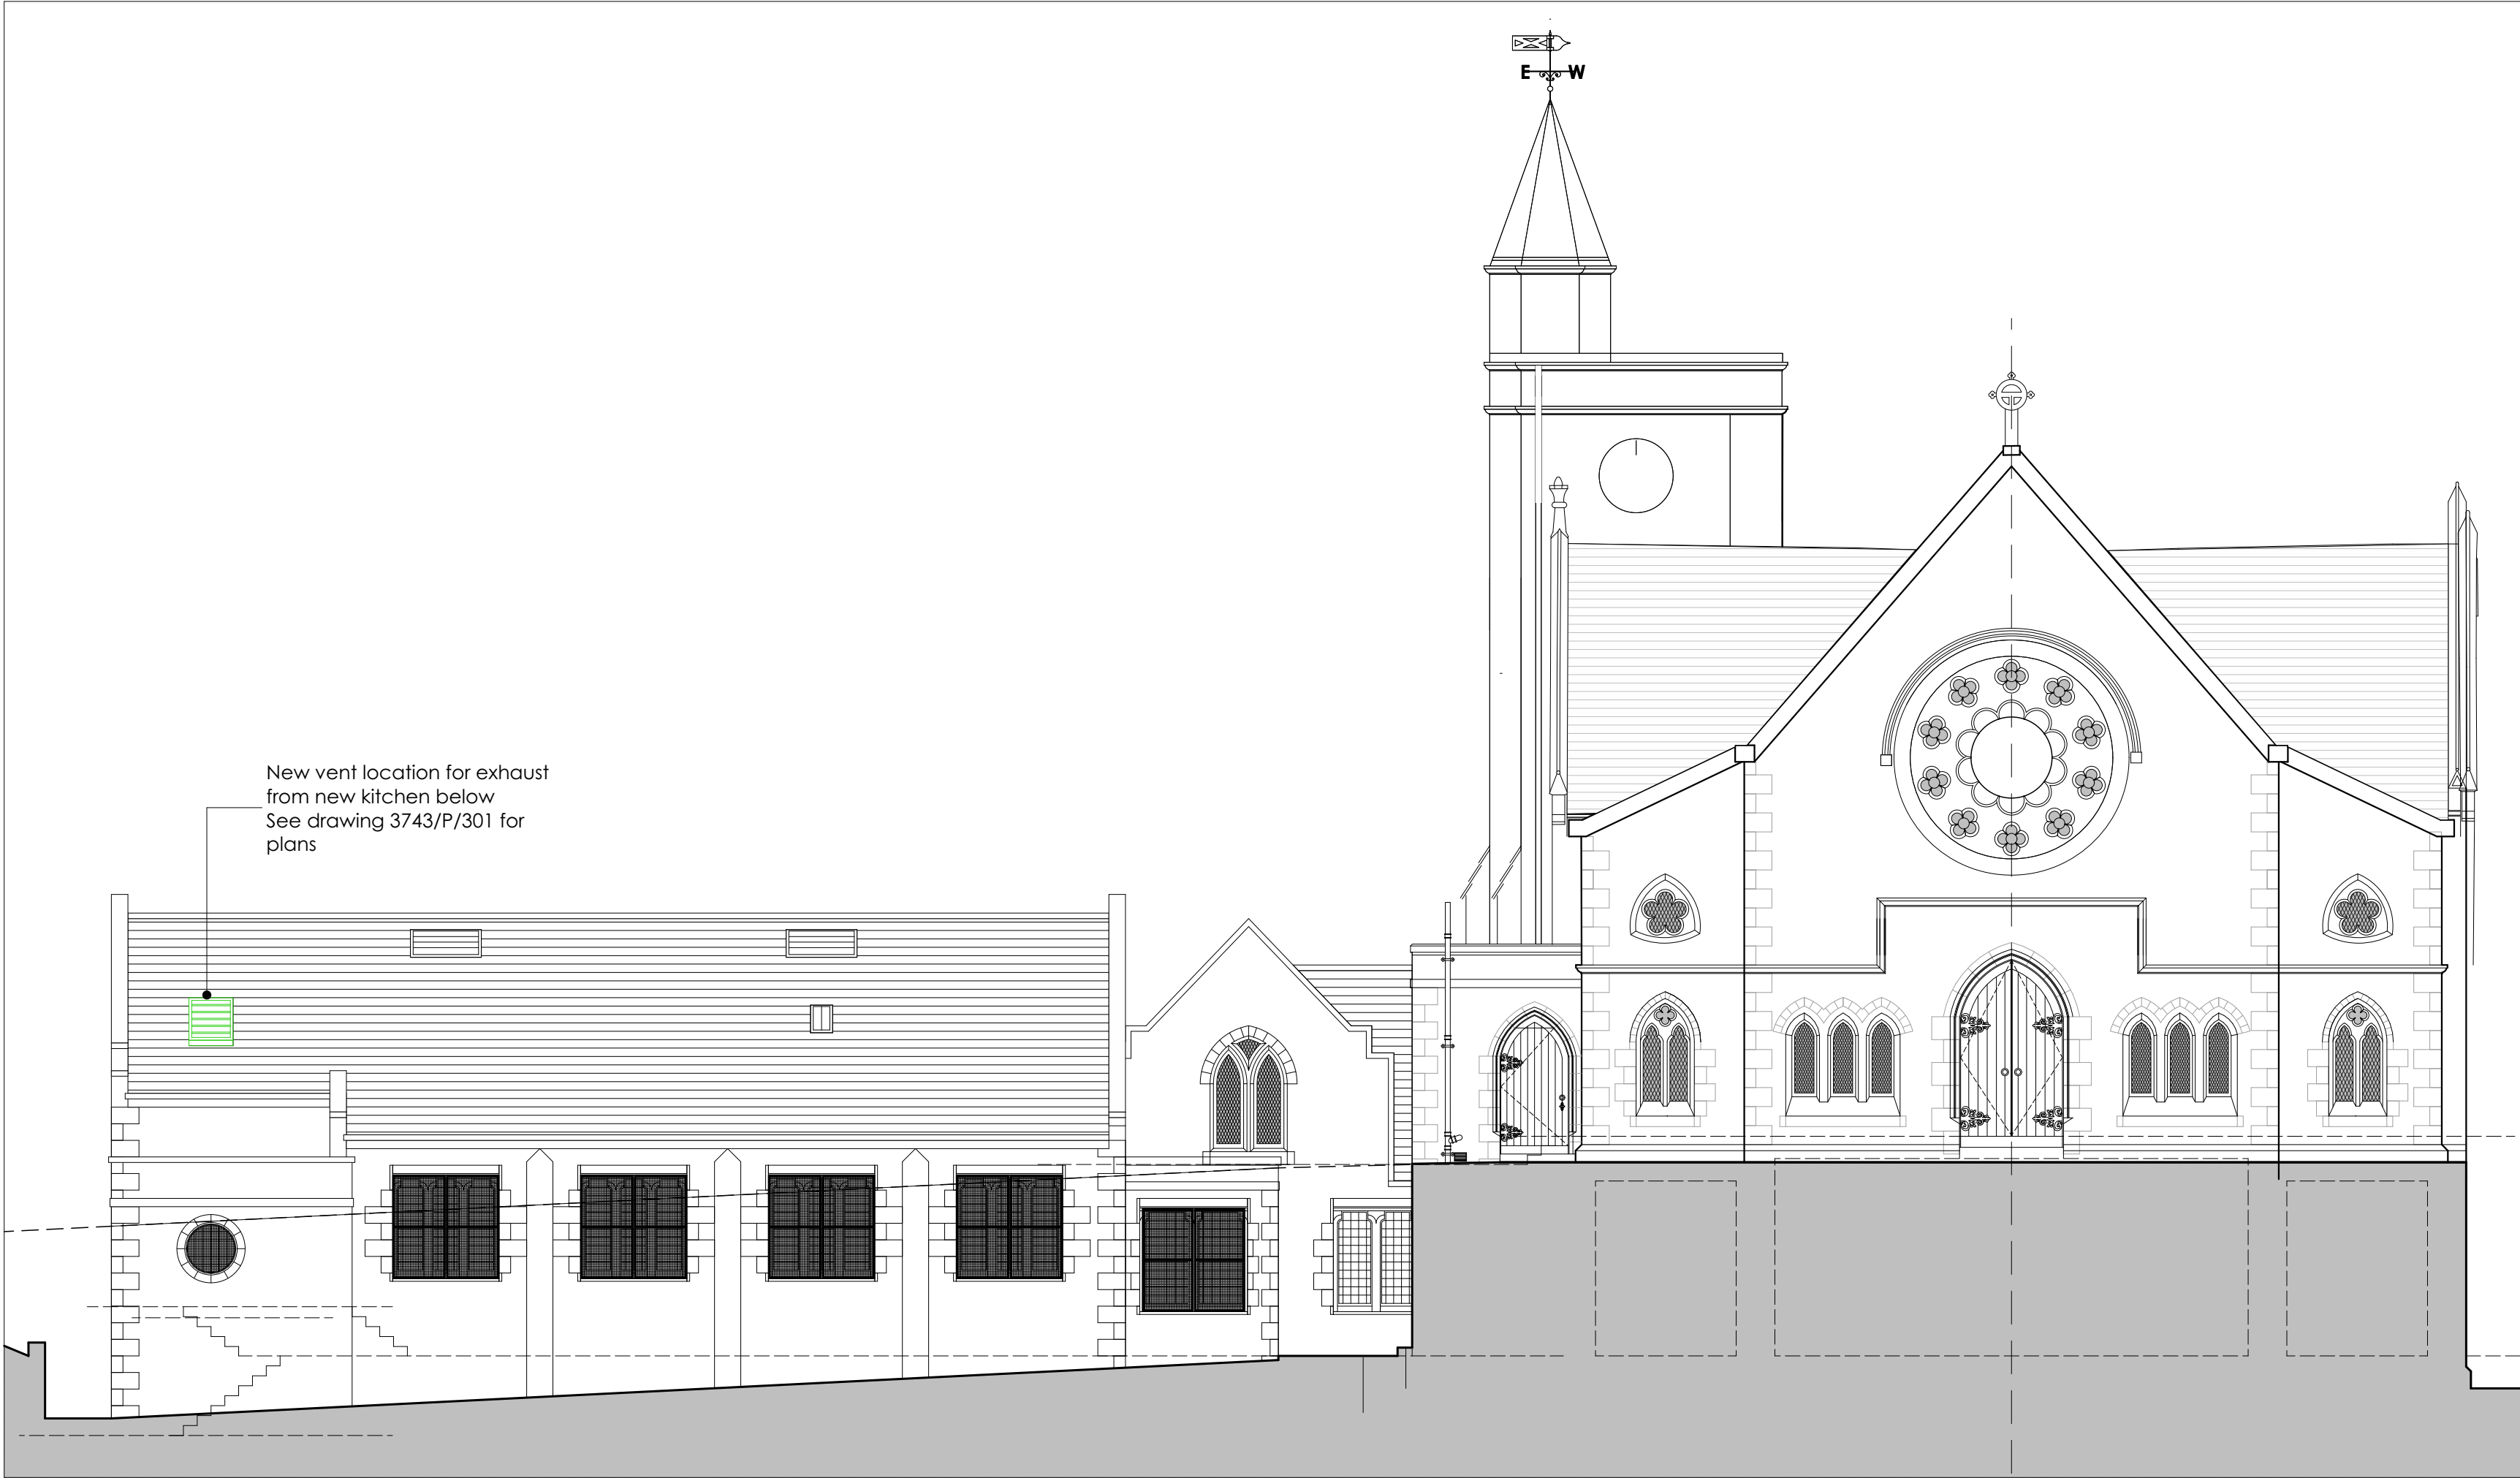

NORTH ELEVATION AS PROPOSED

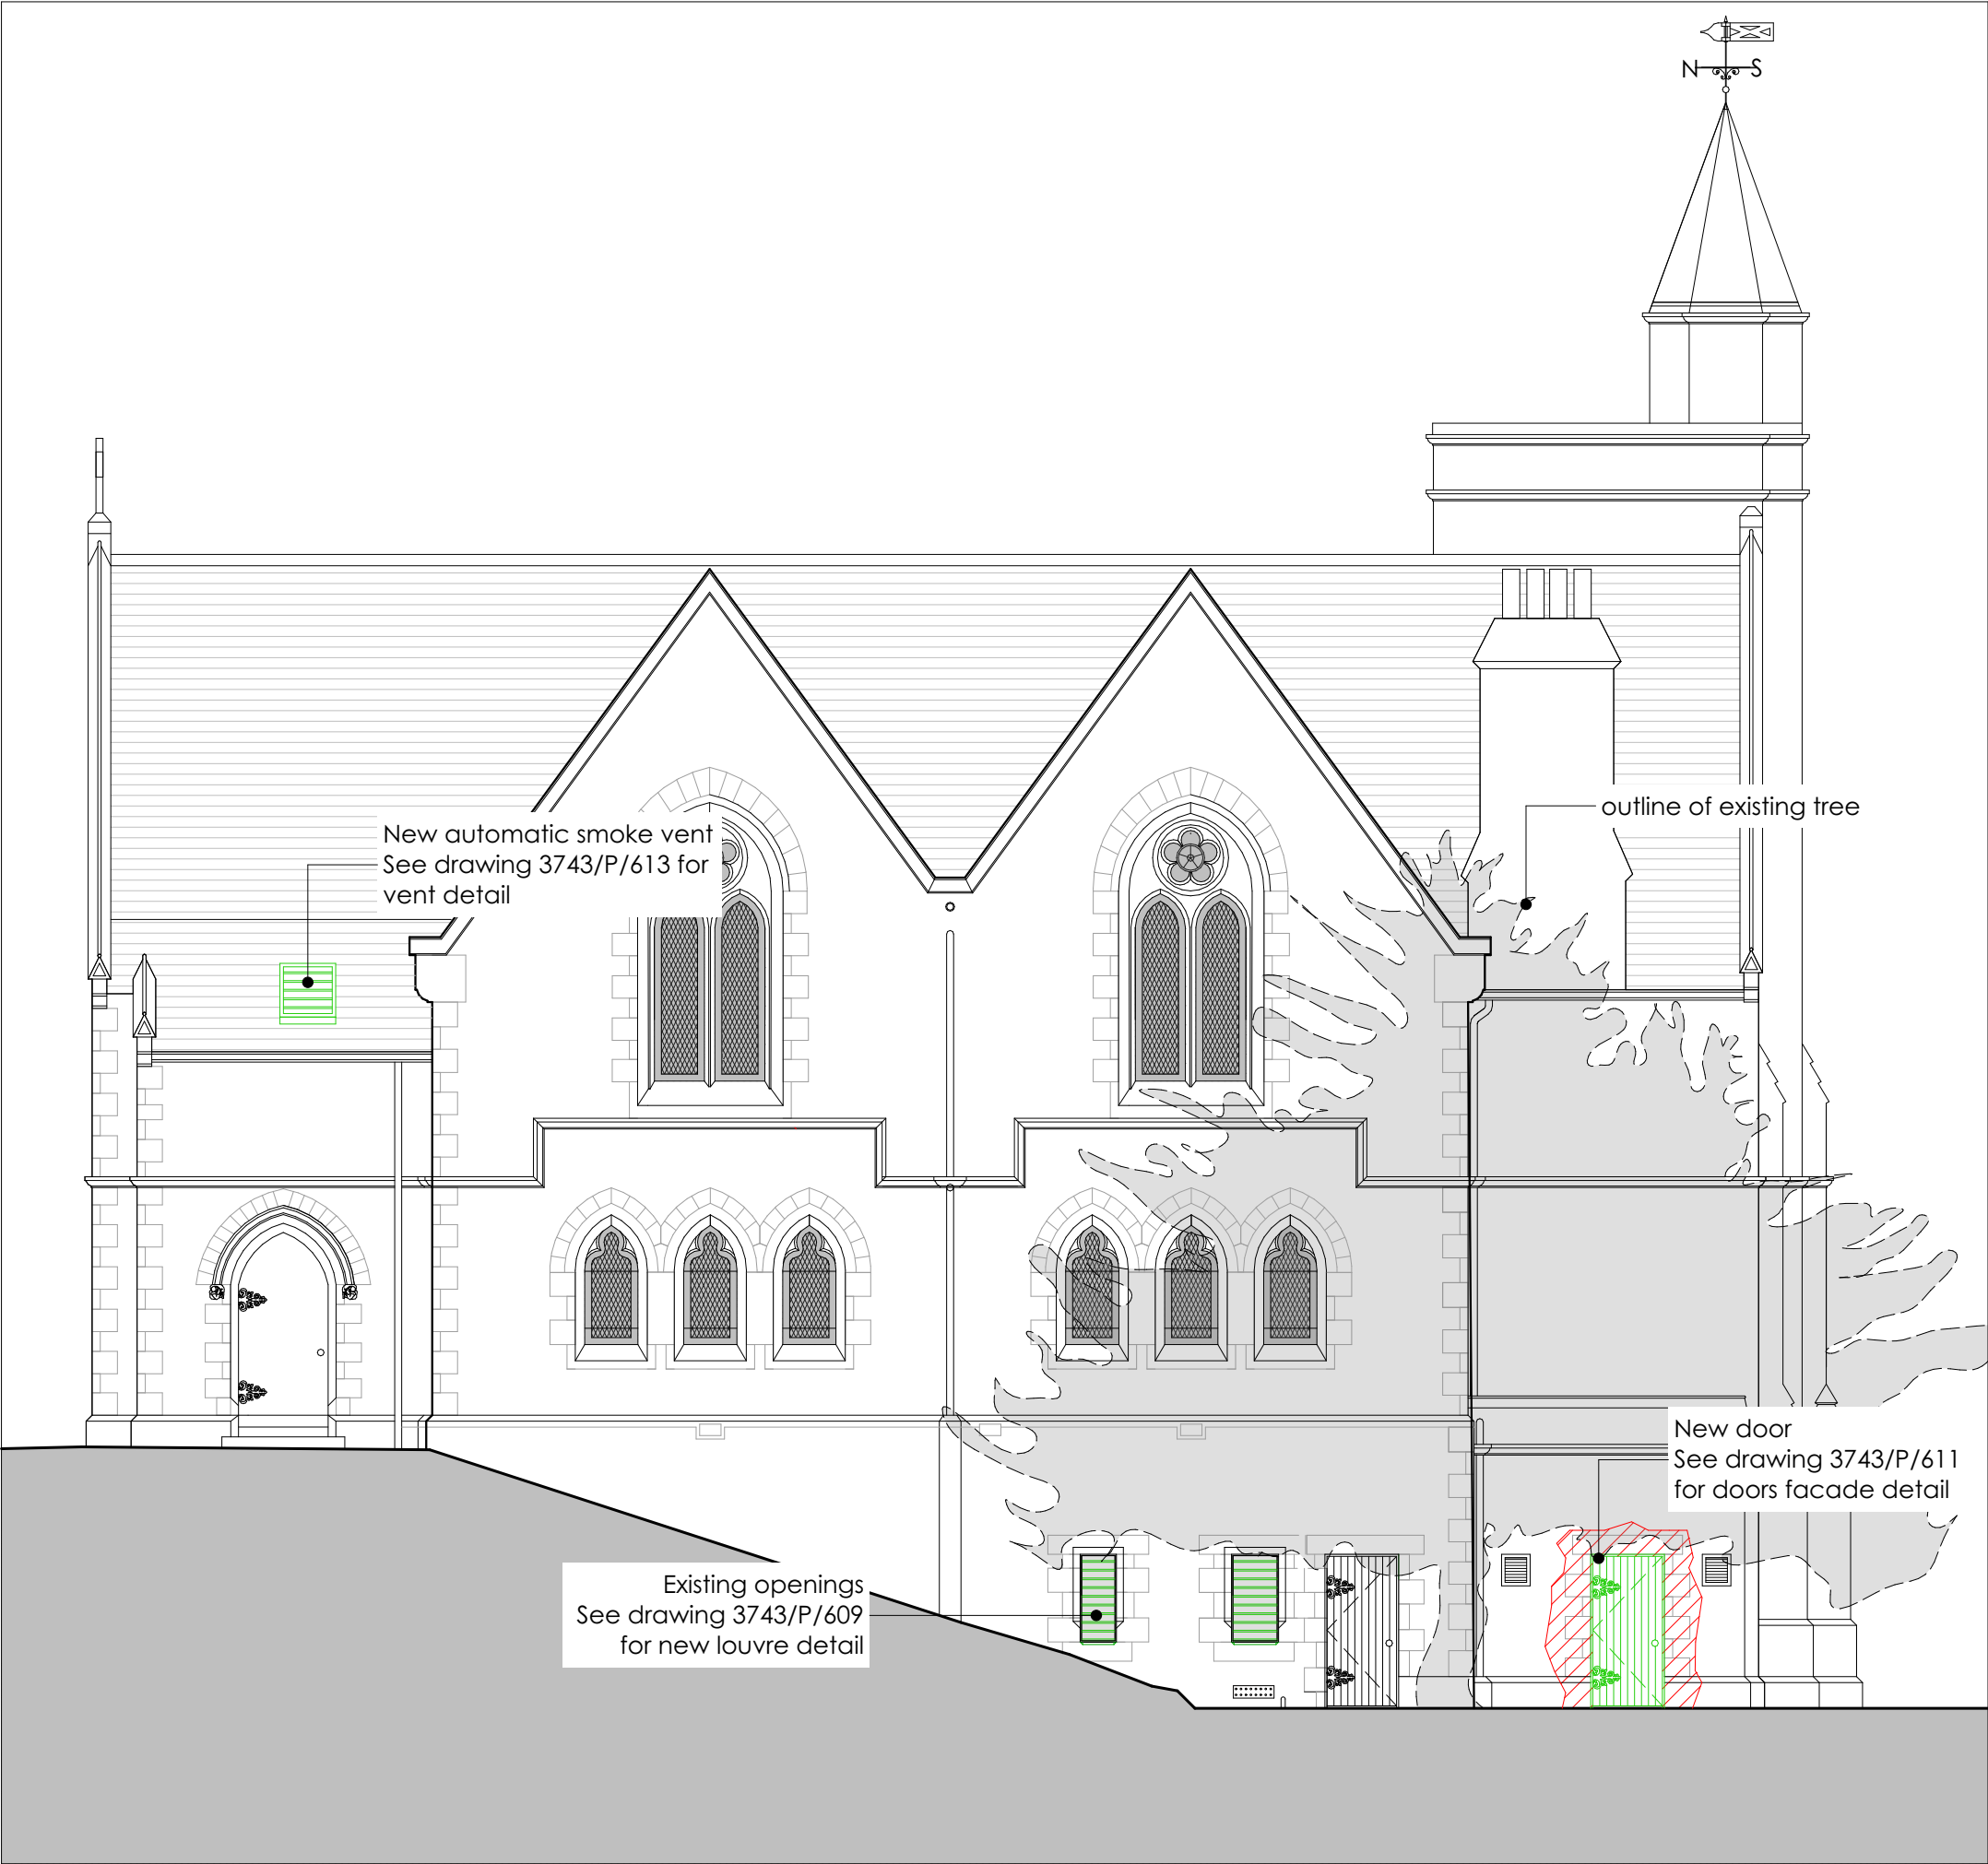

WEST ELEVATION AS PROPOSED

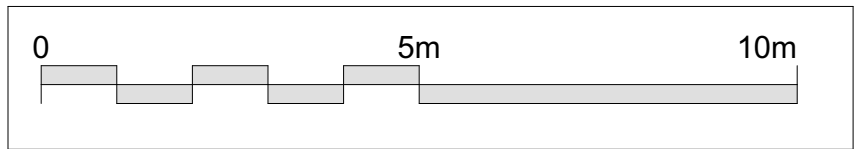

NOTE: ALL DIMENSIONS TO BE CHECKED ON SITE PRIOR TO WORK COMMENCING FOR DISCUSSION ONLY AT THIS TIME

PLANNING APPLICATION

REV A 17/03/2025 RJ Drawing updated to A1 to show North elevations	A1
REVISIONS	
Do not scale. All dimensions to be checked on site prior to commencement of work.	
Jewitt and Wilkie architects	
38 New City Road Glasgow - G4 9JT 0141 552 6929 info@jwarchitects.co.uk www.jwarchitects.co.uk	
JOB TITLE	Former Allan Park South Church, Stirling for Hot World Cuisine Ltd.
DRAWING TITLE	Existing and Proposed North and West Elevations A1
SCALE: 1:100	DATE:
DRAWN BY:	CHECKED BY:
DRAWING NO:	REV:
3743/P/500/A	