


LEVEL 1 - FURNITURE LAYOUT PLAN

FB FLOOR BOX
INDICATIVE SIZE ONLY.
ALL SETTING OUT TO BE FROM CENTERS

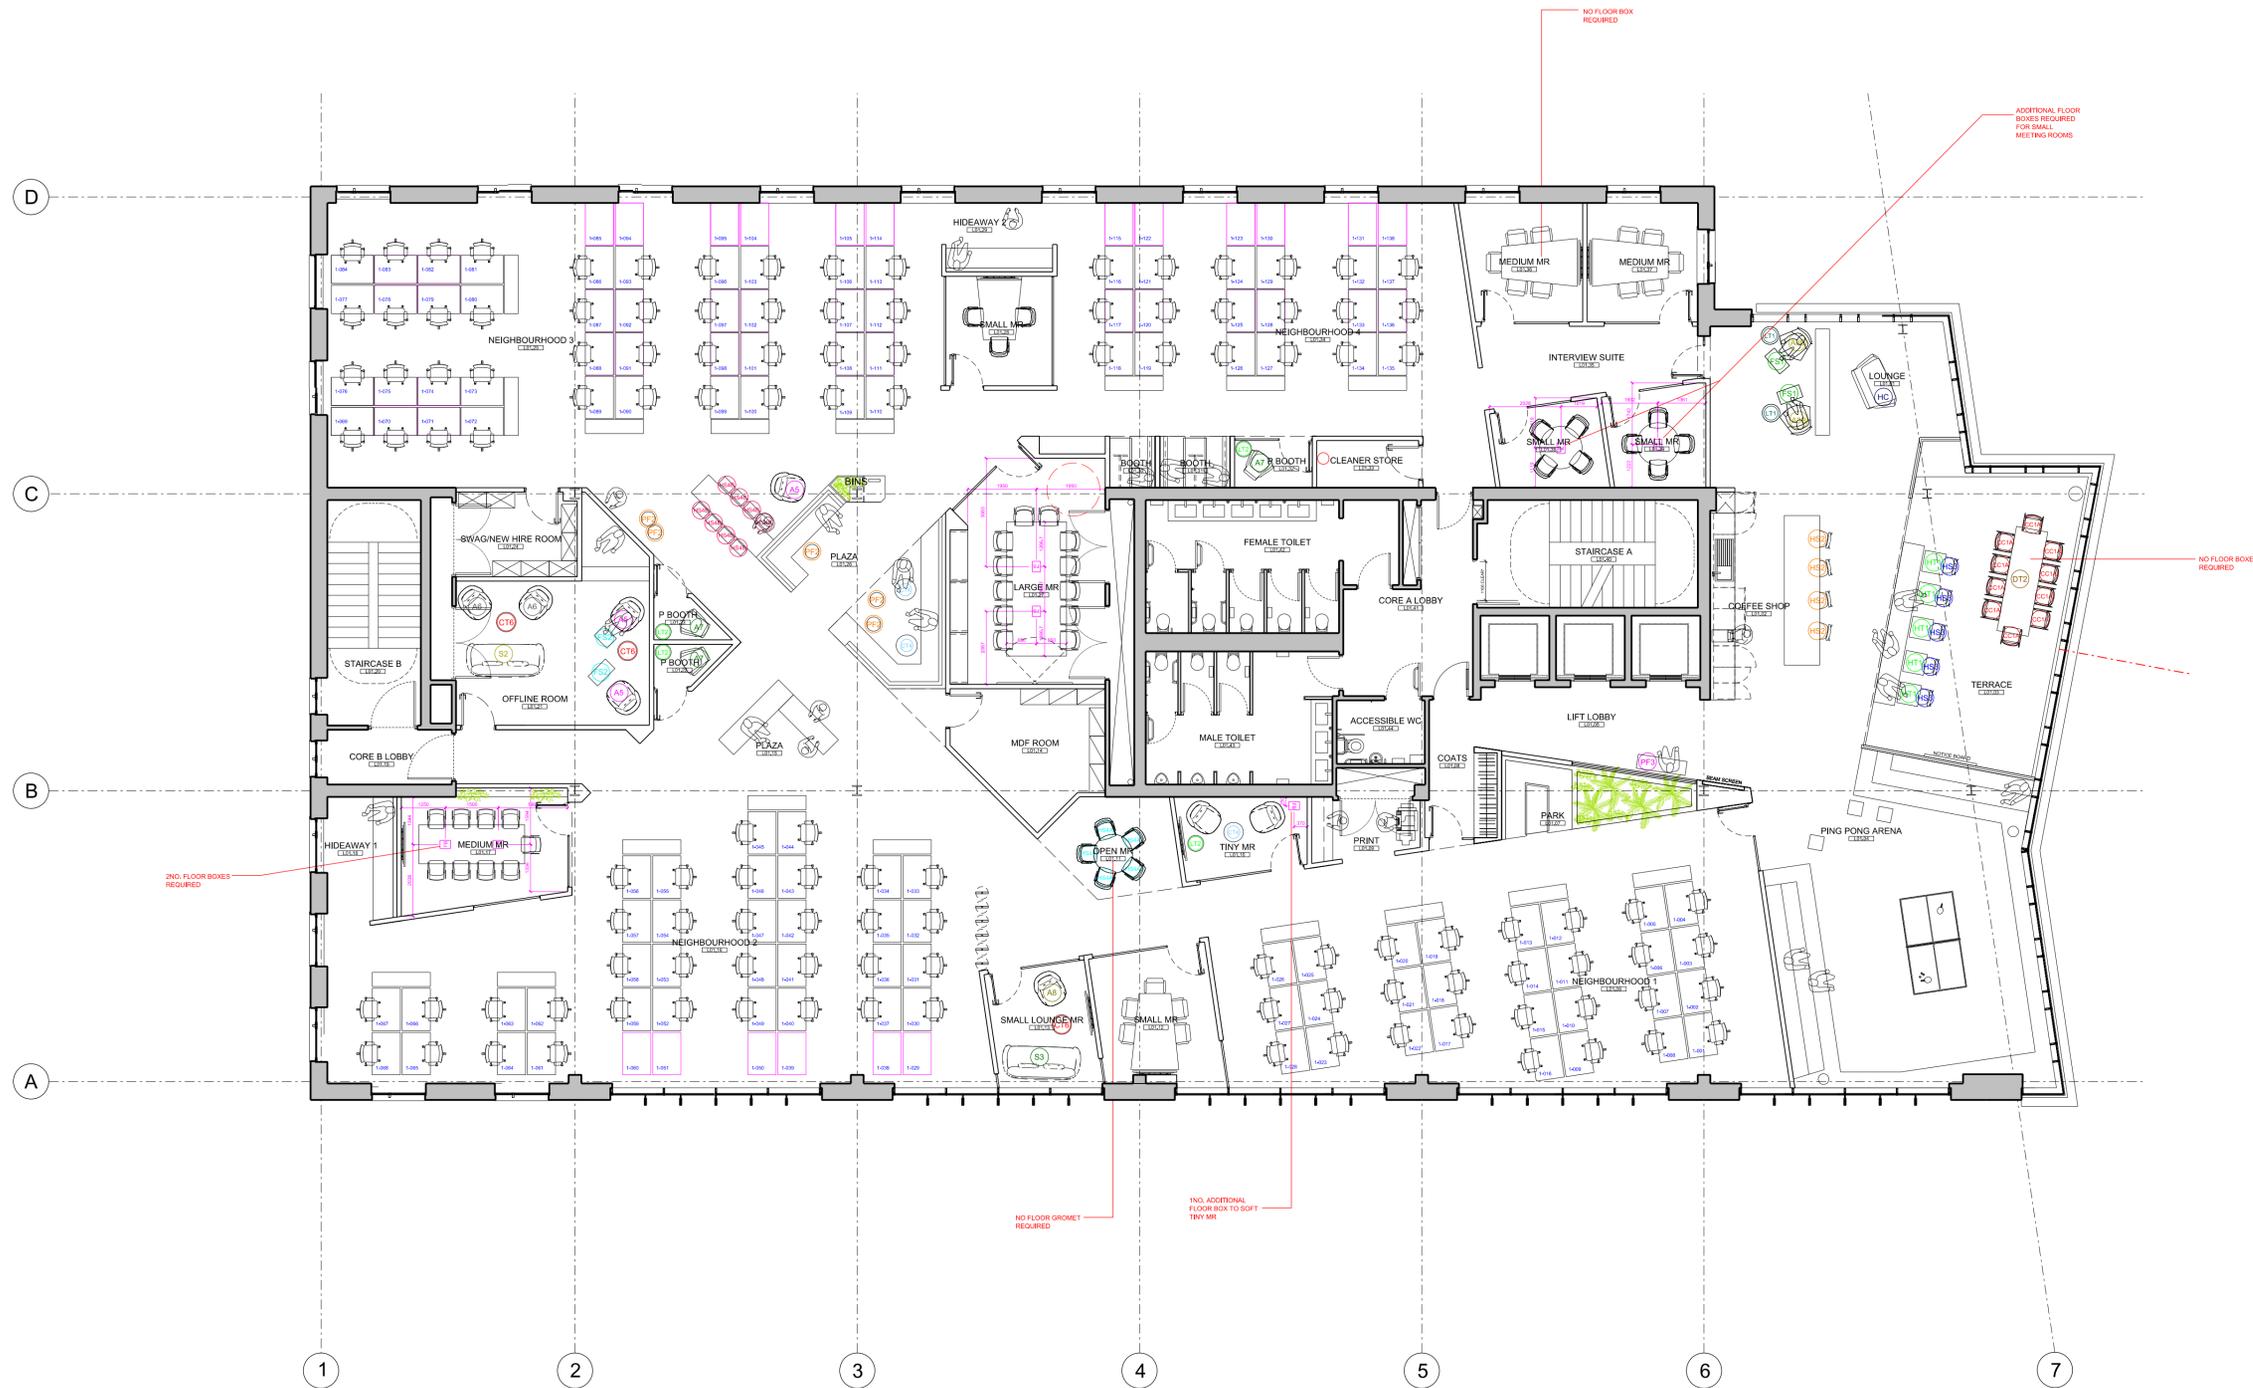

NOTES


Key Plan:

Revision	Date	Description	By
04	11.04.18	DESK NUMBERING ADDED	MOLA
03	23.03.18	FLOOR BOX SETTING OUT	MOLA
02	07.03.18	ISSUED FOR CONSTRUCTION	MOLA
01	29.01.18	MINOR ADJUSTMENTS	MOLA
00	13.11.17	ISSUED FOR CONSTRUCTION	MOLA

Drawing Status: **CONSTRUCTION**

Reply Address: 2 Donnybrook Road, Donnybrook, Dublin 04, Ireland. Telephone: +353 1 218 3900. www.mola.ie

Note: Do not scale. Use figured dimensions only. This drawing is to be read in conjunction with all relevant specifications and drawings. All dimensions to be checked on site. In the event of any discrepancies between drawings the contractor is to inform the Architect immediately.

Project Details:

Client: **Zendesk**

Project: **55C OFFICE FITOUT**

Drawn by: **First Floor Furniture Layout Plan**

Date: 2018 Scale: 1:100 @ A1 Drawn by: MOLA

Job No.: 17017	Stage: 06	Dwg No.: 3101	Rev: 04
----------------	-----------	---------------	---------

© COPYRIGHT This drawing or design may not be reproduced without permission