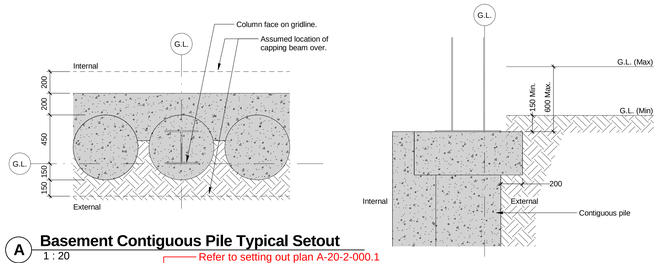

A Basement Contiguous Pile Typical Setout
1 : 20

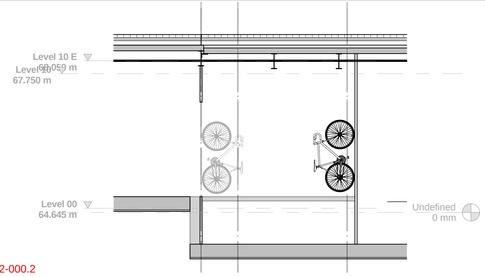

To be read in conjunction with the 'Accommodation Schedule' revision P23.

For clarification on fitted-out and shell areas refer to drawing A-04-2-500.

EV Key:

E.V.

Signage to Electronic Vehicle charging points.

Key:

—— —— By tenant.

To be read in conjunction with the Architectural Design Specification.

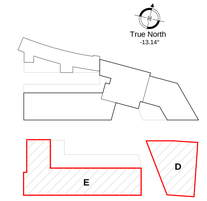

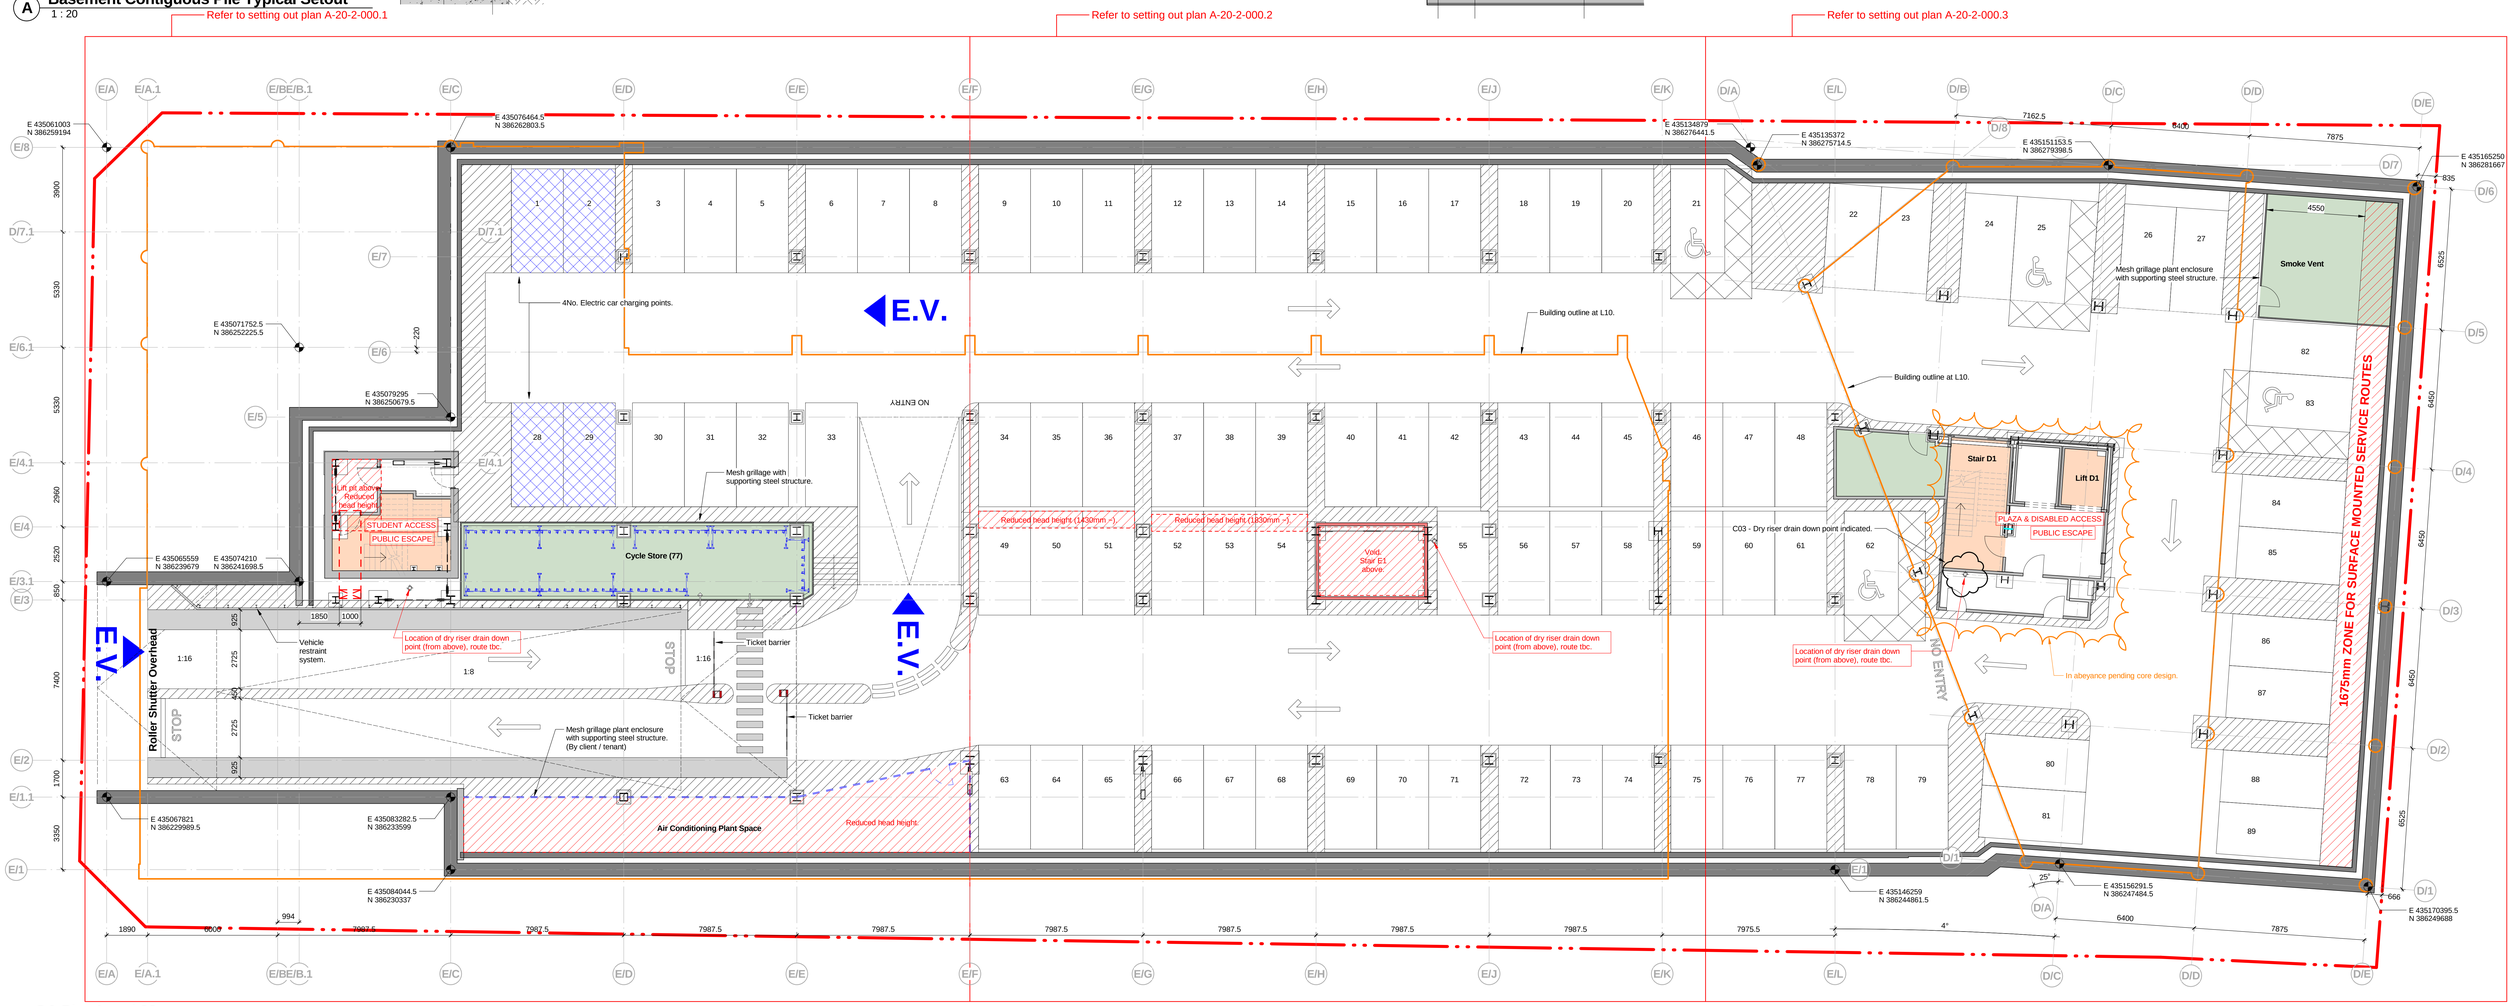

1 GA Plan Level 00
1 : 100

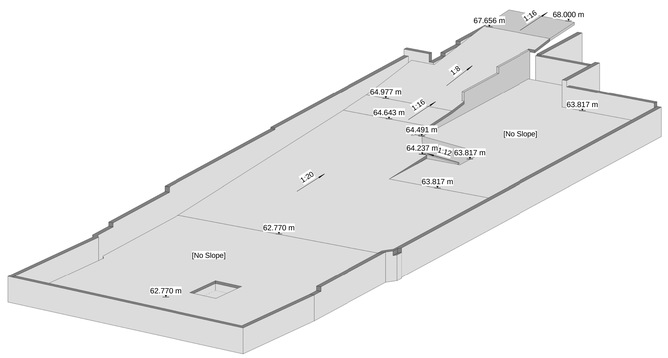

2 Basement Carpark 3D View (from North East)

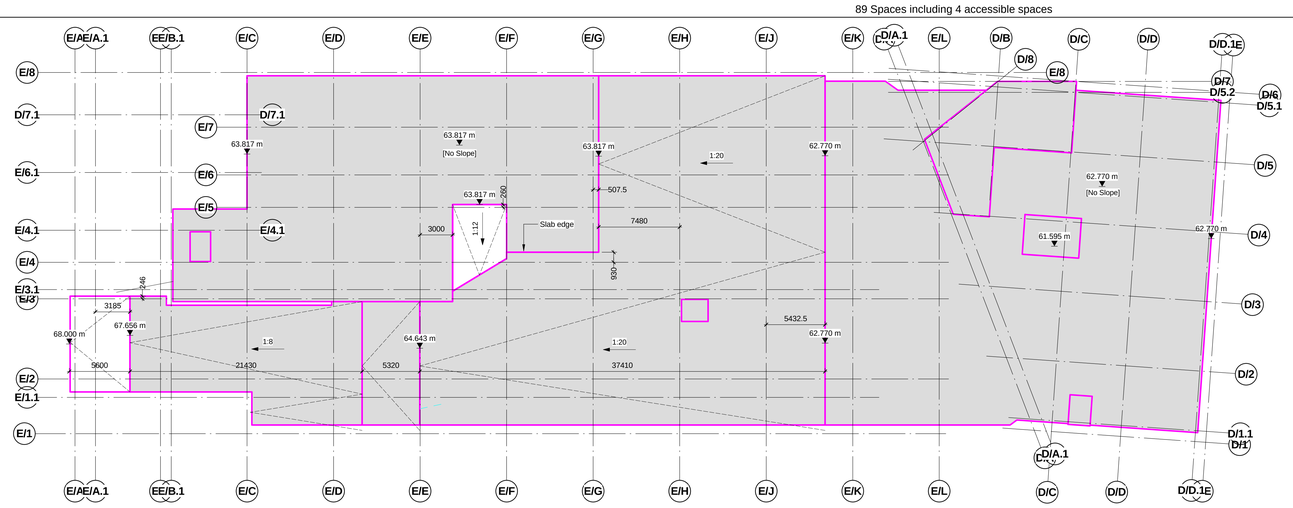

3 Basement Slab Levels (SSL)
1 : 200

89 Spaces including 4 accessible spaces

REVISION C03 BY: JB CHECKED: TL DATE: 23/08/2018
Dry risers drain down point to Block D indicated. By tenant items identified.
REVISION C02 BY: MIC CHECKED: TL DATE: 27/07/2018
Revised as noted. Dry risers to Block E stairs; drain down point indicated.
REVISION C01 BY: JB CHECKED: TL DATE: 13/07/2018
Issued for Contract. Issued for Construction.
REVISION P16 BY: JB CHECKED: TL DATE: 15/06/2018
Accommodation schedule note added. EV Signage locations added.

CONTRACT

CONSTRUCTION

PLOT DATE 23/08/2018 12:07:52

NED
New Era Development (UK) Limited

CLIENT

New Era Square, St Mary's Gate, Sheffield. Phase 2

PROJECT

GA Plan Level 00

DRAWING

DRAWN BY: ZW | SCALE: As indicated @ A0 | CREATION DATE: Nov 2016

Hadfield Cawkwell Davidson

Broomgrove Lodge, 13 Broomgrove Rd, Sheffield, S10 2LZ T 0114 266 8181 www.hcd.co.uk

Architecture | Engineering | Interior Design | Masterplanning | Urban Design

JOB NUMBER: 2013-077 | DRAWING NUMBER: A-04-2-000 | C03

C:\temp\13077-HCD-DE-ZZ-M3-A-20-001_Block DE_W17_james.bost.rvt