
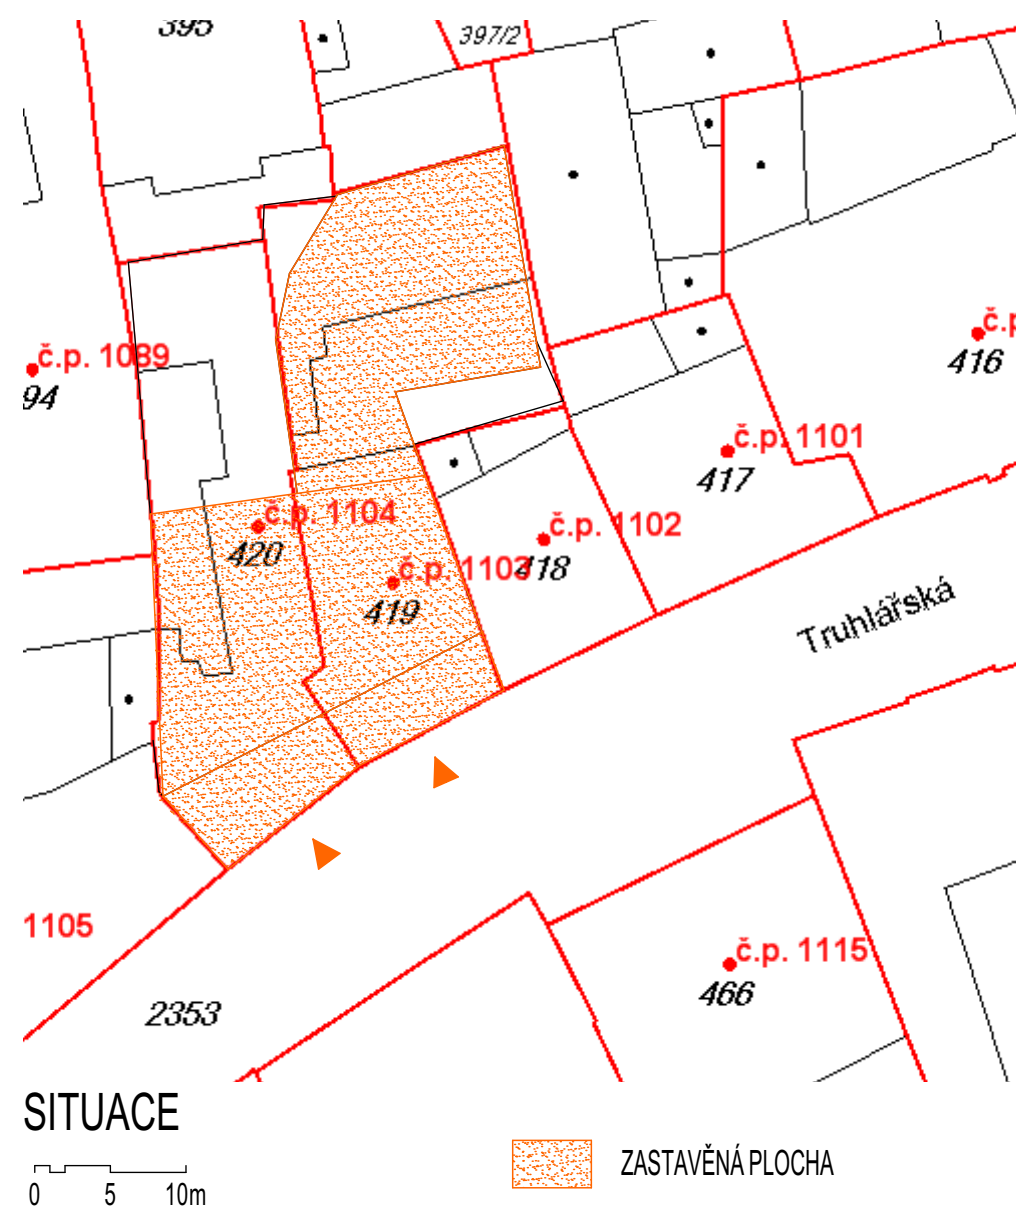


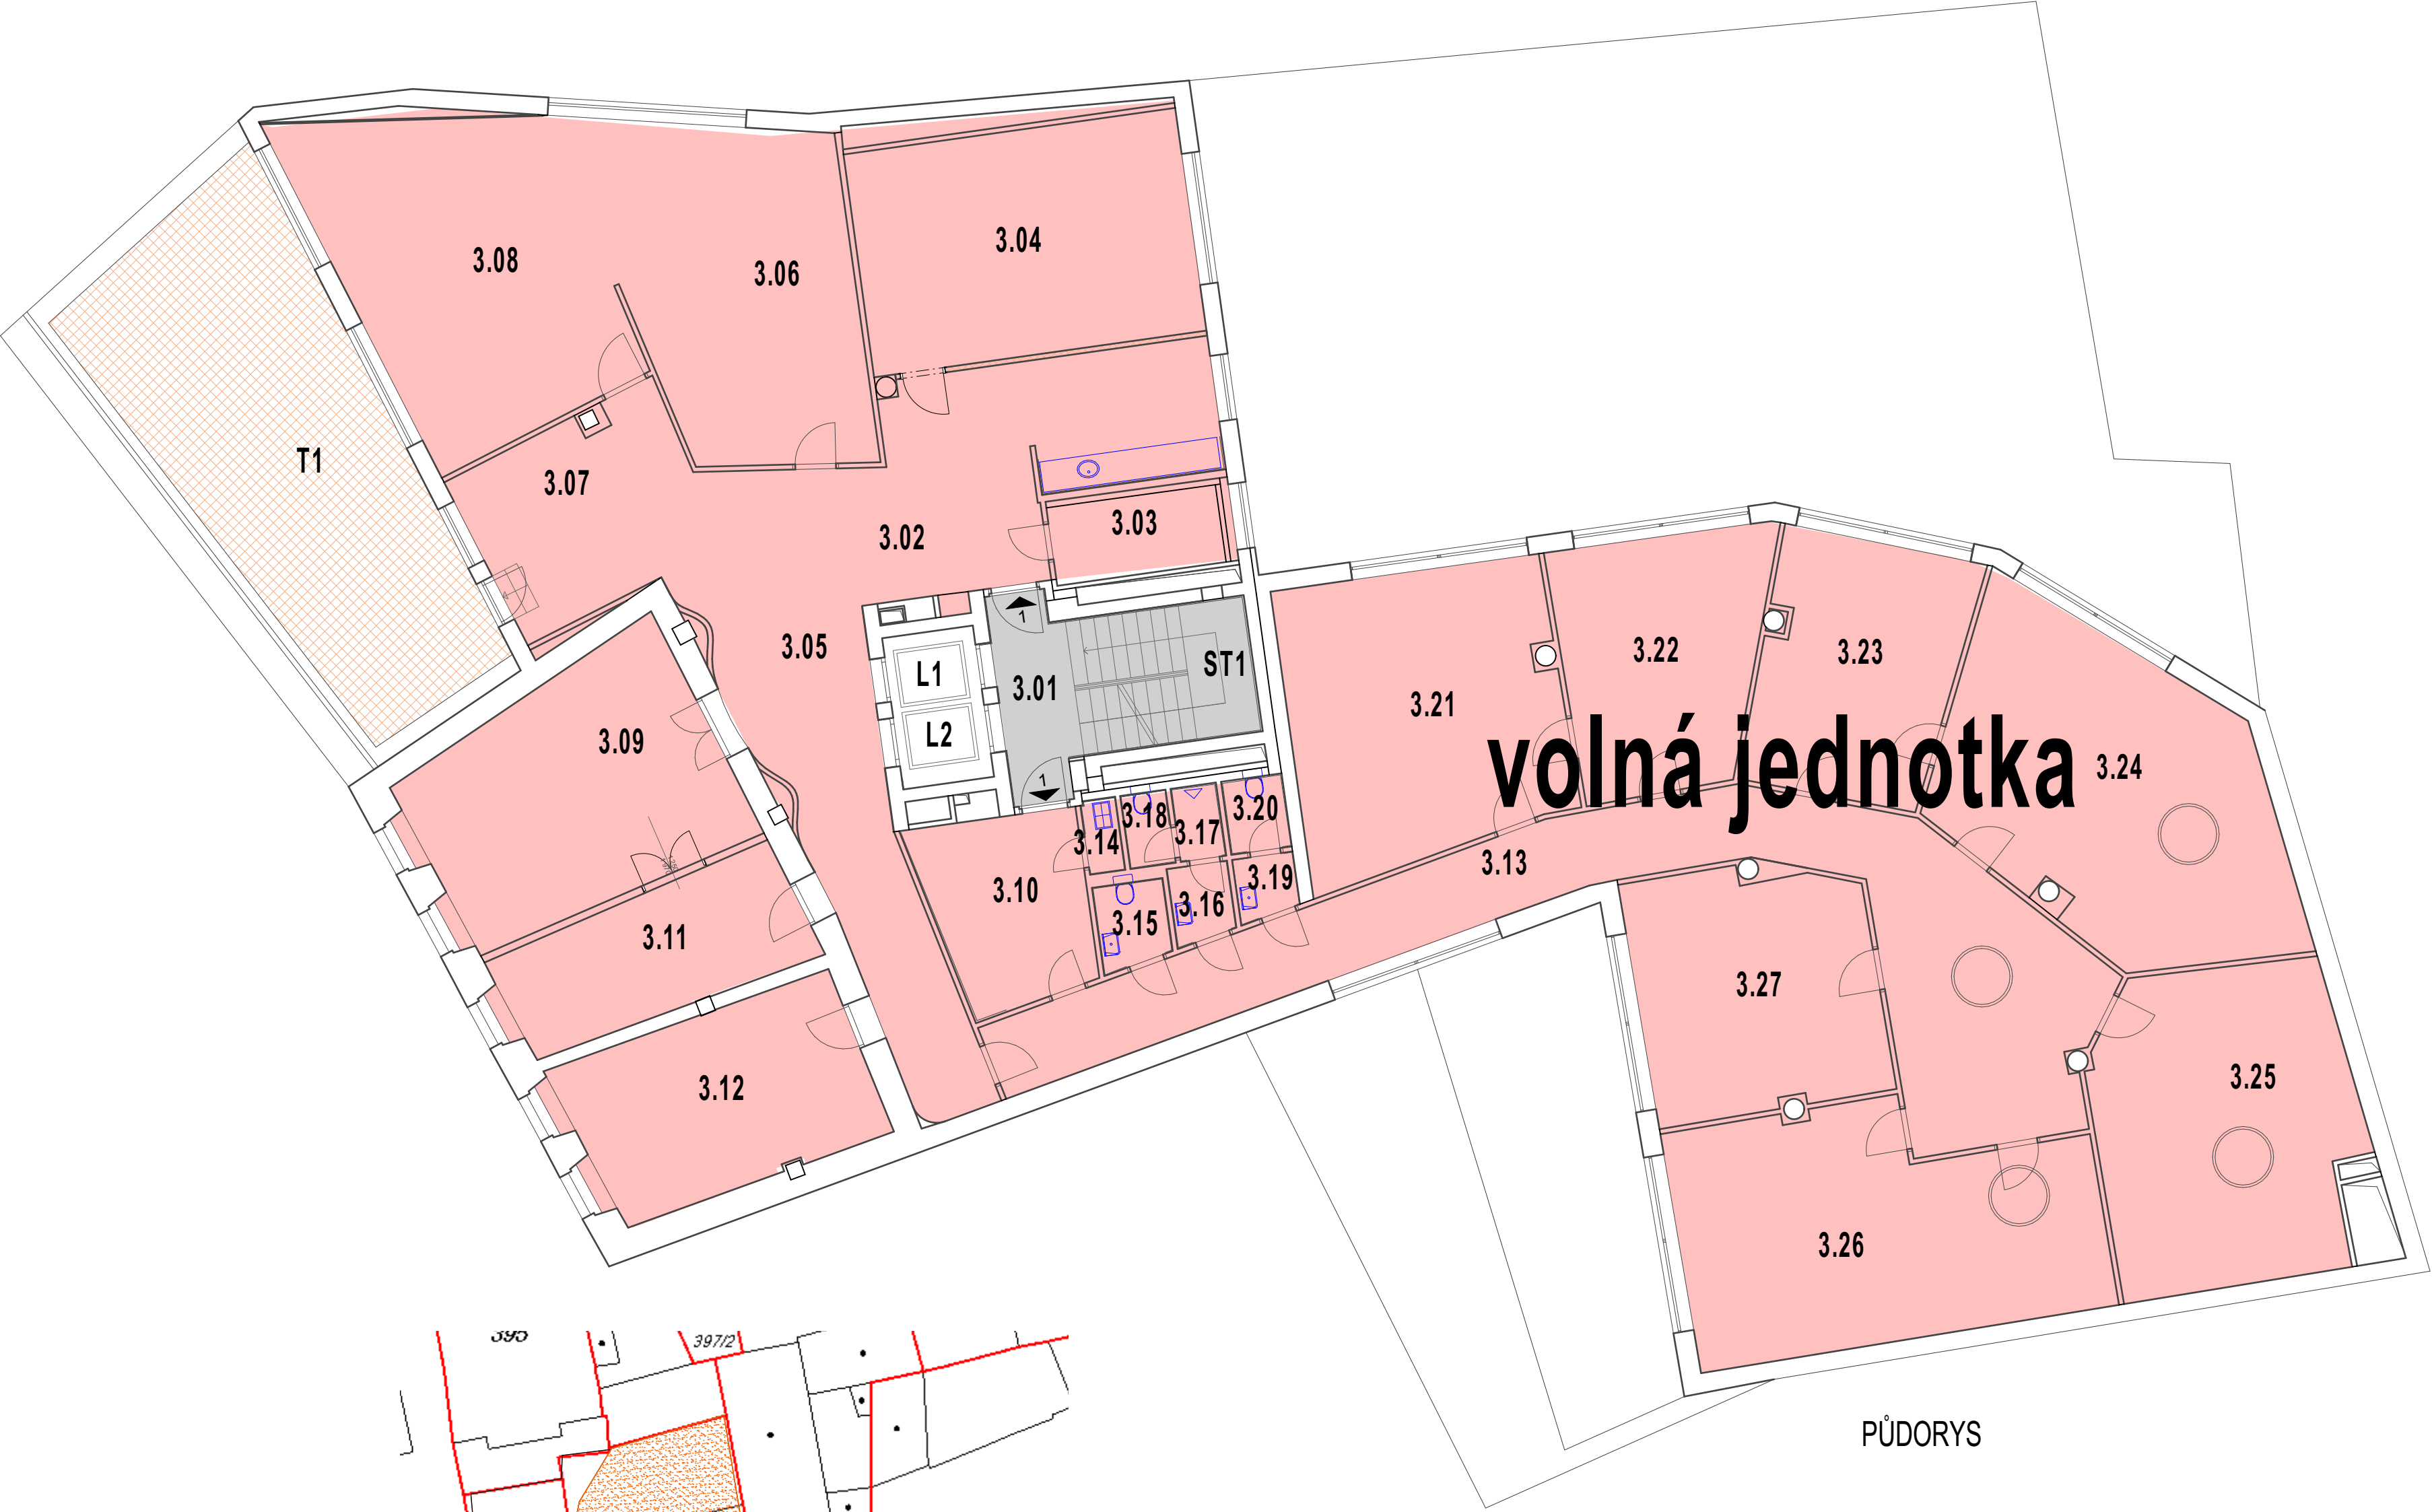

POZNÁMKA:

- Tabulka místností viz. příloha -
- Plochy místností jsou měřené jako čistá plocha včetně výklenků, ostění
- Do plochy místností je započtena polovina plochy pod lehkou příčkou
- Plocha jednotky celkem je součet ploch všech místností a ploch pod nenosnými příčkami vyznačené jednotky

ROOM LEGEND - 3NP (2nd Floor)					TRUHLÁŘSKÁ 13/1104, 15/1103			
Unit No. Type	Room No.	Purpose	Total Area	Clearance	Finishes		Comment	
			m2	m	Flooring	Walls		
1	2	3	4	6	7	8	9	
Commercial Unit	3.02	HALL	25.90	2.48	Carpet	Plaster		
	3.03	STORAGE	5.23	2.63	Ceramic Tiles	Plaster		
	3.04	OFFICE	31.79	2.63	Carpet	Plaster		
	3.05	HALL	31.95	2.48	Carpet	Plaster		
	3.06	OFFICE	31.64	2.63	Carpet	Plaster		
	3.07	HALL	15.20	2.63	Carpet	Plaster		
	3.08	OFFICE	33.43	2.63	Carpet	Plaster		
	3.09	OFFICE	27.51	2.63	Carpet	Plaster		
	3.10	KITCHEN	11.89	2.63	Carpet/Ceramic tiles	Plaster		
	3.11	OFFICE	14.94	2.63	Carpet	Plaster		
	3.12	OFFICE	20.48	2.63	Carpet	Plaster		
	3.13	CORRIDOR	50.51	2.50	Carpet	Plaster		
	3.14	CLEANING R.	1.32	2.50	Ceramic tiles	Ceramic Tiles		
	3.15	TOILET	2.77	2.50	Ceramic tiles	Ceramic Tiles		
	3.16	TOILET	2.03	2.50	Ceramic tiles	Ceramic Tiles		
	3.17	WC	1.66	2.50	Ceramic tiles	Ceramic Tiles		
	3.18	WC	1.66	2.50	Ceramic tiles	Ceramic Tiles		
	3.19	TOILET	1.60	2.50	Ceramic tiles	Ceramic Tiles		
	3.20	WC	2.04	2.50	Ceramic Tiles	Ceramic Tiles		
	3.21	OFFICE	30.23	2.50	Koberec	Plaster		
	3.22	OFFICE	19.60	2.50	Koberec	Plaster		
	3.23	OFFICE	19.87	2.50	Koberec	Plaster		
	3.24	OFFICE	37.69	2.50	Koberec	Plaster		
	3.25	TECHNOLOGY	30.32	2.50	Carpet/floating floor	Plaster		
	3.26	OFFICE	35.40	2.50	Carpet	Plaster		
	3.27	OFFICE	22.70	2.50	Carpet	Plaster		
T1	TERRACE	46.08	-	Ceramic Tiles	Plaster			
Common areas	3.01	HALL	6.34	2.34	Stone Pavement	Stone Cladd./Plaster		
	ST1	STAIR	10.00	2.50	Temazzo	Stone Cladd./Plaster		
	L1/L2	LIFT						

AREA SUMMARY		
UNIT No.	Unit Total Area	Comment
	m2	
Commercial Unit No. 1	509,36	
Terraces/Courts of C.U. No.1	46,08	
Common areas and facilities	16,34	

Zpracovatel:

Přemysl Boehm, IČ: 86804758, Přítkovská 1609/6, Teplice
tel.:420/725751999
email:premek@boehm-architecture.cz
Kancelář: Litevská 8, 100 00 Praha 10

BOEHM

ARCHITECTURE

Aktualizace výkresu:

Knight Frank

Objednatel:

SOLITAIRE
REAL ESTATE a.s.

Název akce:

DIGITÁLNÍ PASPORTIZACE OBJEKTU
TRUHLÁŘSKÁ 13, 15, PRAHA 1

Paré:

Číslo akce:

2012-06-B

Stupeň:

Zjednodušená dokumentace - PASPORT STAVBY

Datum:

11/2022

Obsah:

PŮDORYS 3NP (2.PATRO)
PŘEHLED NÁJEMNÍCH JEDNOTEK

Číslo výkresu:

PR-04

Index:

B

Datum indexu:

11/2022