
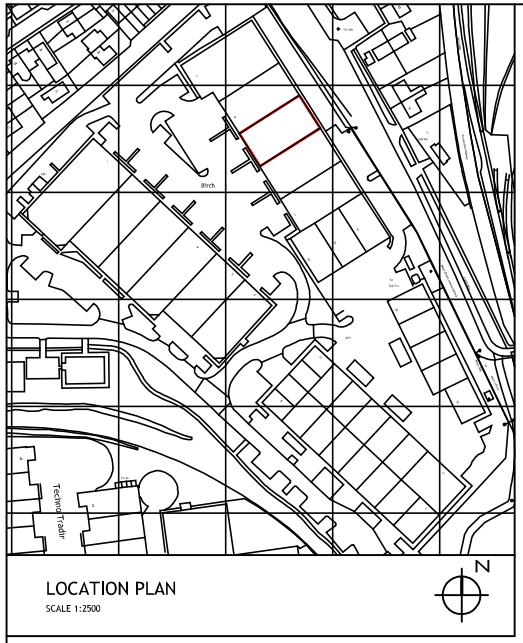


LOCATION PLAN

SCALE 1:2500

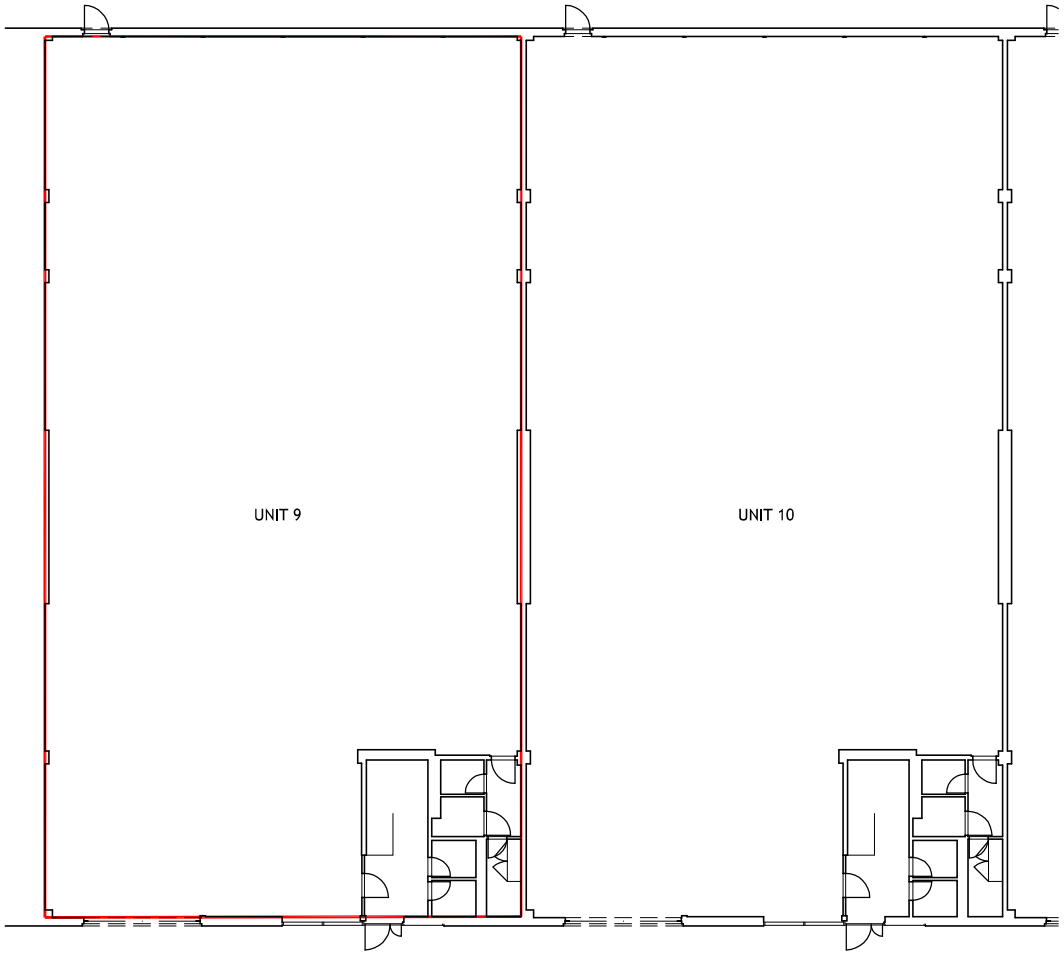

UNIT 9 - GROSS INTERNAL AREA

GROUND FLOOR 586.48 sq m 6313 sq ft

NORTH

SCALE IN METRES

0 5 10

Rev.	Date	By	Amendment

LEGEND

ABBREVIATIONS

B	BOLLARD	MH	MANHOLE
BDE	BRICK ON EDGE	O/H	OVER HEAD
BDG	BOARDING	P	POST
BT	BRITISH TELECOM	P/L	PAVEMENT LIGHT
B/W	BRICK WALL	RAD	RADIATOR
CATV	CABLE TELEVISION	RE	ROODING EYE
C/F	CEILING FALL	RS	ROAD SIGN
CL	COVER LEVEL	RSJ	ROLLED STEEL JOIST
CONC	CONCRETE FINISH	RSS	ROLLED STEEL STANCHION
COU	COVER ORIGIN UNKNOWN	RWP	RAIN WATER PIPE
C/PD	CUPBOARD	SC	STOP COCK
DK	DROP KERB	SP	SIGN POST
DL	DERIVED LEVEL	SVP	SOIL VENT PIPE
ELEC.	ELECTRICAL	TL	TRAFFIC LIGHT
ER	EARTHING ROD	TN	TREE NUMBER
F/B	FLOWER BED	TP	TELEPHONE POLE
FAR	FLAT ASPHALT ROOF	UTL	UNABLE TO LIFT
G	GULLY	VP	VENT PIPE
GV	GAS VALVE	VTF	VINYL TILED FLOOR
HLW	HIGH LEVEL WINDOW	WC	WATER CLOSET
IC	INSPECTION COVER	WHB	WASH HAND BASIN
L/L	LOW LEVEL	WV	WATER VALVE
LP	LAMP POST	Ø	DIAMETER

OVERHEAD DETAIL

BARRIER OR FENCE

CHANGE IN SURFACE

GATE

SURVEY STATION

HEIGHTS

C	HEIGHT FROM FLOOR TO CILL
H	HEIGHT FROM CILL TO HEAD
SP	HEIGHT FROM FLOOR TO SPRING OF ARCH
AH	HEIGHT FROM FLOOR TO HEAD OF ARCH
(2200)	HEIGHT TO CEILING, BEAM OR DOOR
S/C	STRUCTURAL CEILING HEIGHT
F/C	FALSE CEILING HEIGHT
DL	DEDUCED LEVEL DERIVED FROM PLUS MEASUREMENTS
TREES	Ø DIAMETER(mm)
	S SPREAD(mm) diameter
	H HEIGHT(mm)
	ALL TREE HEIGHTS SHOWN IN (mm)

3sixty measurement
Regulated by RICS

LONDON
SOUTH BANK HOUSE,
BLACK PRINCE ROAD
LONDON SE1 7SJ
Tel: 020 7637 2600
Fax: 020 7637 2651
E-mail: info@3sixtymeasurement.co.uk
Website:www.3sixtymeasurement.co.uk

RICS

Client	PETCHEY INDUSTRIAL HOLDINGS LTD
Project	ASH & BIRCH IND. EST. SWINDON SN2 8YZ
Drawing	BIRCH UNIT 9, GROUND FLOOR

Date	Scale	Drawn by	Checked by
NOV 2016	A3@1:200	RJT	GFT

Project No	Drawing No	Revision
16419	-02	