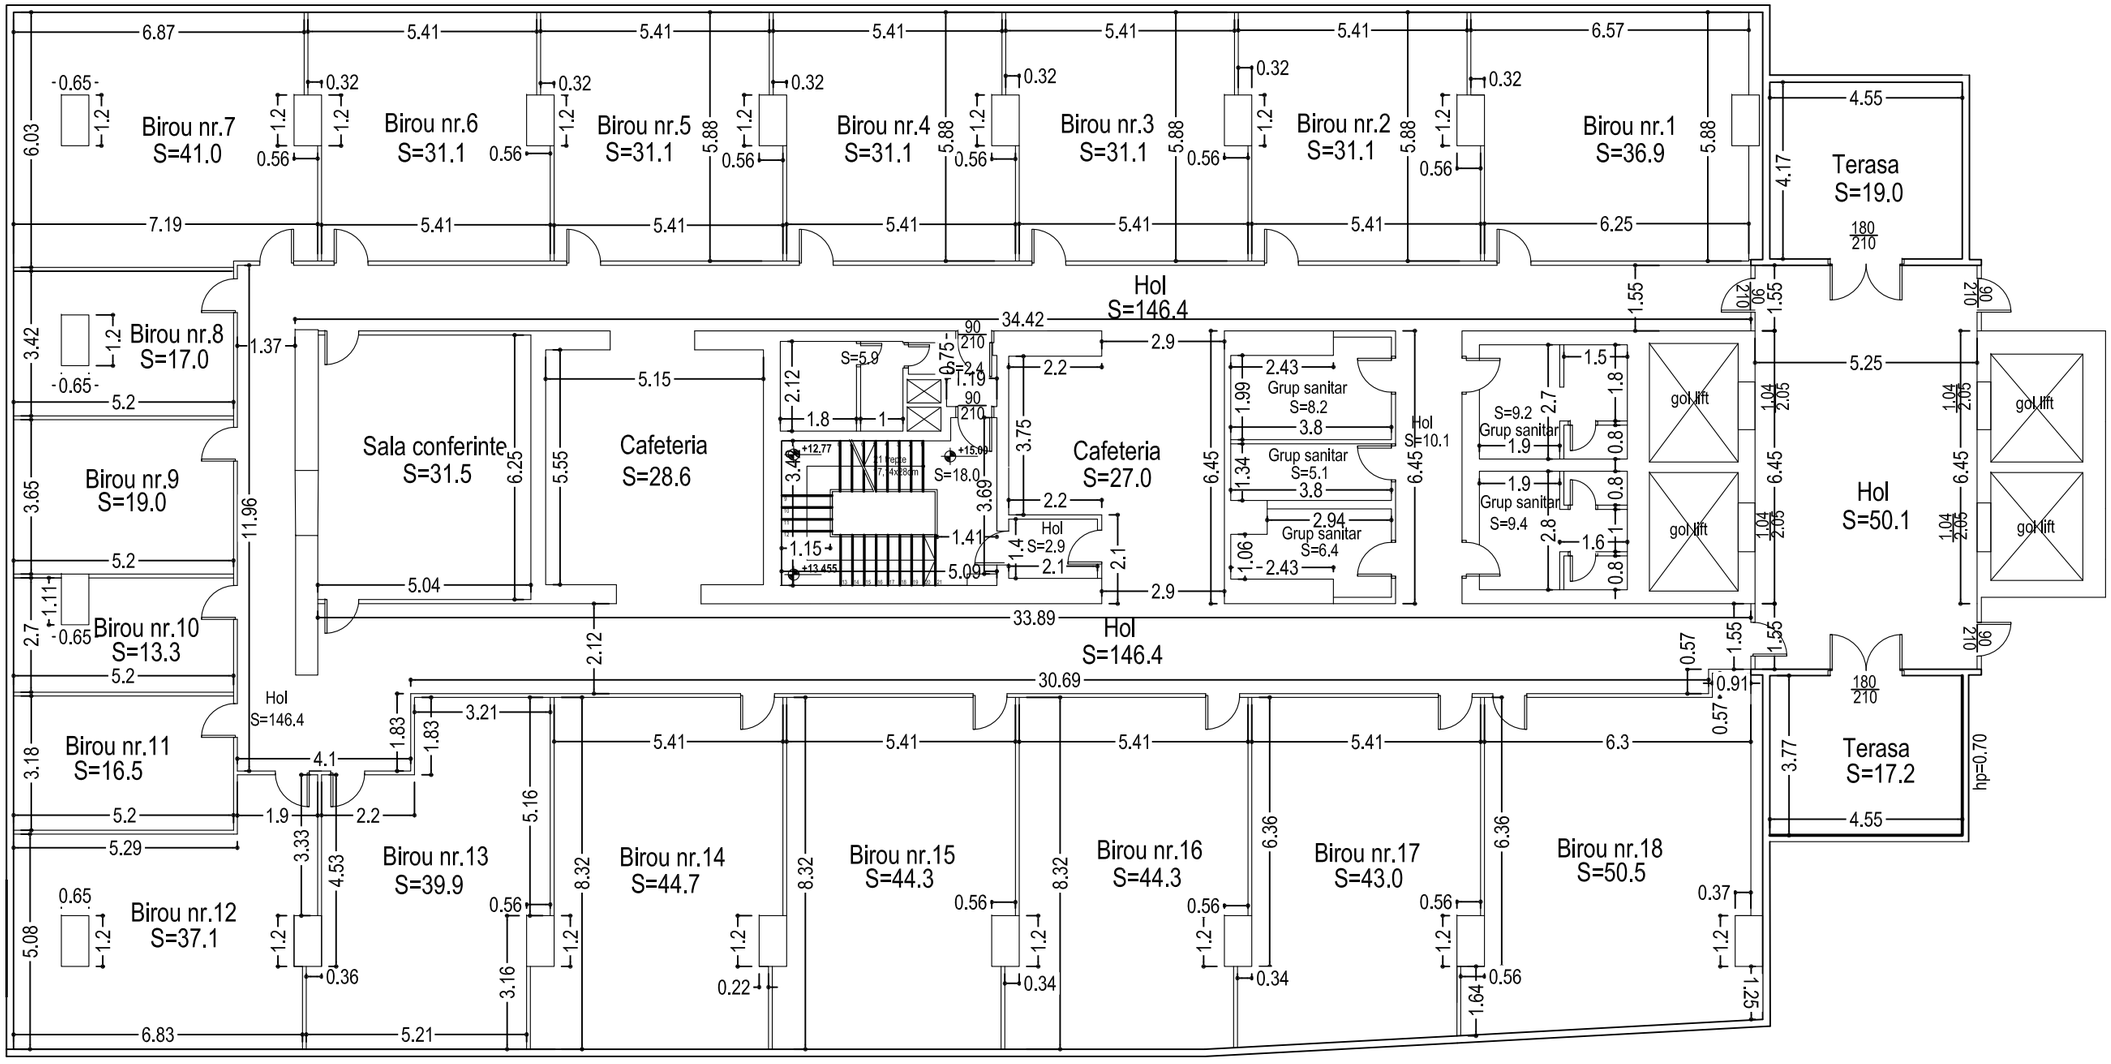

Land Survey Consulting
Reg. Com.: J40/7544/2002 CUI: RO 14815160
IBAN: RO79 INGB 0000 9999 0167 1769
ING Lacul Tei
Bucuresti, sector 2, Str. Judetului, nr.15, bl.17, ap.149
www.lsc.ro office@lsc.ro tel/fax(+40) 021 2422306

PLANSA 6			
COMANDA 101			
PROIECTAT	Ing. Doru Sarchis	SCARA 1:150	Releveu propunere compartimentare Etaj 4
DESENAT	Ing. Doru Sarchis		Str. Dudesti-Pantelimon nr.42 sector 2 Bucuresti
VERIFICAT	Ing. Doru Sarchis		
SEF COLECTIV	Ing. Doru Sarchis	DATA Februarie 2024	Beneficiar: RAMS BUSINESS PARK
APROBAT	Ing. Doru Sarchis		

Persoana fizică autorizată de ANCPI să execute lucrări de cadastru, geodezie și cartografie
CERTIFICAT DE AUTORIZARE
SERIA RO-B-F, NR.0357 / 18.10.2010
SARCHIS DORU ALEXANDRU
CATEGORIA A

Persoană Juridică Autorizată de ANCPI să execute lucrări de cadastru, geodezie și cartografie
CERTIFICAT DE AUTORIZARE
Seria RO-B-J
Nr. 2714
LAND SURVEY CONSULTING S.R.L.
CLASA III