




A - A

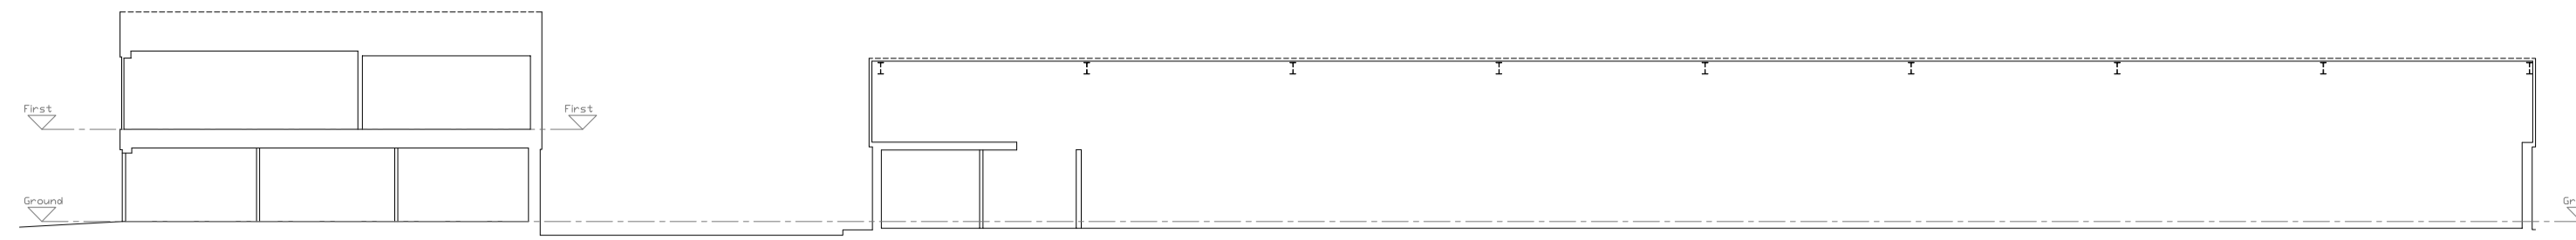


B - B

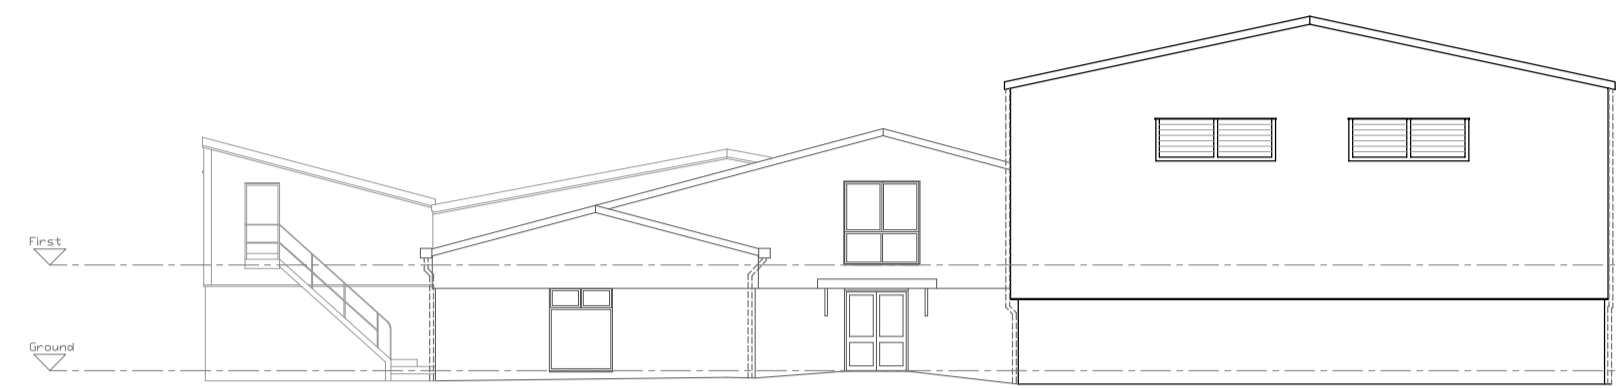


South Elevation

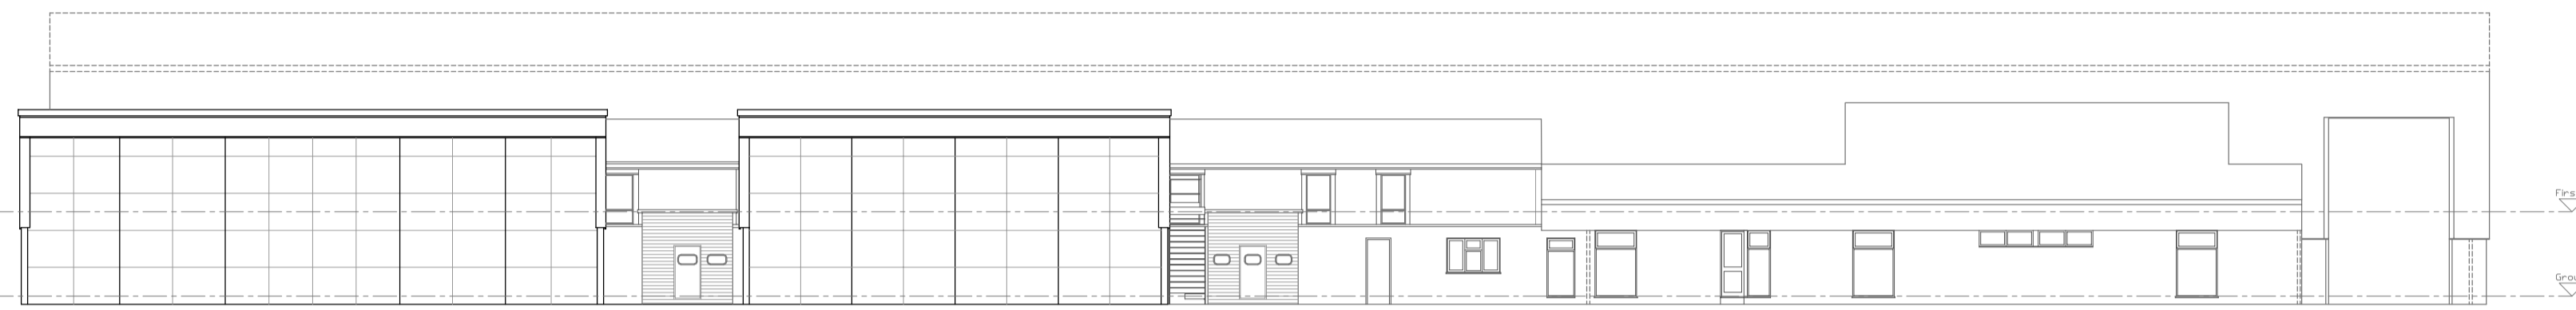


West Elevation

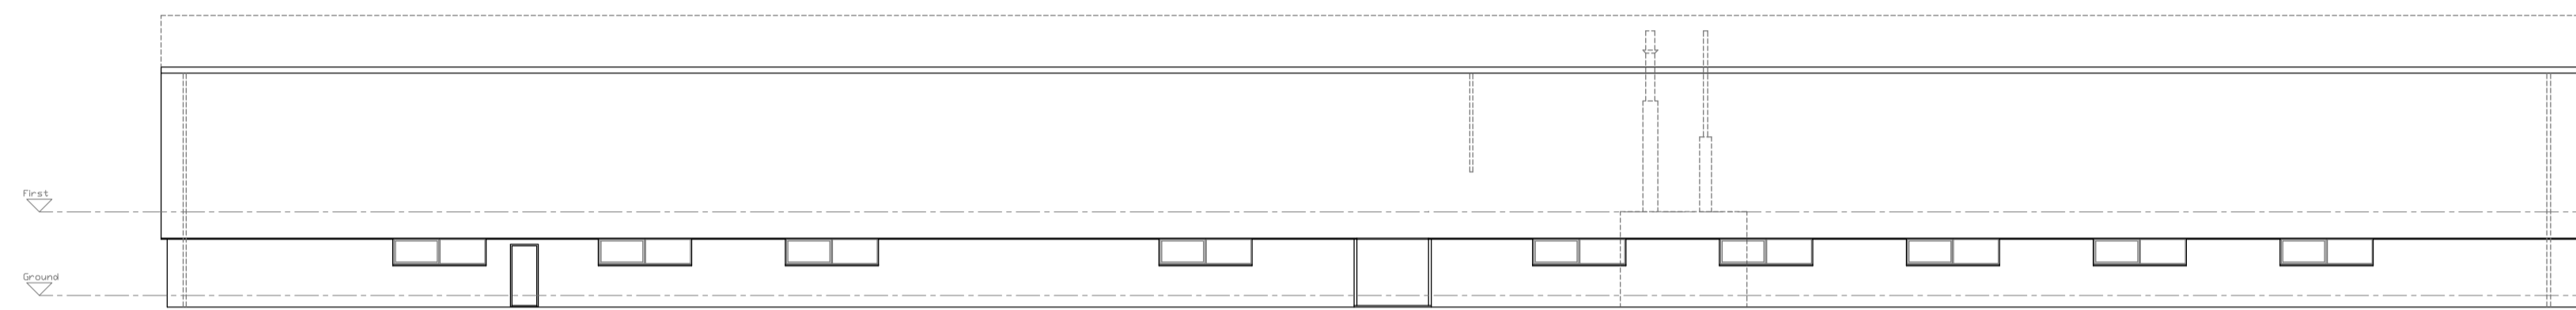


East Elevation

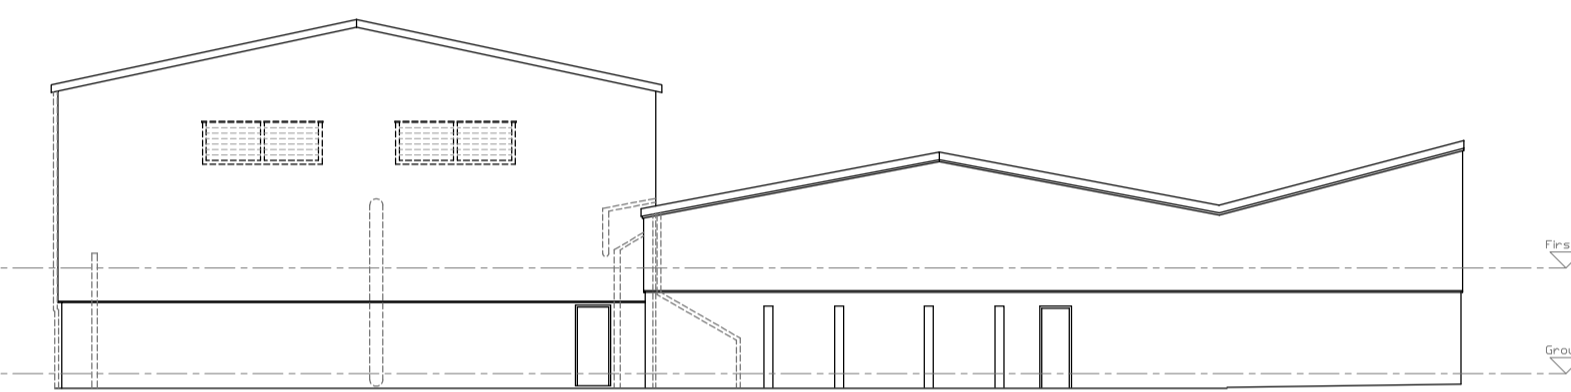


North Elevation
(limited access)

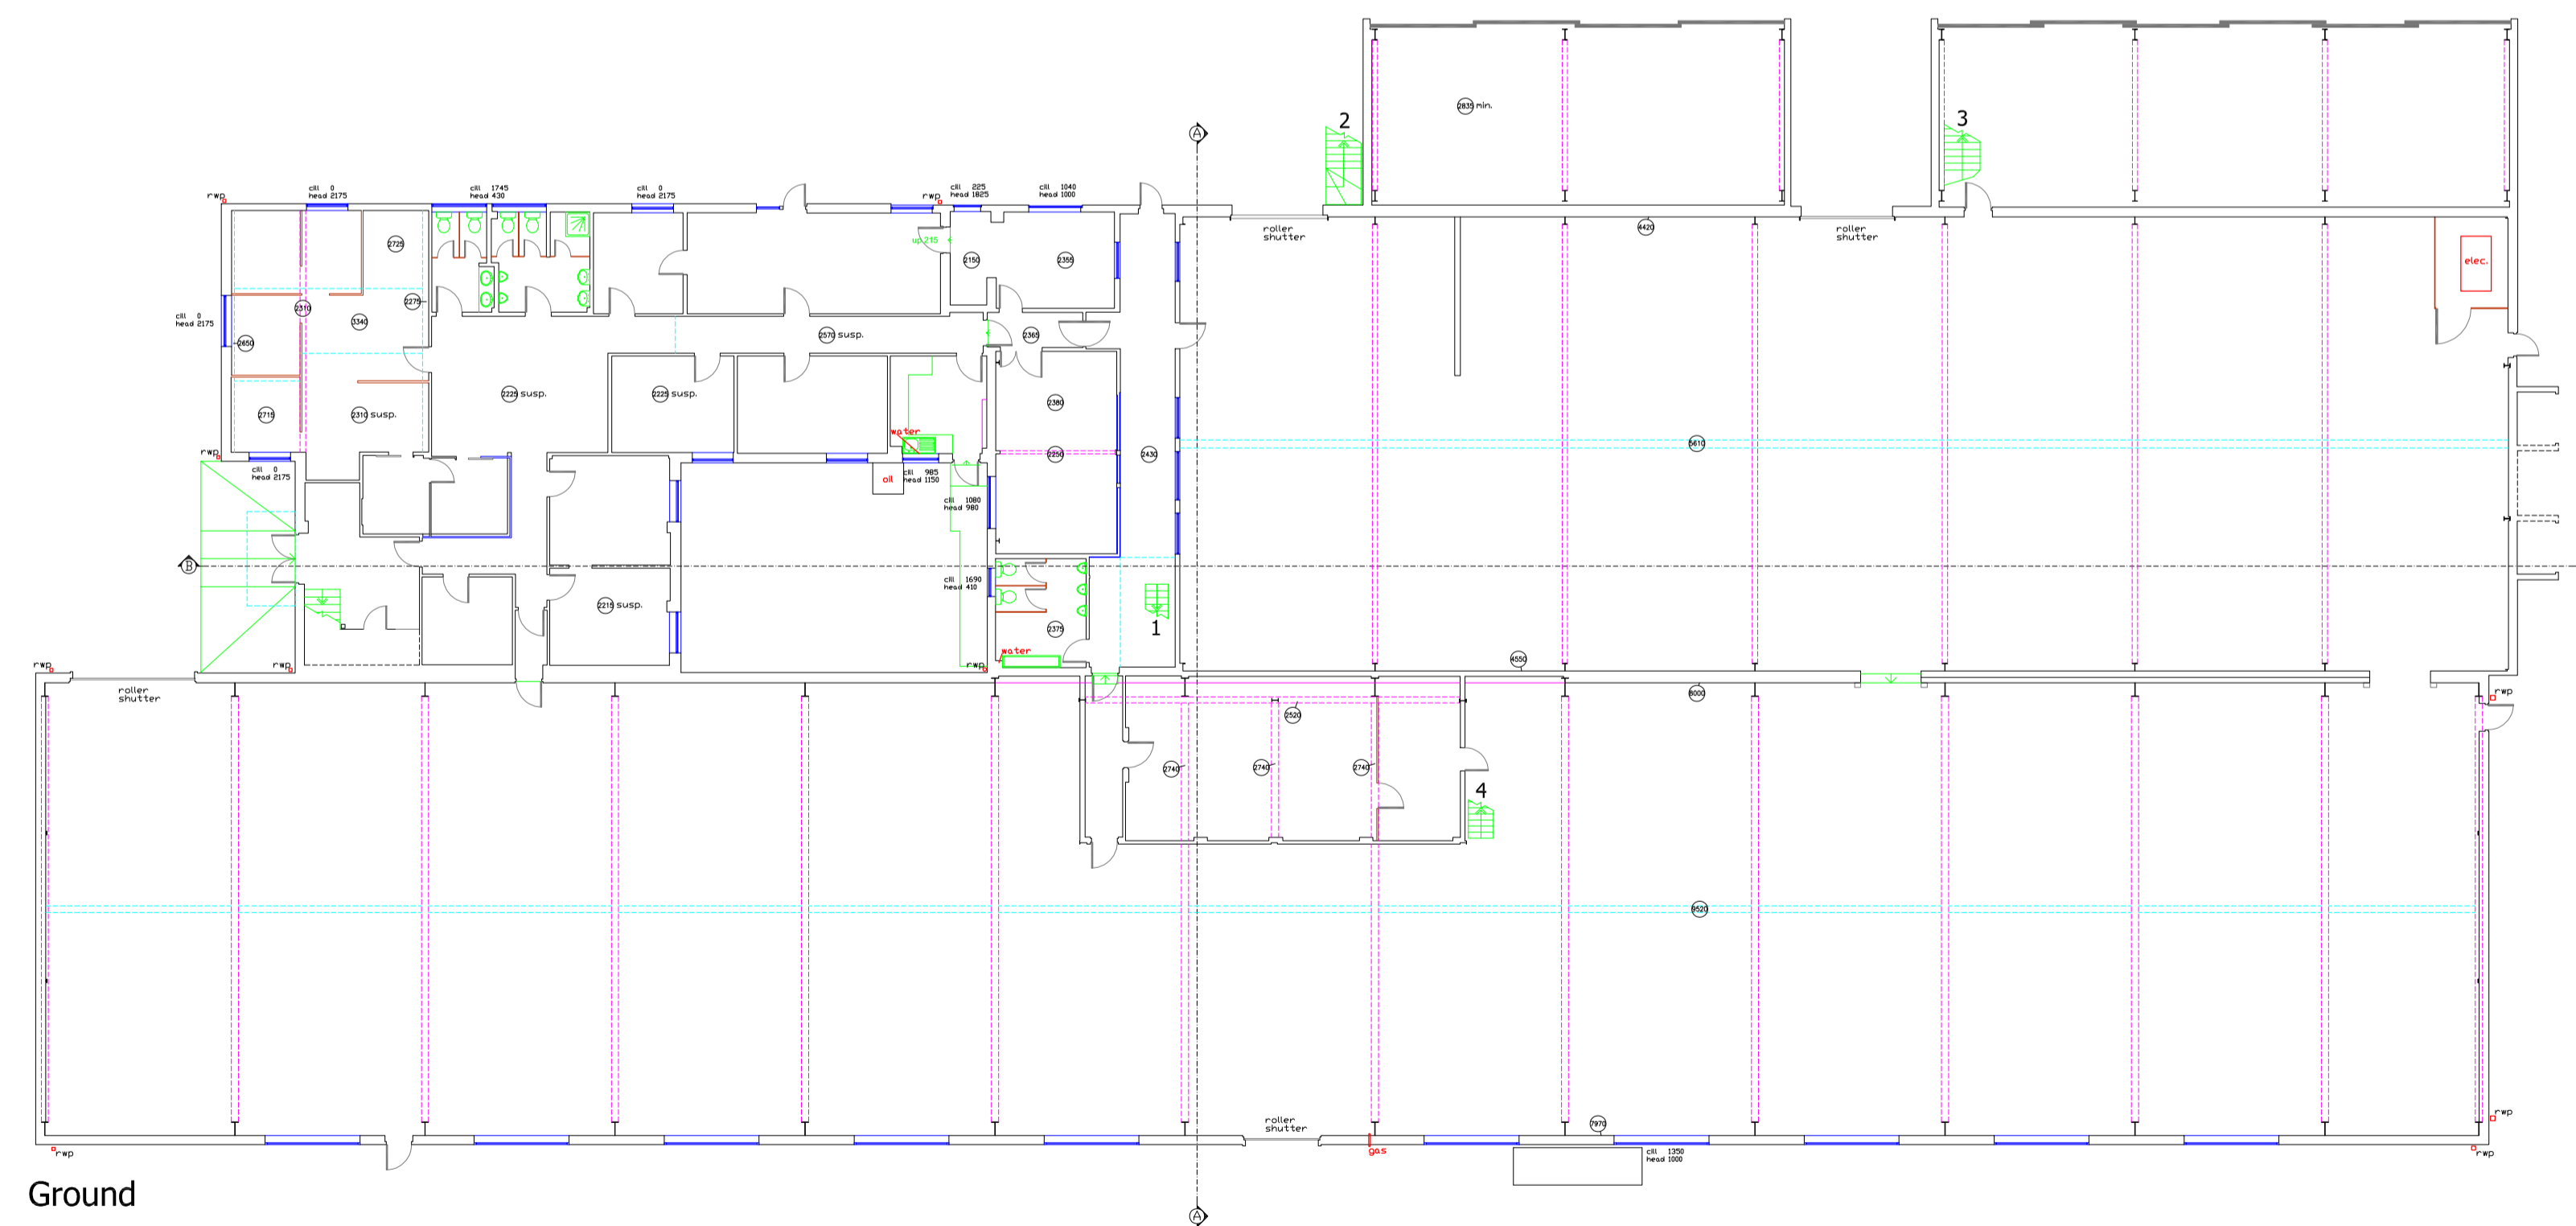


Ground

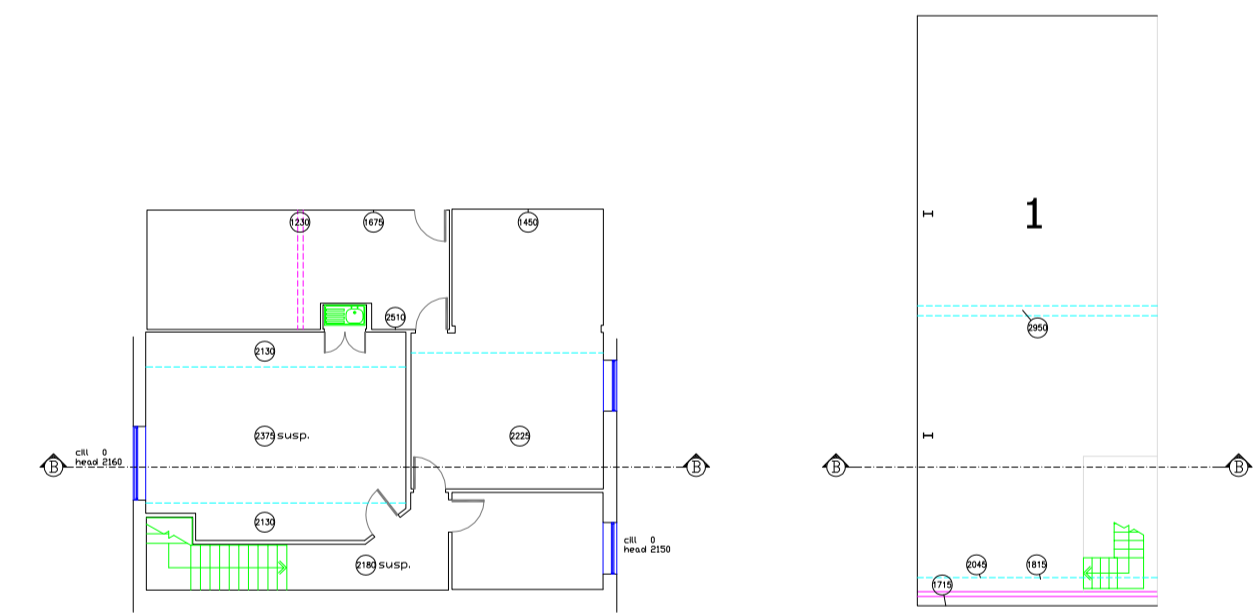


First

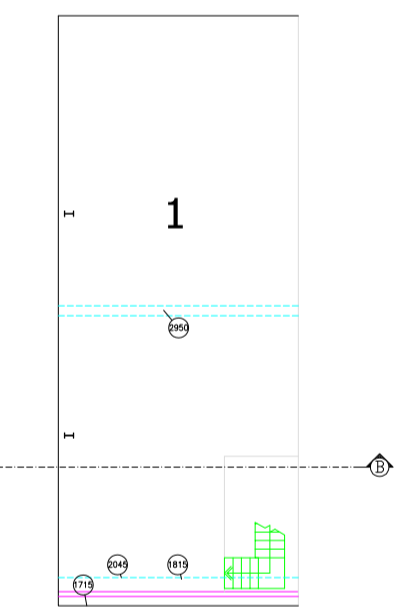


Mezzanine

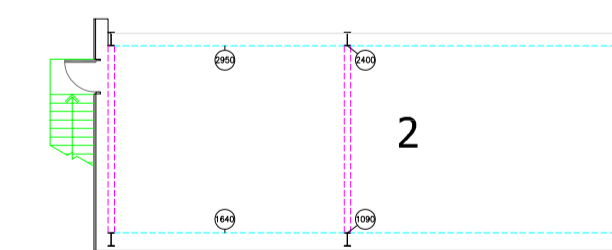

Mezzanine

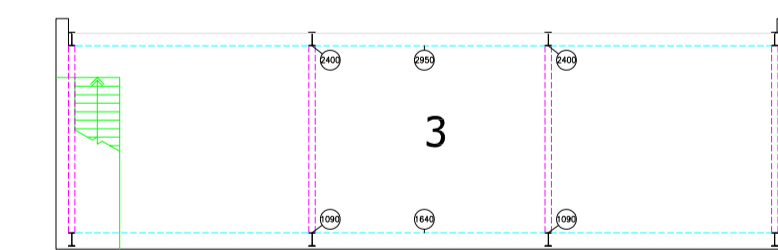

Mezzanine

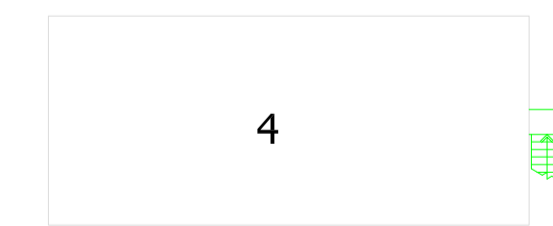

Mezzanine

Project	Title Floor Plans, Elevations & Sections
Gen Two Real Estate	Ref 3479-04D
Building Four	Scale 1:200 on A1
The Way	Date July 2022
Fowlmere	
SG8 7QS	

Notes & Revisions
Rev. A: Revised NIA calculations.

Scale 1:200 on A1
Date July 2022

0 4 8 12 16 20 metres

ALL DIMENSIONS TAKEN TO FACE OF DRY LINING OR WALL CLADDING IF APPLICABLE.

ALTHOUGH EVERY ENDEAVOUR IS MADE TO PROVIDE AN ACCURATE SURVEY DRAWING IT IS RECOMMENDED THAT CRITICAL DIMENSIONS SHOULD BE CHECKED ON SITE. INACCESSIBLE AREAS WILL BE SHOWN USING A BROKEN LINE.

Areas:

Ross Laird
measured surveys
5 Lower King Street
Royston, Herts SG8 5AL
01763 249949
surveys@rosslaird.co.uk
www.rosslaird.co.uk