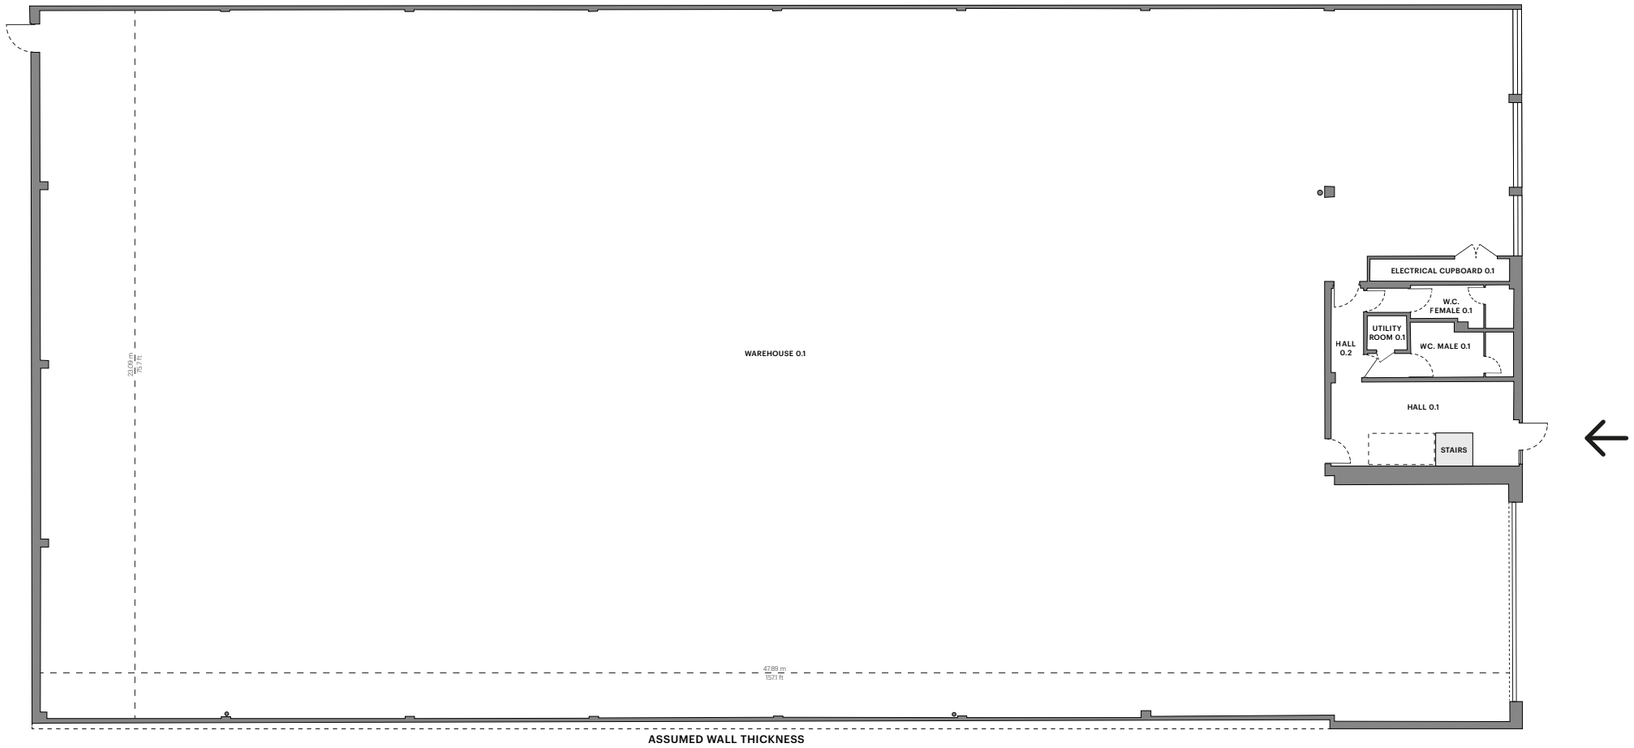


Orientation

Scale

1:200 @ A3

0 2 m 4 m 8 m 12 m 16 m 20 m

Additional Notes

Additional notes not applicable

Notes

This building survey was captured with a BLK360 digital surveying device.
Captured measurements reflect only those areas which our digital surveyors were either instructed or permitted to capture.
All measurements to be verified on site.

Description	Rev.	Date
Digital Survey for Information	0	16/10/2026

Capture Date
12/10/2026

Captured by
Nikolas Raczynski

Production Date
15/10/2026

Produced by
Tumi Chalatse

Stak ID
6ac8f6e58f931d00013edb66

Checked By
Layola Mbula

Building
Unit 6

Address
Skyport Trade Park

Postcode
UB7 0LB

City
Harmondsworth

Revision
0


Drawing Name
Ground Floor

Drawing Number
4065-CAD-00-00-DR-B-0001-S2


Page Size
A3

E. support@stak.co W. www.stak.co
5th Floor One New Change, London, England, EC4M 9AF

Stak® is a trading name of Digital Reality Corp Ltd. This drawing and any files transmitted with it are confidential and intended solely for the use of the individual or entity to whom they are addressed. If you have received this drawing or file in error please notify us immediately. Digital Reality Corp Ltd is registered in England and Wales number 09696838 and VAT number 222755223.
Our registered office is 5th Floor, One New Change, London England EC4M 9AF

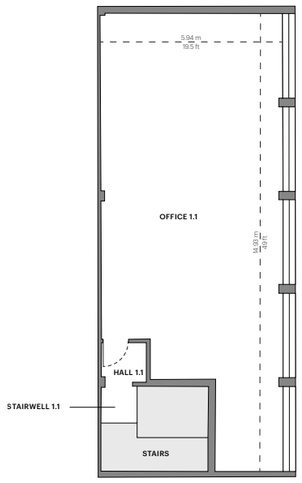

Orientation

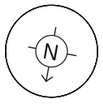

Scale

1:200 @ A3

0 2 m 4 m 8 m 12 m 16 m 20 m

Additional Notes

Additional notes not applicable

Notes

This building survey was captured with a BLK360 digital surveying device.
Captured measurements reflect only those areas which our digital surveyors were either instructed or permitted to capture.
All measurements to be verified on site.

Description	Rev.	Date
Digital Survey for Information	0	16/10/2026

Capture Date
12/10/2026

Captured by
Nikolas Raczynski

Production Date
15/10/2026

Produced by
Tumi Chalatse

Stak ID
6ac8f6e58f931d00013edb66

Checked By
Layola Mbula

Building
Unit 6

Address
Skyport Trade Park

Postcode
UB7 0LB

City
Harmondsworth

Revision
0

Drawing Name
First Floor

Drawing Number
4065-CAD-00-01-DR-B-0001-S2

Page Size
A3

E. support@stak.co W. www.stak.co
5th Floor One New Change, London, England, EC4M 9AF

Stak® is a trading name of Digital Reality Corp Ltd. This drawing and any files transmitted with it are confidential and intended solely for the use of the individual or entity to whom they are addressed. If you have received this drawing or file in error please notify us immediately. Digital Reality Corp Ltd is registered in England and Wales number 09696838 and VAT number 222755223.
Our registered office is 5th Floor, One New Change, London England EC4M 9AF